PLAT OF SURVEY

RSV ENGINEERING, INC ENGINEERING FLANDERI, SURVEYORS ENGINEERS, PLANNERS, SURVEY CONSTRUCTION MANAGERS, ENVIRONMENTAL SCIENTISTS 801 MAIN STREET. MUKWONAGO. WISCONSIN 53149 1414) 363-2004

FOR: NINA HAAS

DATE: 10/14/97

DESCRIPTION: BEING A PARCEL OF LAND LOCATED IN THE E¹/₂ OF THE SE¹/₄ OF SECTION 8. TOWN 3 NORTH, RANGE 16 EAST, TOWN OF SUGAR CREEK, WALWORTH COUNTY, WISCONSIN BEING MORE COMPLETELY DESCRIBED AS FOLLOWS: COMMENCING AT THE CENTER OF SECTION 8: THENCE WITH THE NORTH LINE OF THE SE¹/₄ OF SAID SECTION ALSO BEING THE CENTERLINE OF HWY "A' EAST, A DISTANCE OF 1584.90' TO A POINT; THENCE SOUTH, A DISTANCE OF 33.00' TO THE POINT OF BEGINNING ALSO BEING A POINT ON THE SOUTHERLY RIGHT OF WAY OF HWY "A"; THENCE WITH THE SAID RIGHT OF WAY EAST, A DISTANCE OF 258.10' TO A POINT; THENCE SOUTH, A DISTANCE OF 155.00' TO A POINT; THENCE WEST, A DISTANCE OF 258.10' TO A POINT; THENCE NORTH, A DISTANCE OF 155.00' TO THE POINT OF BEGINNING. SAID PARCEL CONTAINING 0.92 ACRES MORE OR LESS.


LEGEND

• FOUND IRON PIPE Ø SET IRON PIPE

> BASIS OF BEARING-THE NORTH LINE OF THE SE¹/₄ WAS TAKEN TO BEAR DUE EAST.

CONC. MONUMENT LOCATED AT THE CENTER OF SEC. 8-3-16

SCALE 1"= 50'

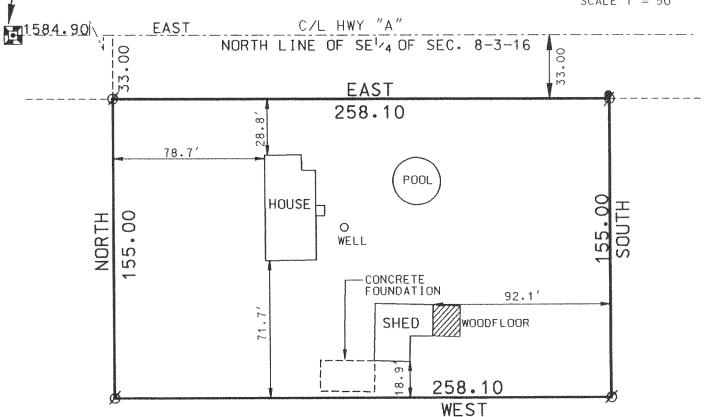

CEIV E 3 1998 BRADFORD L
SPENCER
S-2069
WONAGO

THE ABOVE MAP IS A TRUE REPRESENTATION THEREOF AND SHOWS THE SIZE AND LOCATION OF ALL THE PROPERTY, EXTERIOR BOUNDARIES, THE LOCATION OF ALL VISIBLE BOUNDARY FENCES, APPARENT EASEMENTS, ROADWAYS AND VISIBLE ENCROACHMENTS, IF ANY.

THIS SURVEY IS MADE FOR THE USE OF THE PRESENT OWNERS OF THE PROPERTY, AND ALSO THOSE WHO PURCHASE, MORTGAGE OR GUARANTEE TITLE THERETO IS ORIGINAL WITHIN ONE FROM DATE HERETO. PRINT ONLY IF

MUKWONA WIS. SURVENI SEAL IS IMPRINTED

IN RED

BRADFORD LA SPENCER, R.L.S. 2069 RSV# 97349.DGN