



59-84
316-216

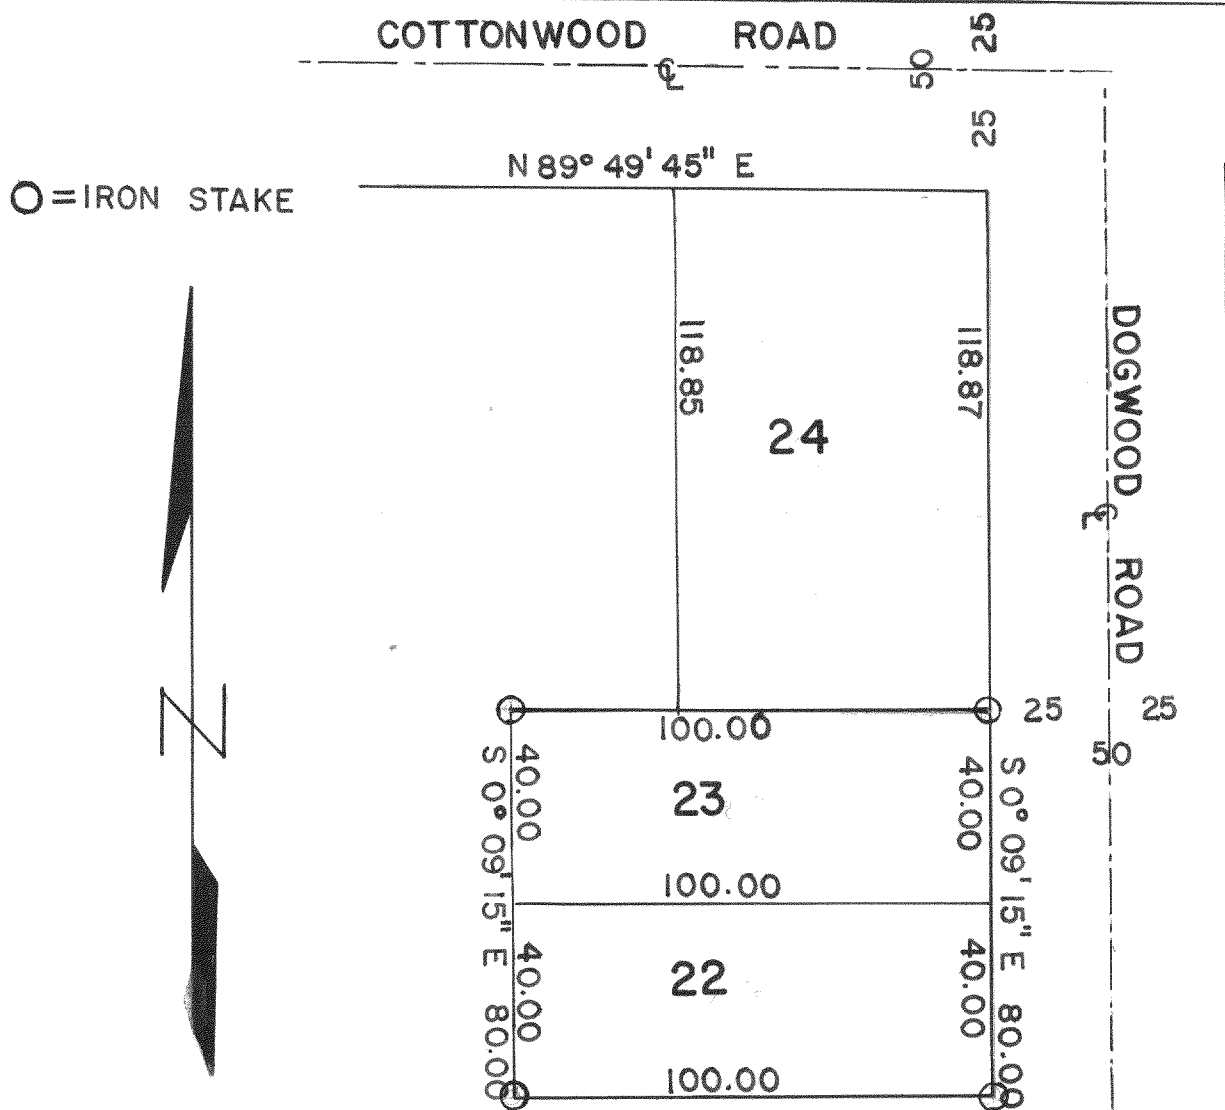

DESCRIPTION: Lots 22-23 Block 41 of Interlaken Subdivision, located in Section 11 T 3 N, R 16 E, Walworth County, Wisconsin.

CERTIFICATE: I, James F. Biagi, Surveyor do hereby certify that I have surveyed the above described property on this the 21st day of October, 1959.

SIGNED AND SEALED THIS 22ND DAY OF OCTOBER, 1959

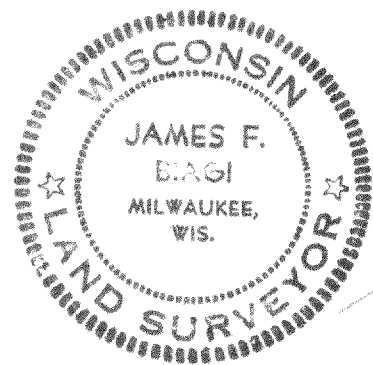

James F. Biagi
James F. Biagi Surveyor

GI - 366

316-216