


COOPER SURVEYING SERVICES
Rural - Residential - Commercial

DANIEL D. COOPER
Registered Land Surveyor

Route 3, Box 255 :: Elkhorn, Wisconsin 53121
Phone (414) 723-6265


SURVEYING & PLANNING
SUBDIVISIONS - LOT SURVEYS
CONSTRUCTION STAKING - MAPPING

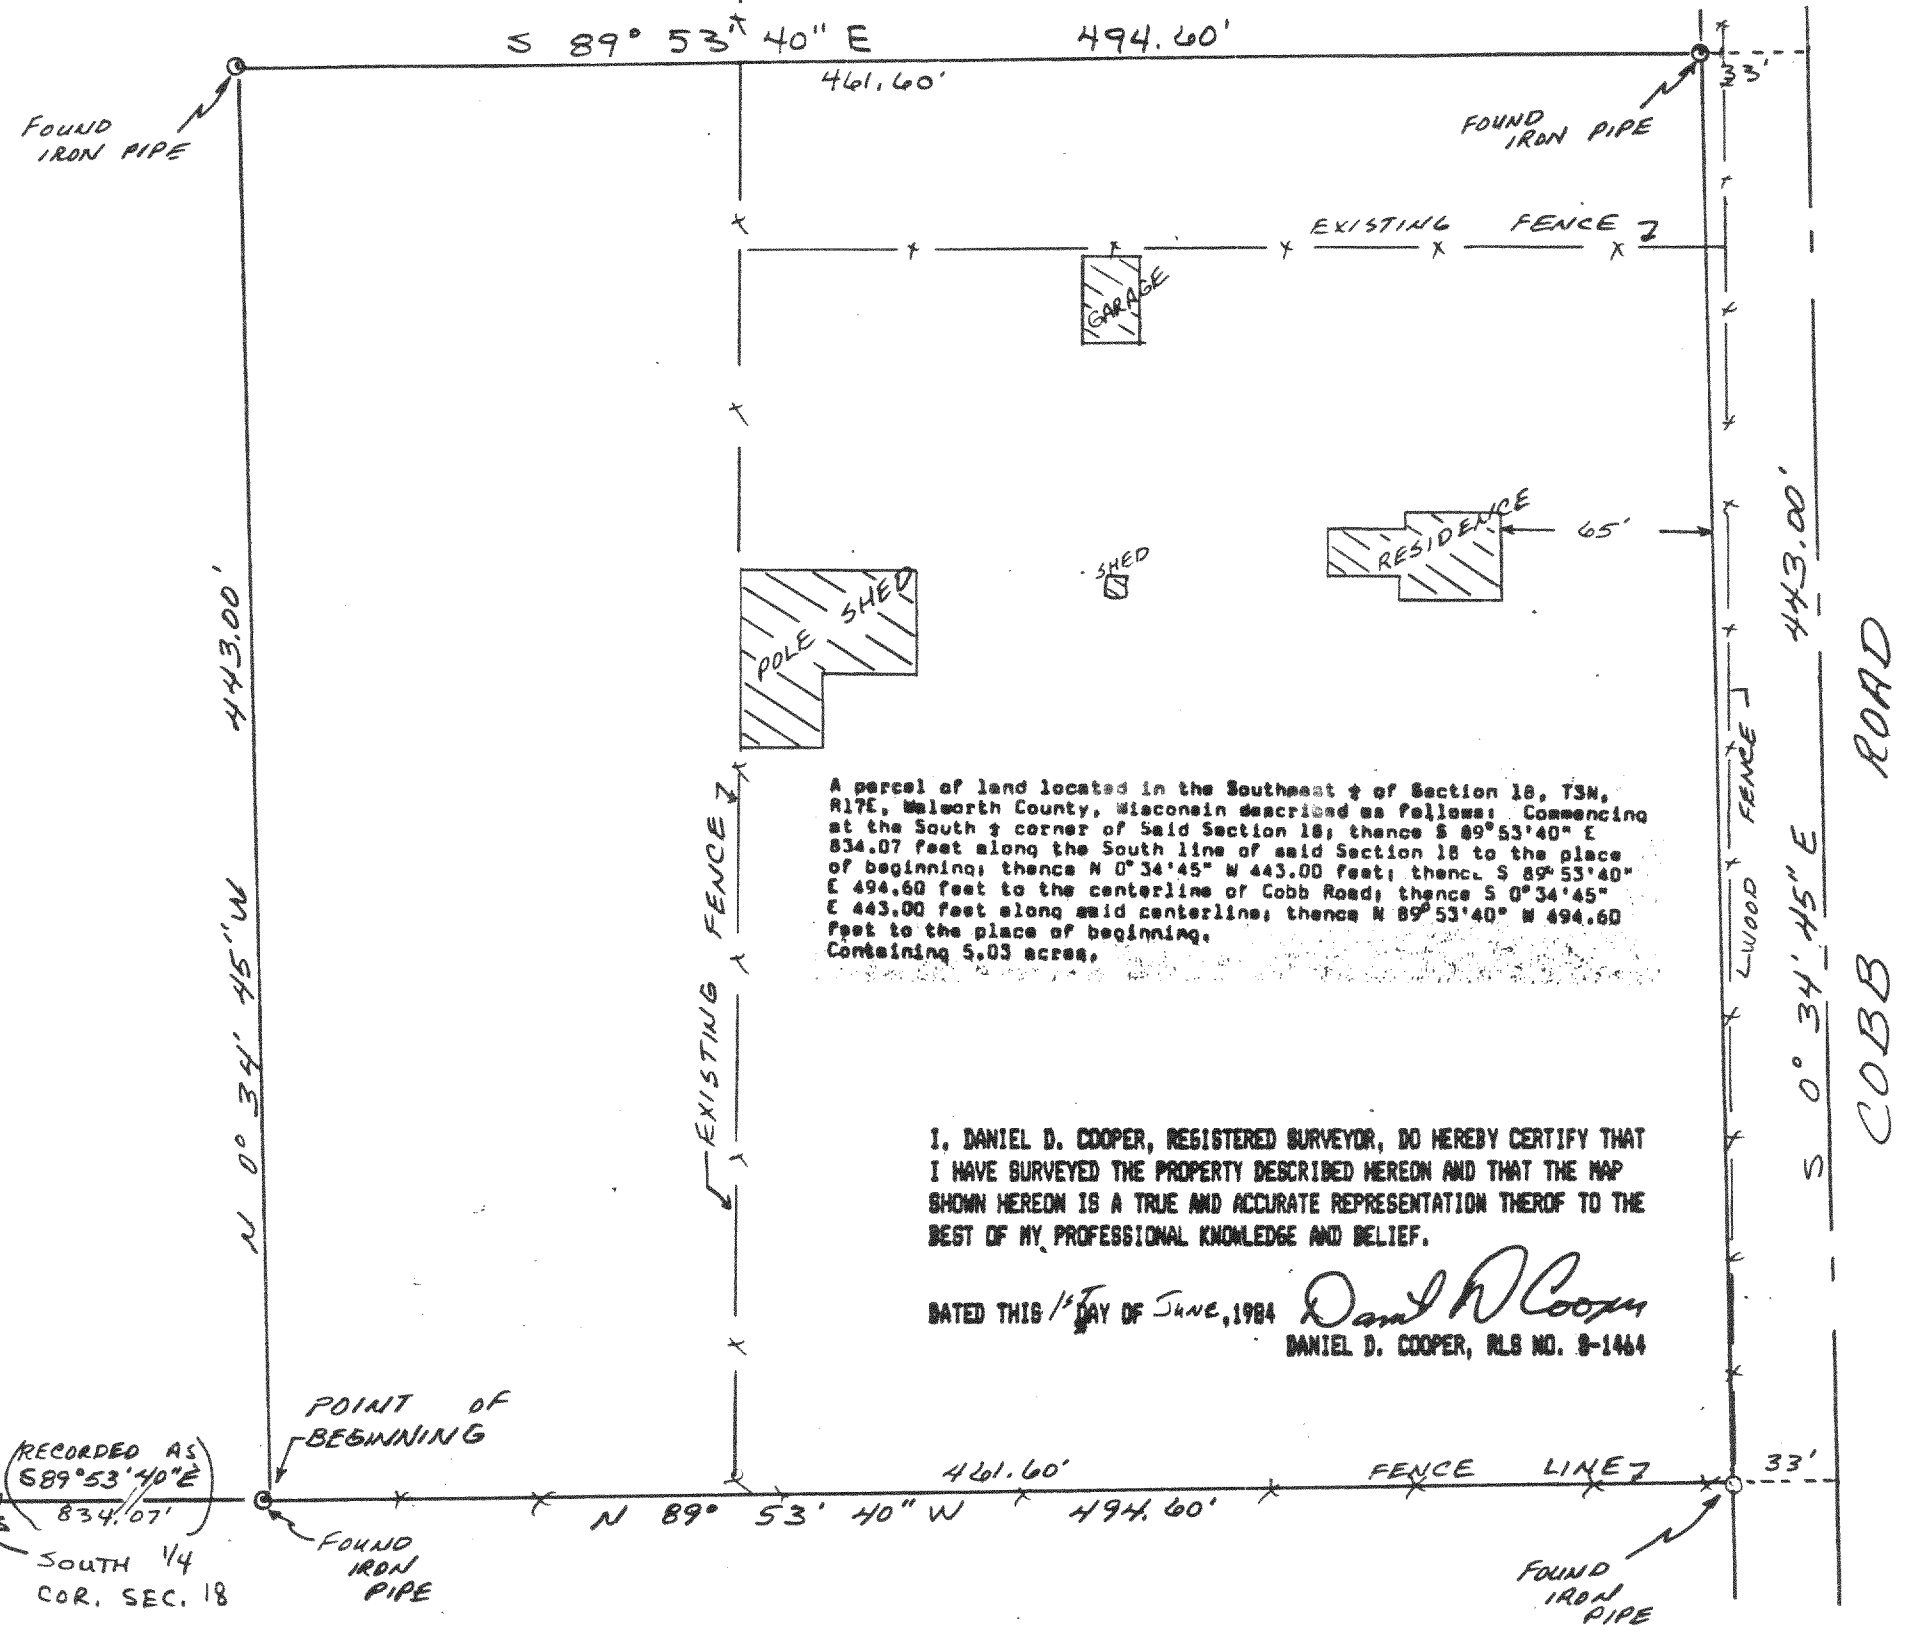

A parcel of land located in the Southwest 1/4 of Section 18, T3N, R17E, Walworth County, Wisconsin described as follows: Commencing at the South 1/4 corner of said Section 18; thence S 89° 53' 40" E 834.07 feet along the South line of said Section 18 to the place of beginning; thence N 0° 34' 45" W 443.00 feet; thence S 89° 53' 40" E 494.60 feet to the centerline of Cobb Road; thence S 0° 34' 45" E 443.00 feet along said centerline; thence N 89° 53' 40" W 494.60 feet to the place of beginning. Containing 5.03 acres.

I, DANIEL D. COOPER, REGISTERED SURVEYOR, DO HEREBY CERTIFY THAT I HAVE SURVEYED THE PROPERTY DESCRIBED HEREON AND THAT THE MAP SHOWN HEREON IS A TRUE AND ACCURATE REPRESENTATION THEREOF TO THE BEST OF MY PROFESSIONAL KNOWLEDGE AND BELIEF.

DATED THIS 1ST DAY OF JUNE, 1984 *Daniel D. Cooper*
DANIEL D. COOPER, RLS NO. 9-1464

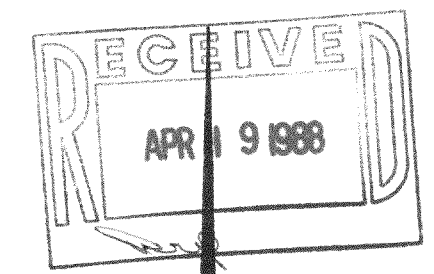

SCALE 1" = 60'

BEARING REFERENCE: EAST
LINE ASSUMED TO BEAL
S 0° 34' 45" E AS PLATTED



2LF18-46




D.D. COOPER & CO.
INC.

ROUTE 4, BOX 308 B
ELKHORN, WI 53121


PH 414-723-6265

SURVEYING • MODULAR HOMES

LONGMEADOW DRIVE

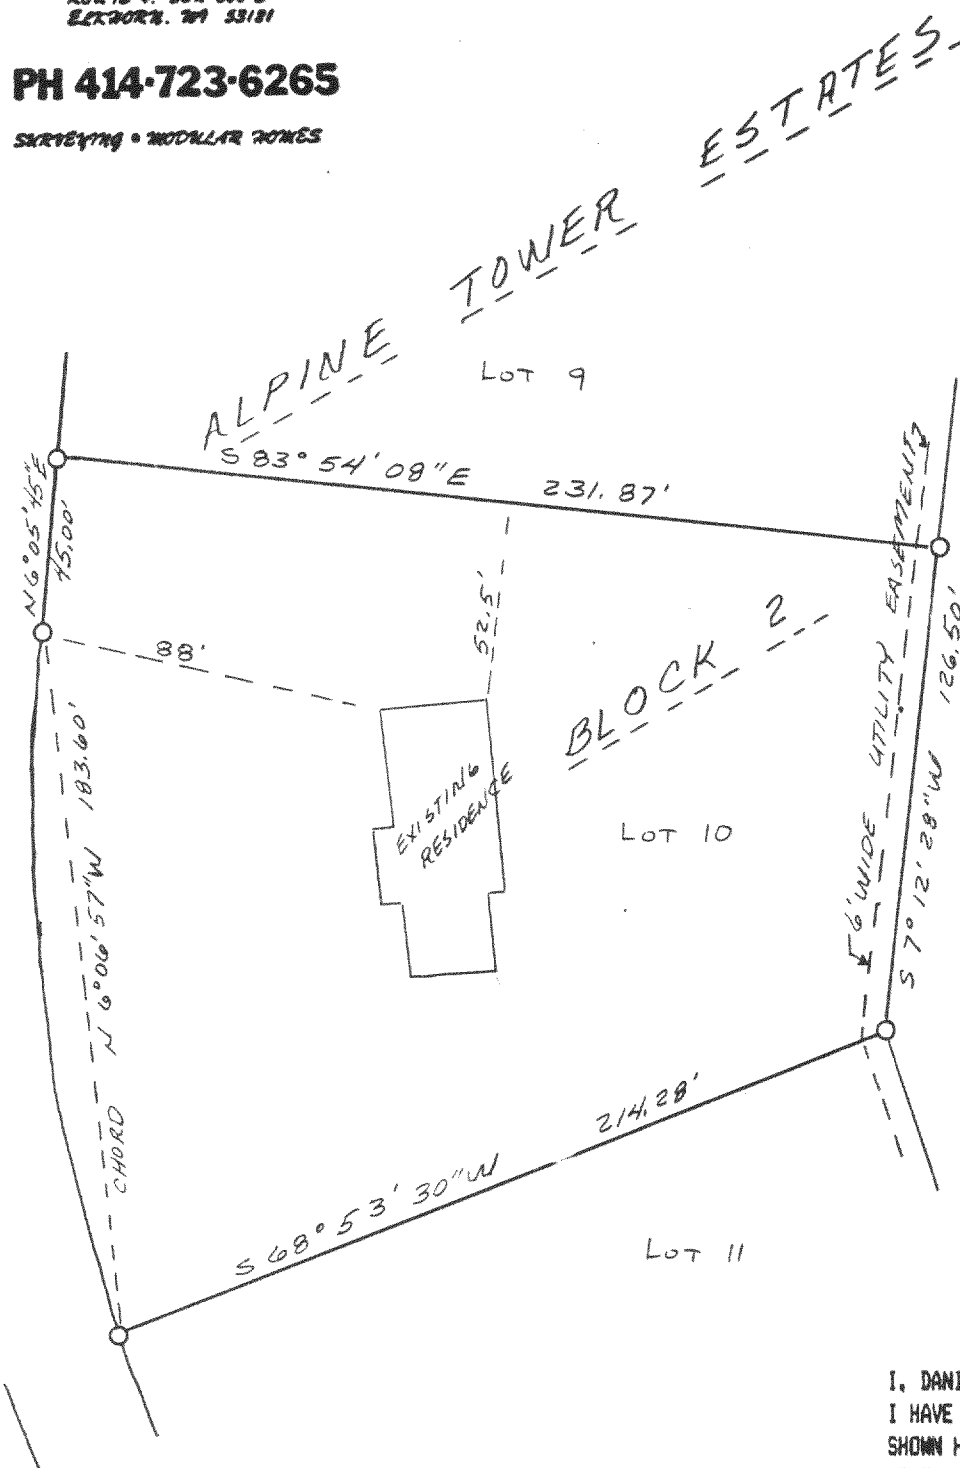

PLAT OF SURVEY OF LOT 10 BLOCK 2 ALPINE TOWER ESTATES BEING LOCATED
IN TOWN 3 NORTH RANGE 17 EAST TOWN OF LAFAYETTE WALWORTH COUNTY WISCONSIN

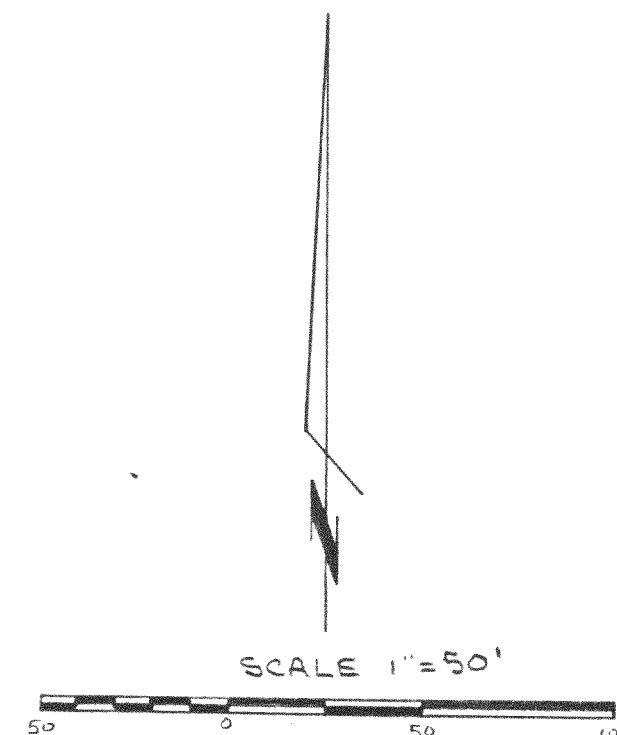


SURVEYED FOR RAMANI REALTY

BEARING REFERENCE
SOUTHERLY LINE OF PARCEL ASSUMED TO BEAR S 68° 53' 30" W

I, DANIEL D. COOPER, REGISTERED SURVEYOR, DO HEREBY CERTIFY THAT
I HAVE SURVEYED THE PROPERTY DESCRIBED HEREON AND THAT THE MAP
SHOWN HEREON IS A TRUE AND ACCURATE REPRESENTATION THEREOF TO THE
BEST OF MY PROFESSIONAL KNOWLEDGE AND BELIEF.

DATED THIS 18 DAY OF Sept, 1984

Daniel D. Cooper
DANIEL D. COOPER, RLS NO. S-1464

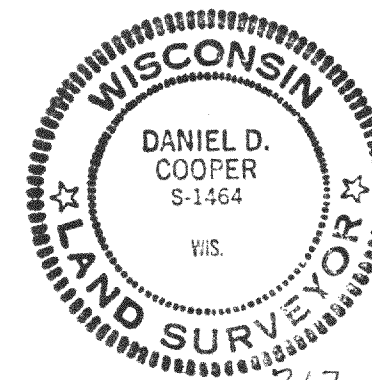

317-114

DRAWING NO. 1967