


D. D. COOPER & CO., INC.
Daniel D. Cooper
Rt. 4 Box 508B
Elkhorn, WI. 53121



Plat of Survey of Lot 58 of Evergreen Estates
Subdivision, T3N, R17E, Walworth County, Wisconsin

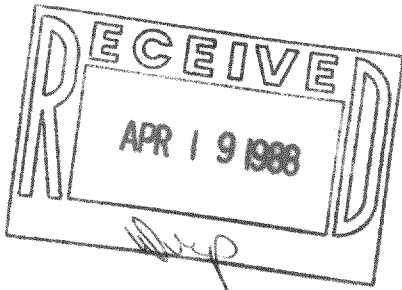

Bearings referenced to the Southerly line of said lot
which was assumed to bear N79°19'35"E

Survey ordered by Century-21 Elkhorn

SCALE 1" = 50'
(RECORDED BEARINGS)

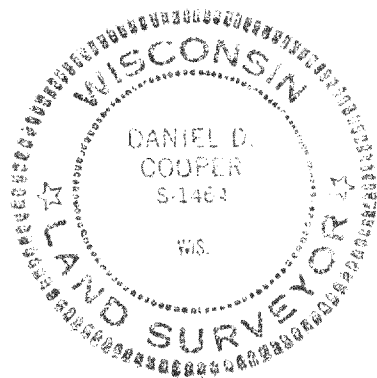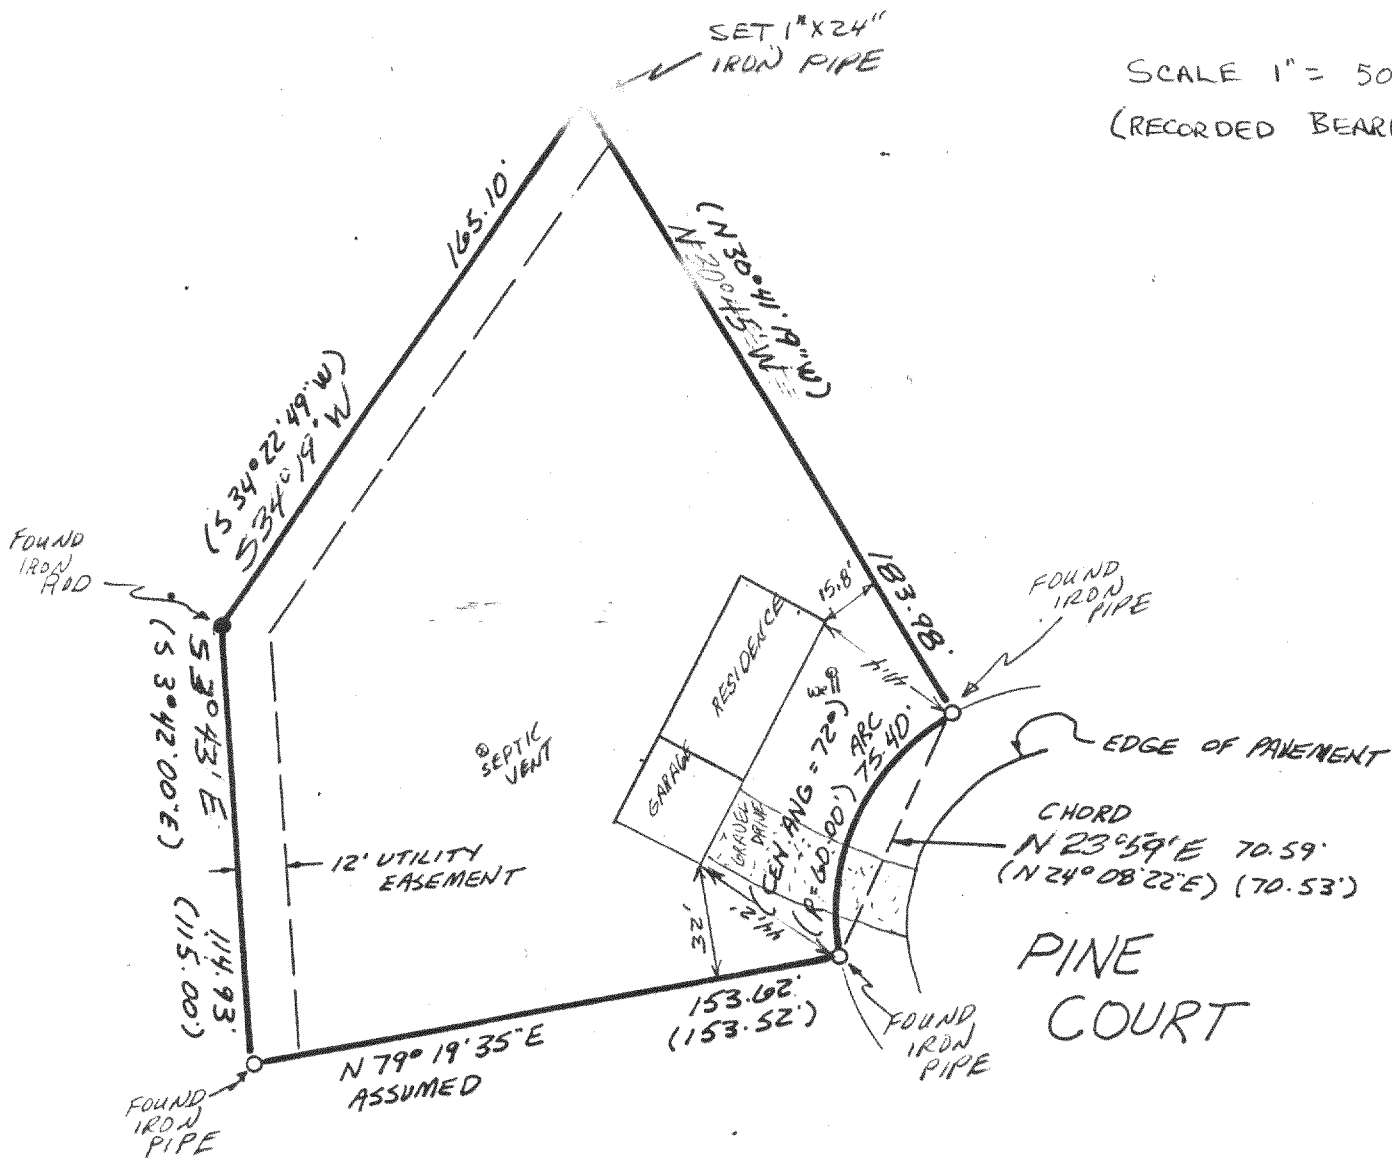

I hereby certify that I have surveyed the property
described hereon and that the above map is a true
and accurate representation thereof to the best of
my professional knowledge and belief.

Dated this 29 day of April, 1987

Daniel D. Cooper

Daniel D. Cooper RLS No. S-1464