

D. Cooper & CO., INC
Rt 4 Box 5088 * Elkhorn WI 53121


PLAT OF SURVEY OF LOT 80 OF EVERGREEN ESTATES,
LOCATED IN T3N, R17E, WALWORTH COUNTY, WISCONSIN.

Survey ordered by Schulz Realty- Elkhorn

Scale 1" = 30'

LOT 81

LOT 79

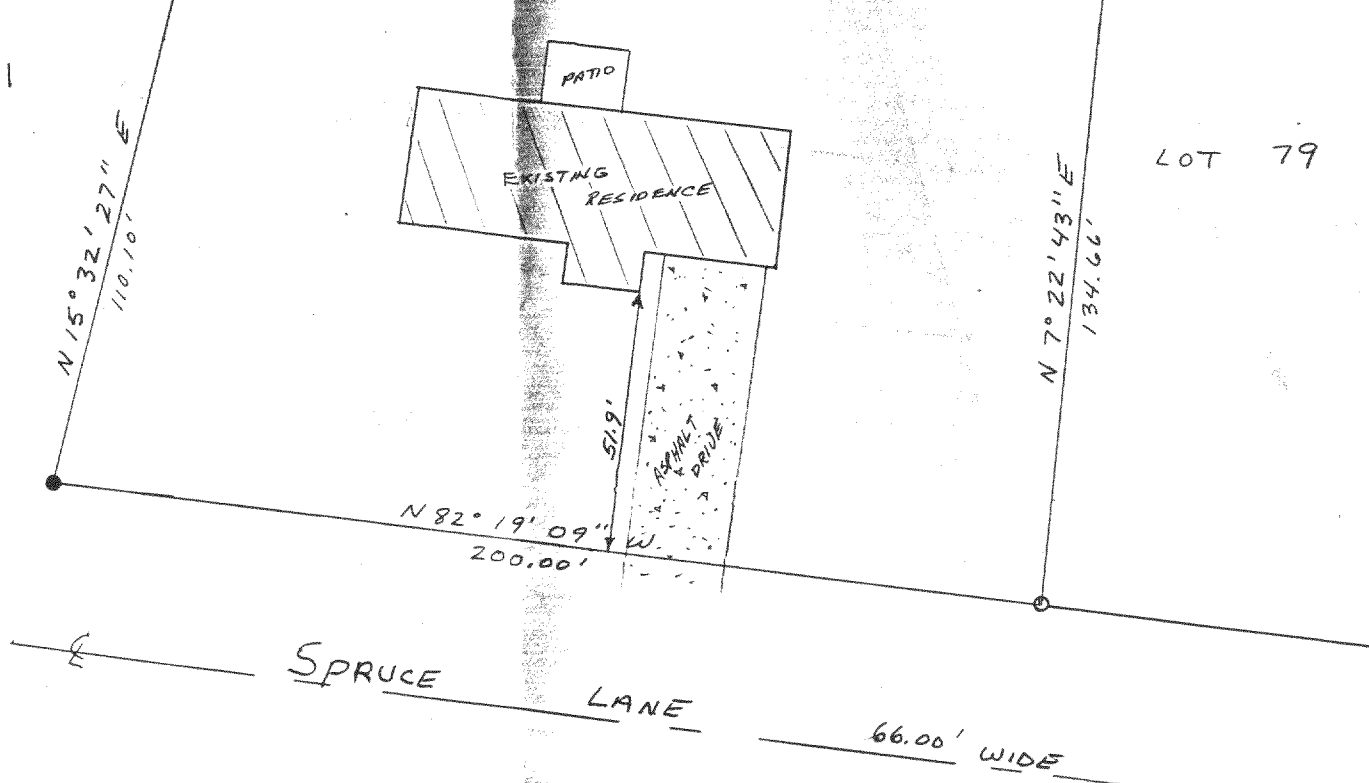

I hereby certify that I have surveyed the
property described hereon and that the
map shown hereon is a true and accurate
representation thereof to the best of my
professional knowledge and belief.

Dated this 4th day of Oct., 1989


Daniel D. Cooper
Daniel D. Cooper, RLS No. S-1464

Bearing Reference: Northerly line of lot assumed to
bear S 89° 46' 30" W.

Legend:

- - found iron pipe
- - found iron bar
- / — - set 3/4"x24" iron rod

DRAWING NO. 3531

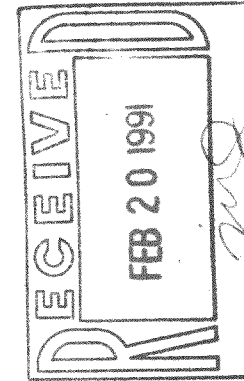

Reduced

TAX KEY #

KE 00080

317 - 200
199