


CURVE	DELTA ANGLE	RADIUS	ARC	TANGENT	CHORD	CHORD BEARING
C 1	07° 53' 47"	188.66'	26.00'	13.02'	25.98'	N 78° 22' 18" W



SPRUCE LANE

Survey ordered by Century 21- Elkhorn

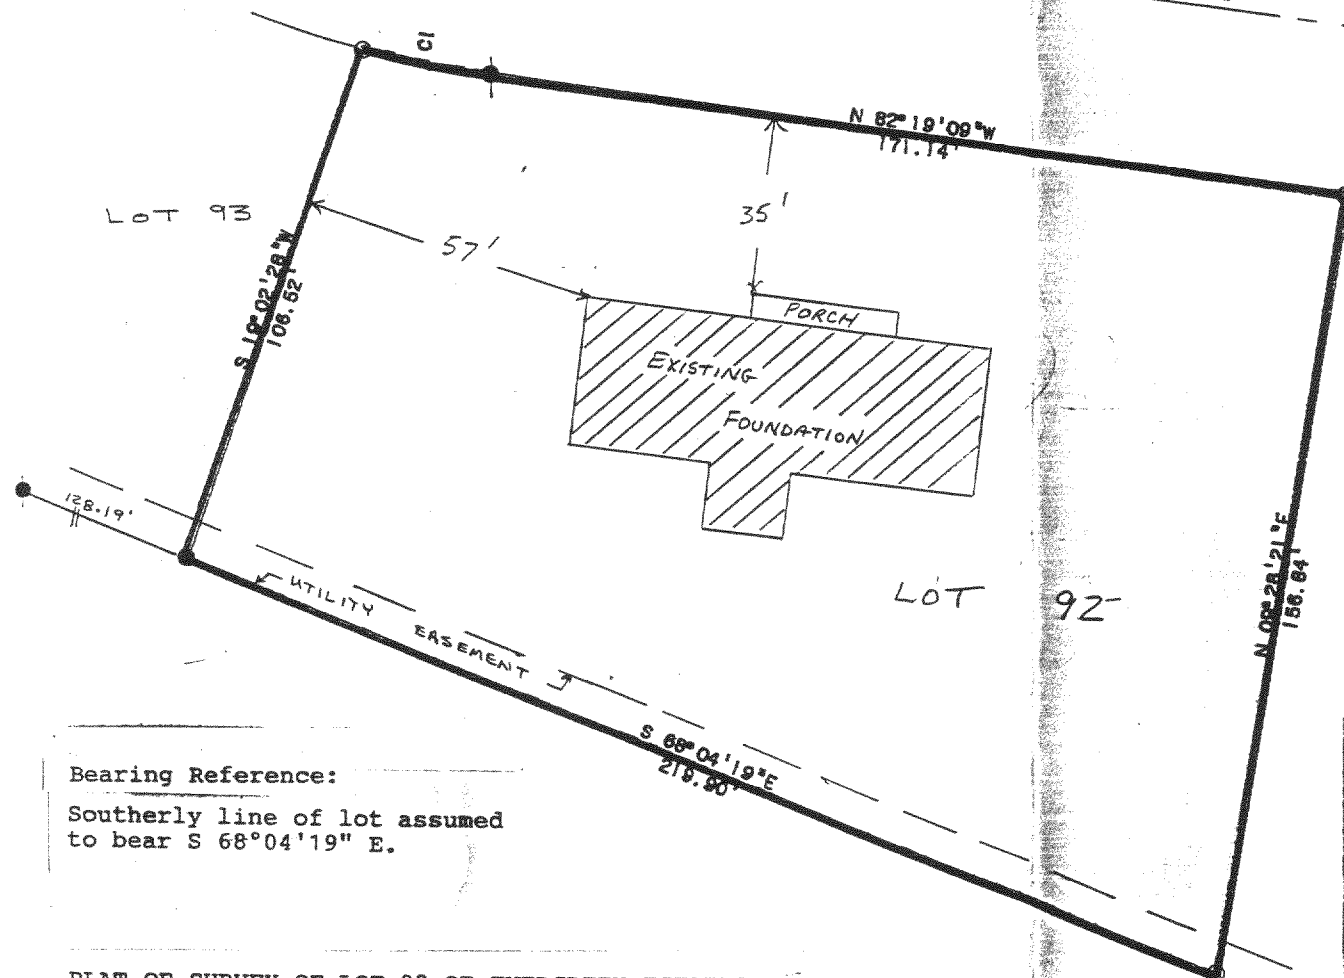

Bearing Reference:
Southerly line of lot assumed
to bear S 68° 04' 19" E.

PLAT OF SURVEY OF LOT 92 OF EVERGREEN ESTATES,
LOCATED IN T3N, R17E, WALWORTH COUNTY, WISCONSIN.

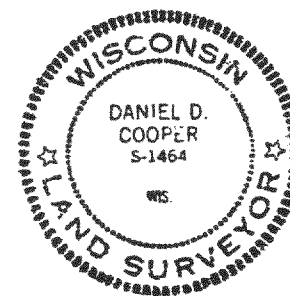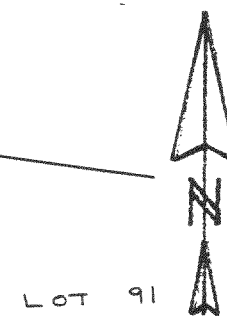

SCALE 1" = 30'

- FOUND IRON PIPE
- FOUND IRON BAR
- SET 3/4" X 24" IRON ROD

I hereby certify that I have surveyed the
property described hereon and that the
map shown hereon is a true and accurate
representation thereof to the best of my
professional knowledge and belief.


Dated this 4th day of Oct, 1989

Daniel D. Cooper
Daniel D. Cooper, RLS No. S-1464

REVISED APRIL 10, 1990 TO SHOW
EXISTING FOUNDATION.

DRAWING No. 3523

Reduced

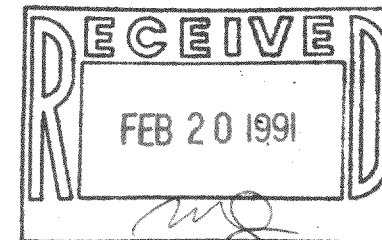

TAX KEY # KE 00092

317-201