


PLAT OF SURVEY

Survey No. 79923

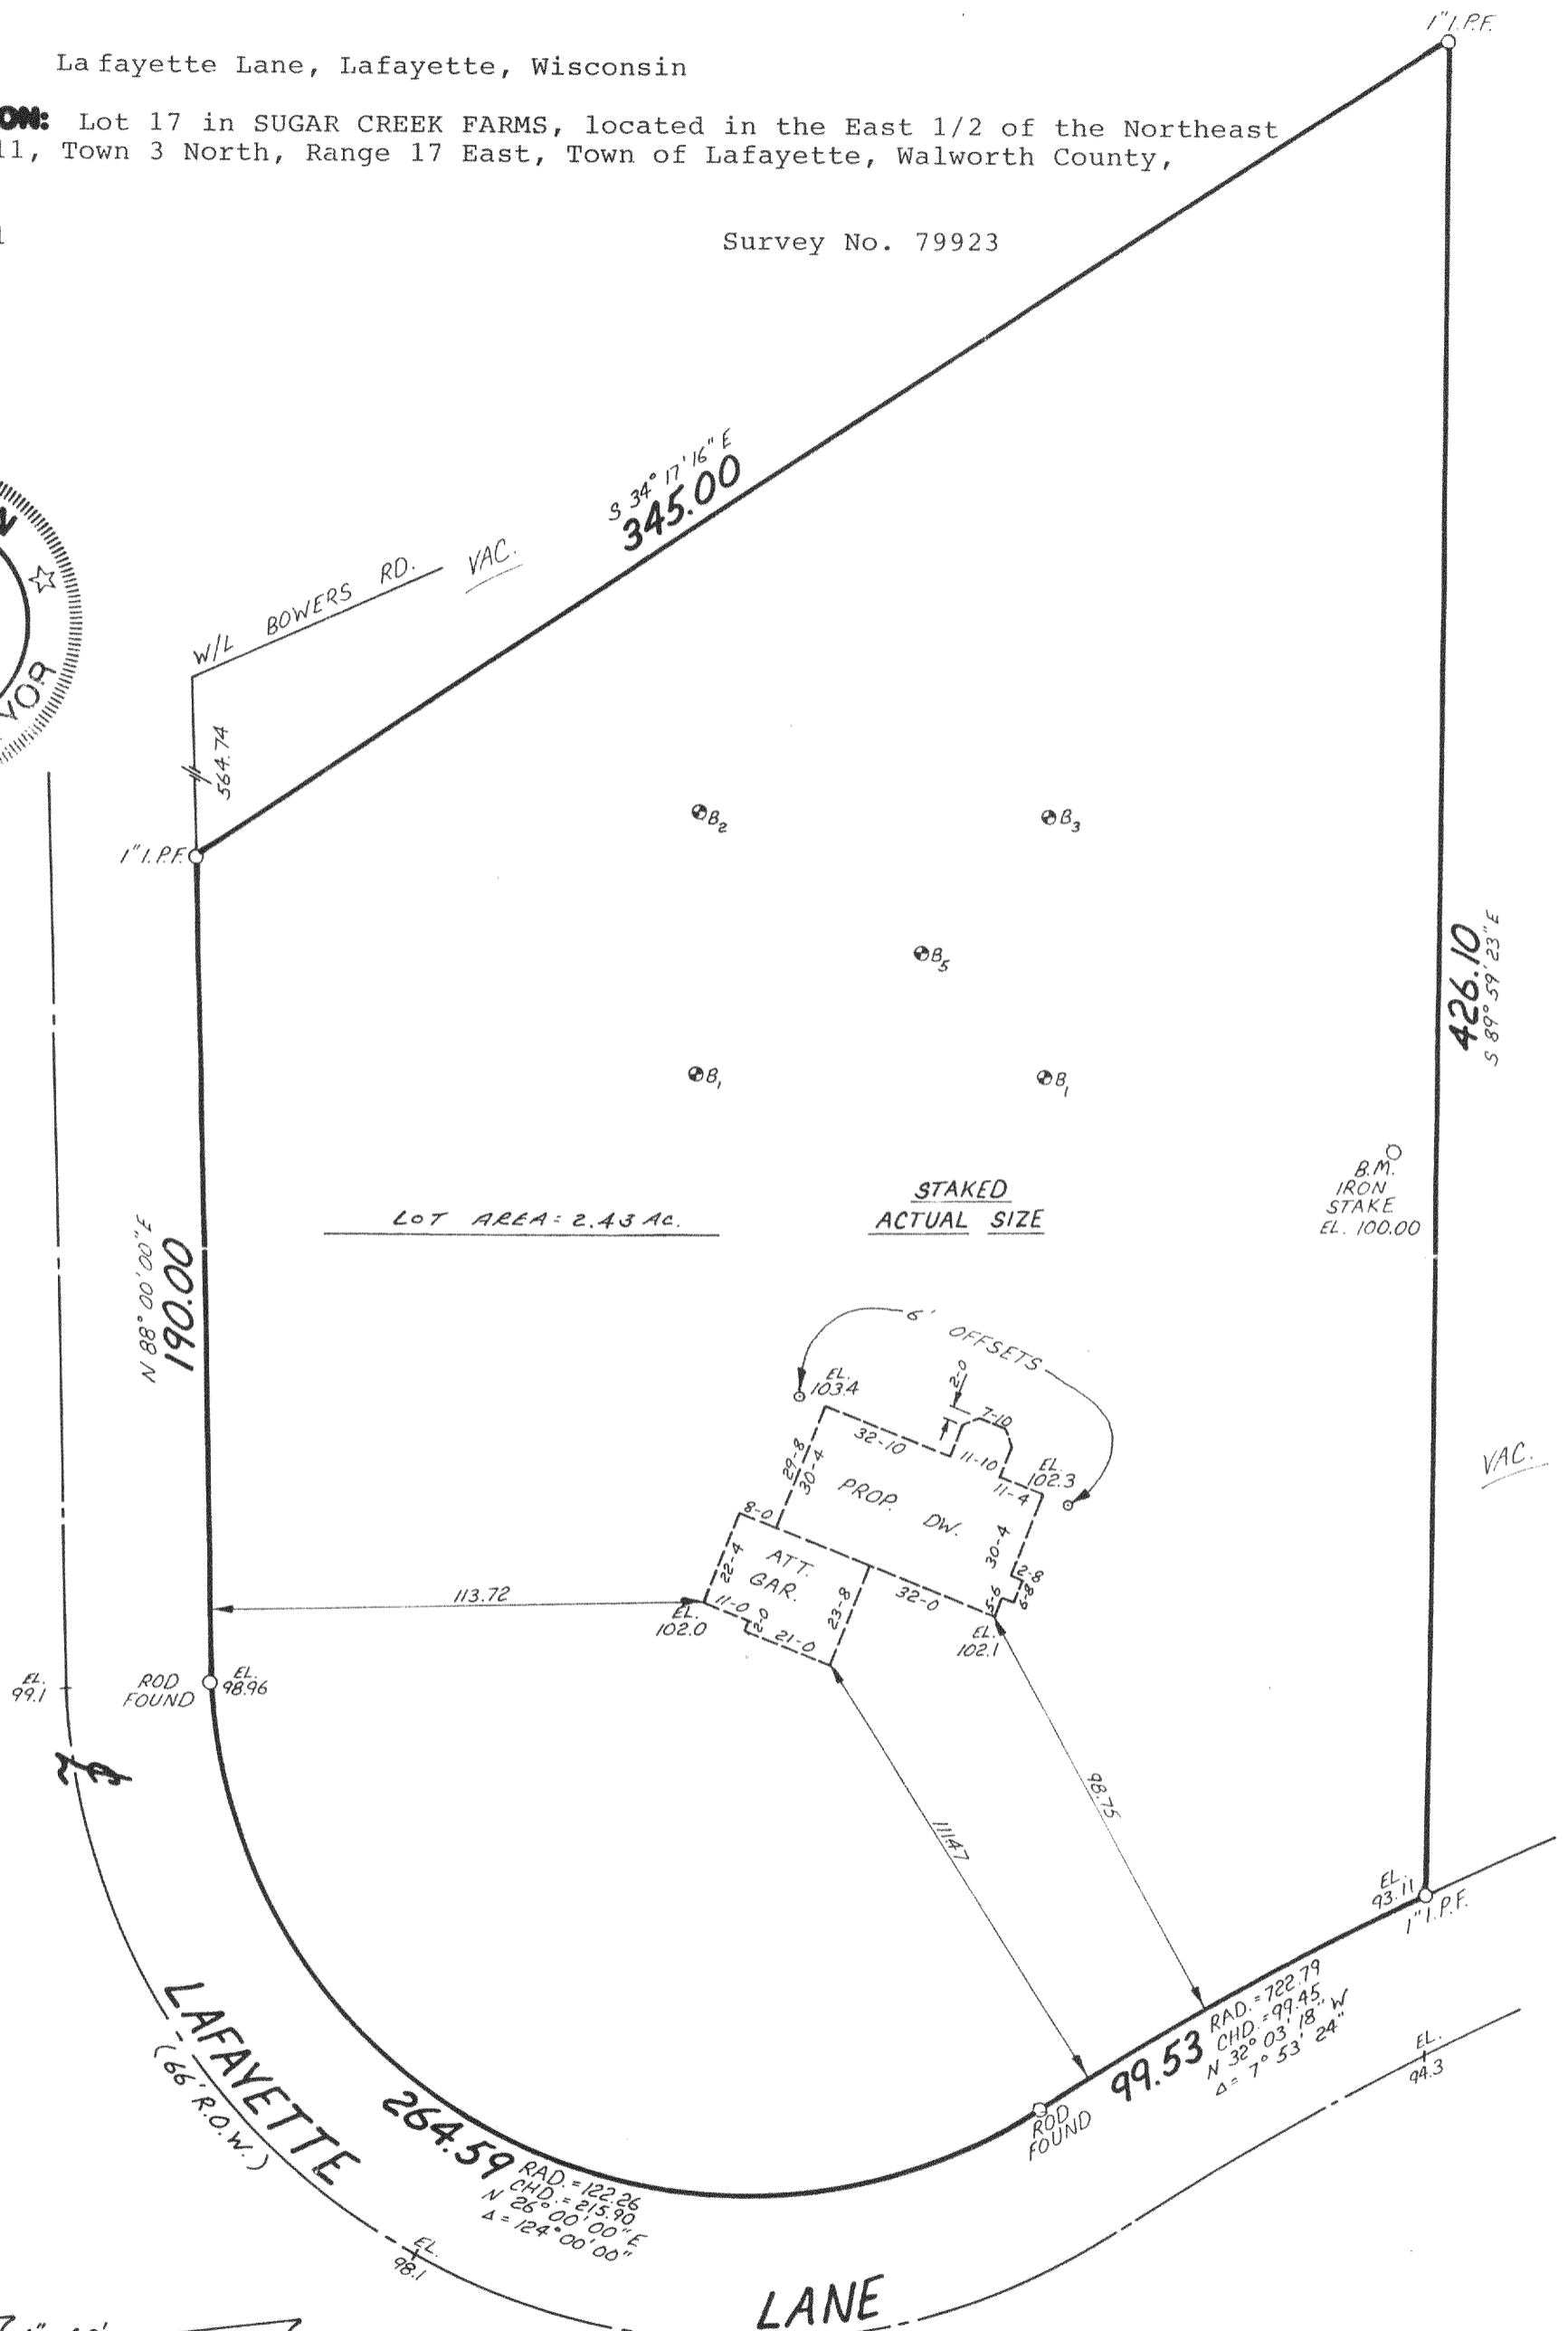

SIGNED

317-236

KS 00017