


FARRIS, HANSEN & ASSOCIATES, INC.

ENGINEERING, ARCHITECTURE, SURVEYING
7 RIDGEWAY COURT - P.O. BOX 437, ELKHORN, WISCONSIN, 53121
PHONE: (414) 723-2098 FAX: (414) 723-5886

PLAT OF SURVEY

LOT 2 OF CERTIFIED SURVEY MAP NO. 514

LOCATED IN THE NW 1/4 OF SEC. 19, T. 3 N., R. 17 E.
WALWORTH COUNTY, WISCONSIN

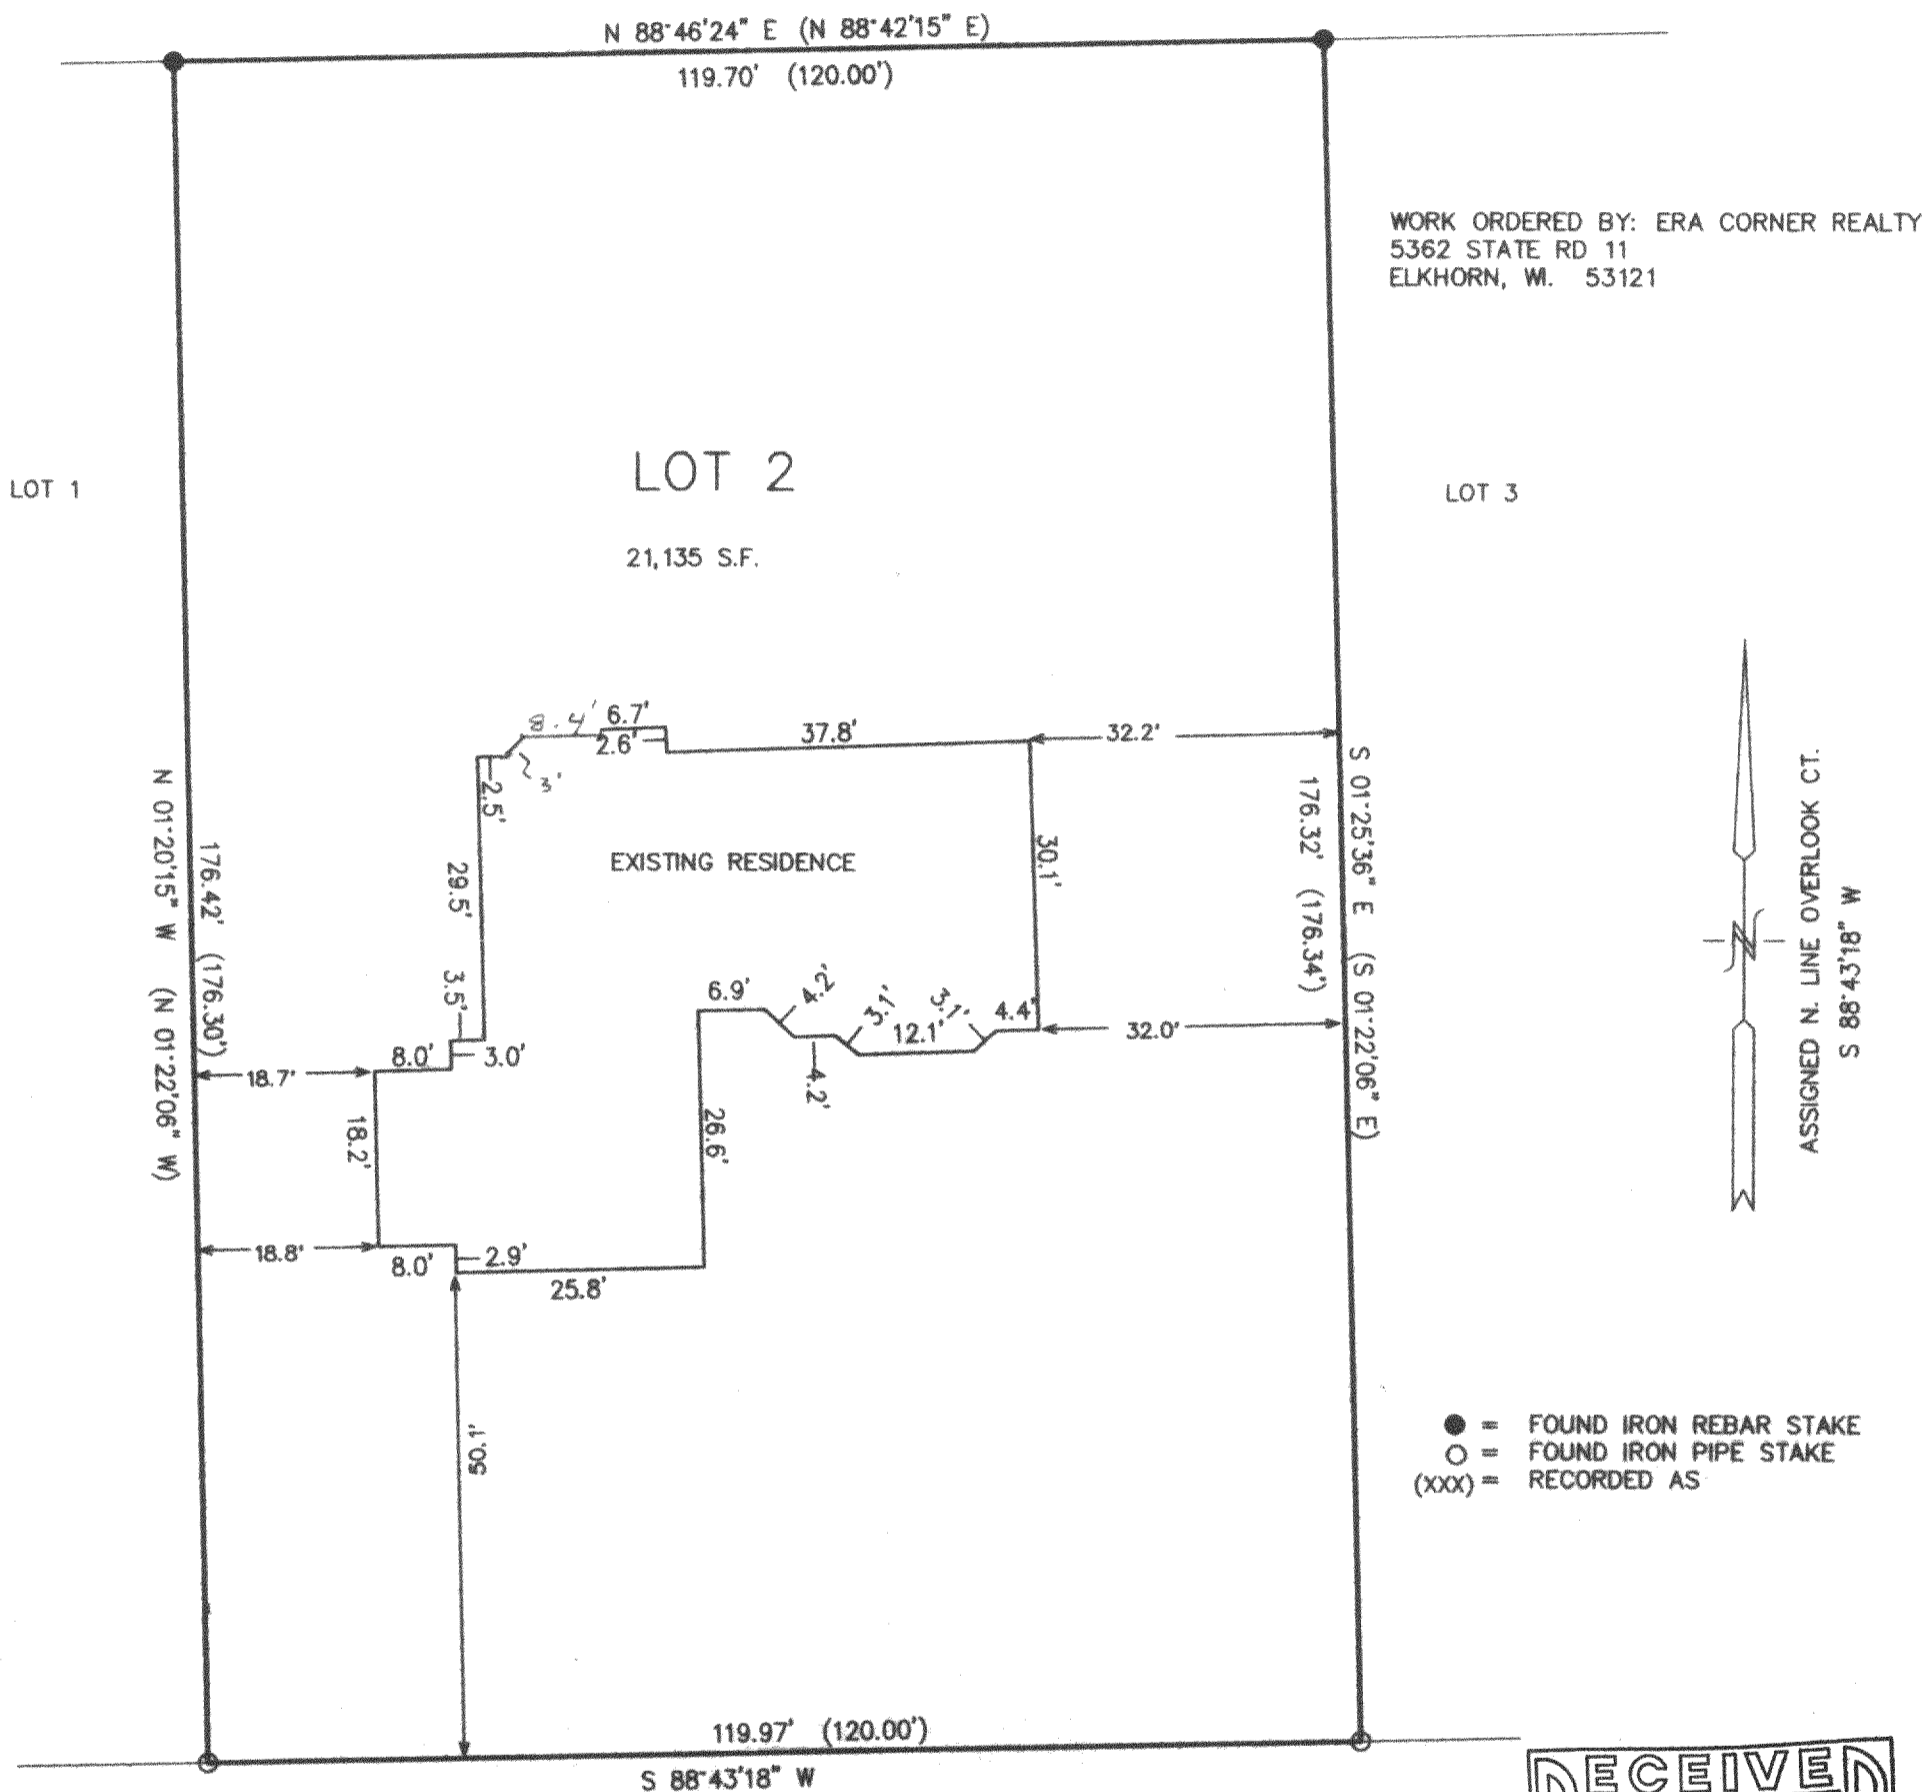

KA 514-2
317-428