

✓ KA2715-3




Plat of Survey

of

Lot 3 of Certified Survey Map No. 2715,

recorded in Vol. 14 of Certified Survey Maps of Walworth County on Page 43 and located in the Northwest 1/4 of Section 18, Town 3 North, Range 17 East, Town of LaPayette, Walworth County, Wisconsin.

Surveyed for: **Kim Bahr**
401 Davis Street
Elkhorn, Wisconsin. 53121

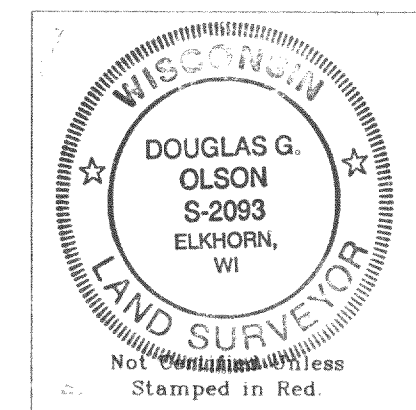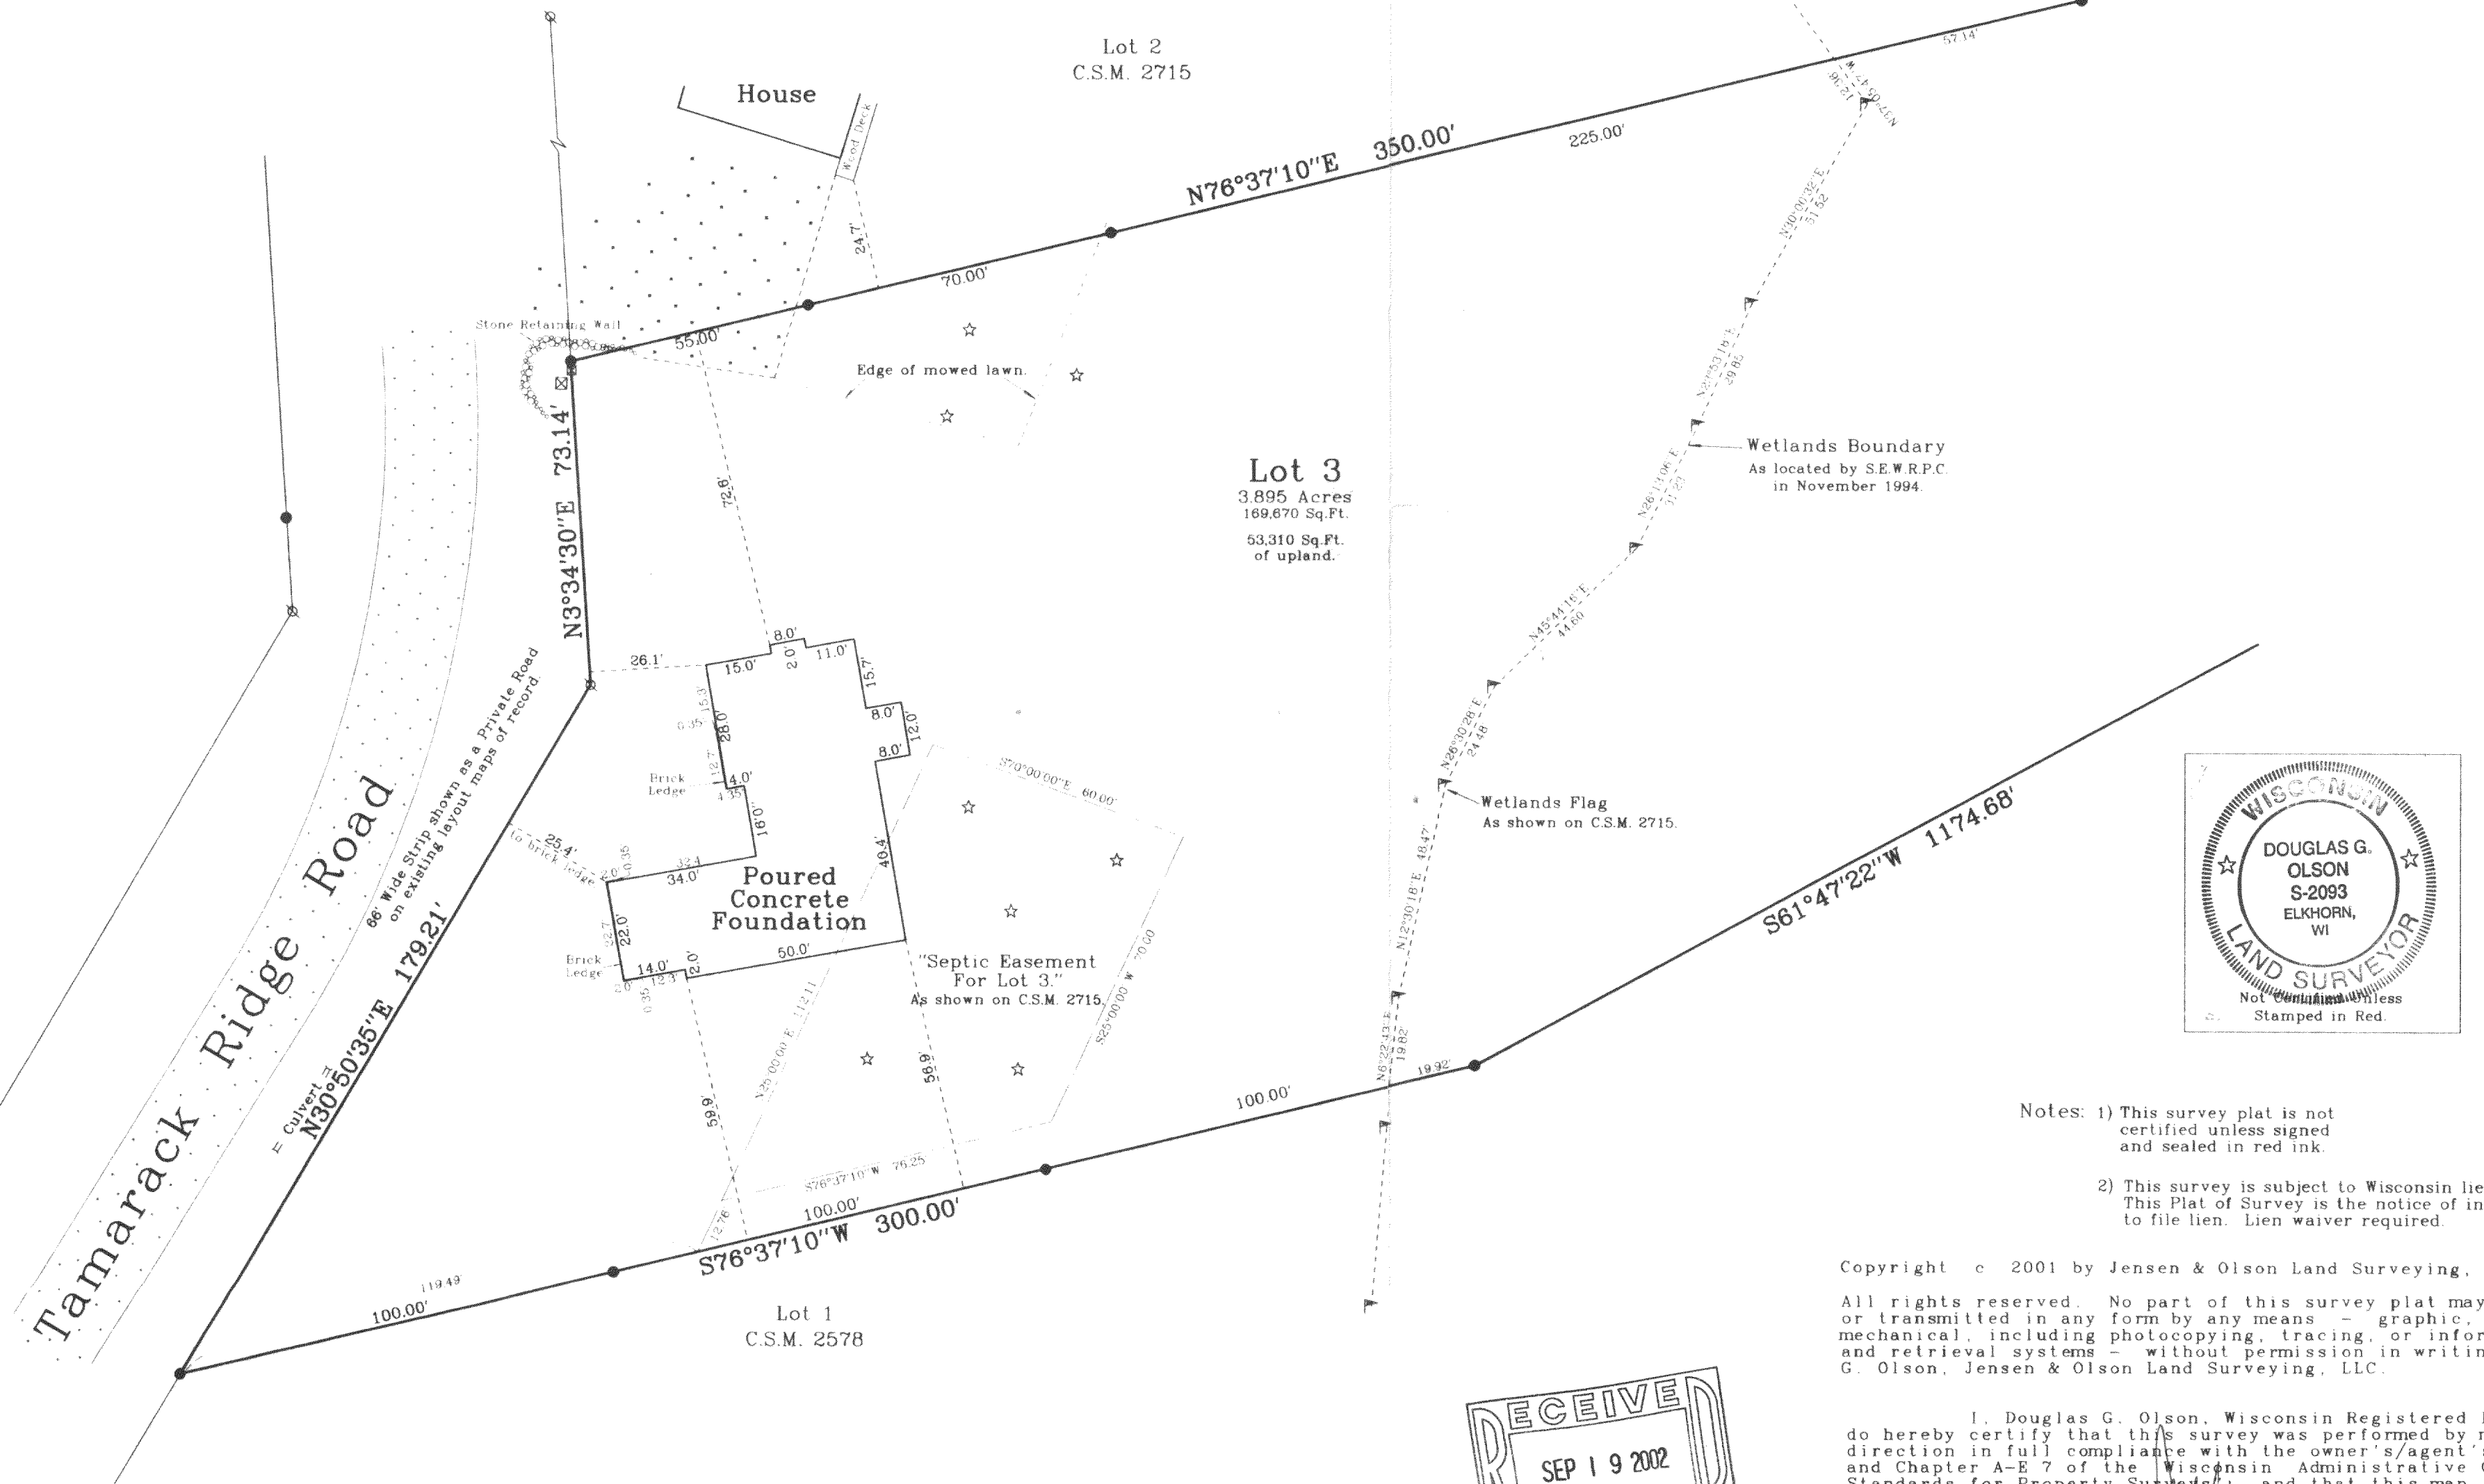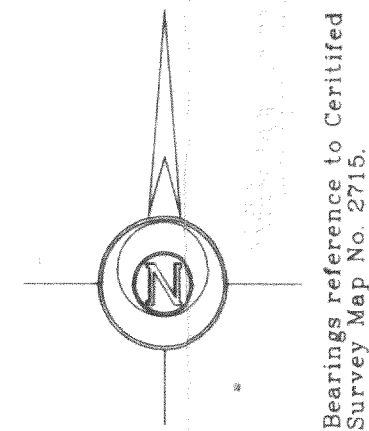

- Notes: 1) This survey plat is not certified unless signed and sealed in red ink.
- 2) This survey is subject to Wisconsin lien laws. This Plat of Survey is the notice of intent to file lien. Lien waiver required.


Copyright © 2001 by Jensen & Olson Land Surveying, LLC.

All rights reserved. No part of this survey plat may be reproduced or transmitted in any form by any means - graphic, electronic, or mechanical, including photocopying, tracing, or information storage and retrieval systems - without permission in writing from Douglas G. Olson, Jensen & Olson Land Surveying, LLC.

I, Douglas G. Olson, Wisconsin Registered Land Surveyor, do hereby certify that this survey was performed by me or under my direction in full compliance with the owner's/agent's instructions and Chapter A-E 7 of the Wisconsin Administrative Code "Minimum Standards for Property Surveys" and that this map is an accurate representation thereof to the best of my knowledge and belief.

Douglas G. Olson
Wisconsin Registered Land Surveyor - 2093

Survey Date: December 14, 2001.
Revisions:

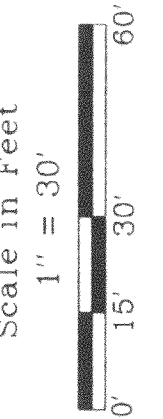

Jensen & Olson Land Surveying, LLC

45 South Wisconsin Street
Elkhorn, Wisconsin. 53121
Telephone (262) 723-3434
Facsimile (262) 723-8044

Legend
Found Iron Pipe
Found Iron Rod
Set Iron Rod 3/4" dia.
Recorded Information
Soil Boring per CSM 2715
Utility Pedestal
Asphalt Surface
Gravel

Sheet 1 of 1 Sheets
Job Reference Number
2001.176

2001.176

317-549