
PREPARED FOR: COLDWELL BANKERS PRIMUS c/o JANE ST. JOHN 226 BROAD STREET LAKE GENEVA WI 53147

PLAT OF SURVEY

-OF-

J.K. SURVEYING INC. N3705 WILLOWBEND LANE LAKE GENEVA, WI, 53147 262-248-3697

LOT 87 OF EVERGREEN ESTATES SUBDIVISION, LOCATED IN THE NORTHWEST 1/4 OF SECTION 19, TOWN 3 NORTH, RANGE 17 EAST, WALWORTH COUNTY, WISCONSIN.

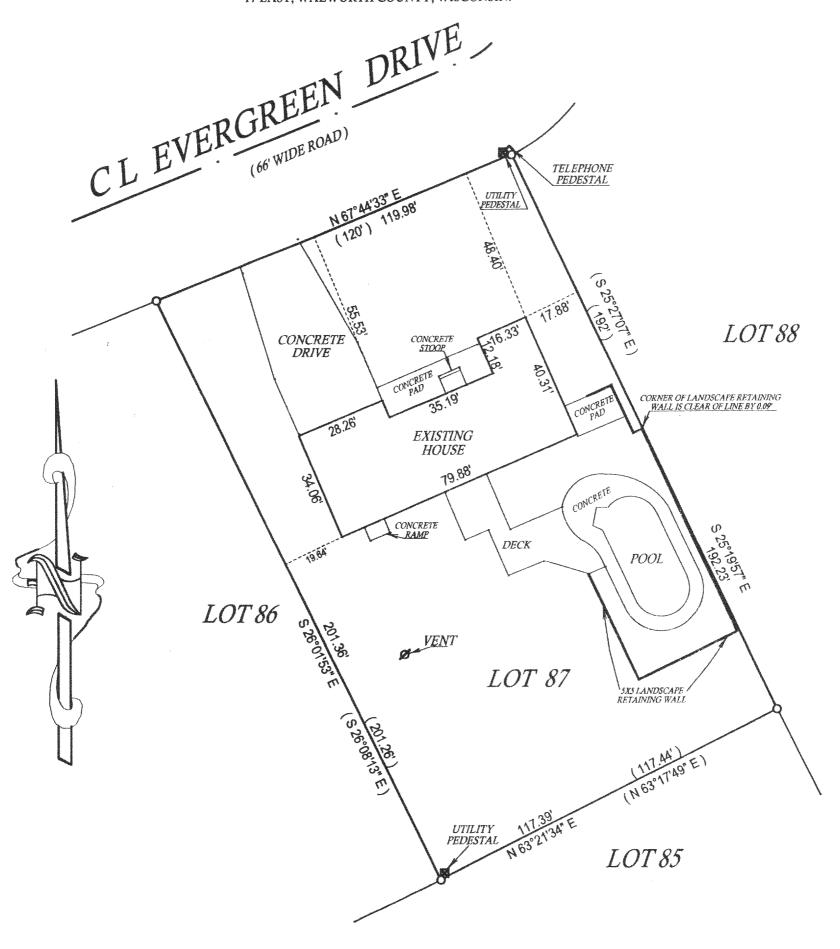



= found iron bar


O= found iron pipe

= set iron pipe

■= set iron bar

SCALE 1" = 30' JOB # 02-500

TAX ID # KE 00087

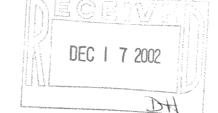

COMPARE LEGAL DESCRIPTION ABOVE AND DRAWING WITH DEED. FOR BUILDING RESTRICTIONS AND EASEMENTS NOT SHOWN, REFER TO DEED, ABSTRACT SOURCES AND LOCAL MUNICIPAL CODES. NOTIFY THE SURVEYOR IMMEDIATELY OF ANY DISCREPANCY.

"I hereby certify that the above described property was surveyed under my supervision and that the above map is a true representation thereof and shows the size and location of all visible structures, apparent easements and encroachments if any."

This survey is made for the present owners of the property, and those who purchase, mortgage, or guarentee the title thereto, within one year from the date hereof.

DATED THIS 30 TH, DAY OF SEPTEMBER 20 02 .



JOHN KROTT S - 2258 Wisconsin Registered Land Surveyor (original if signed in red)