

317-809

PLAT OF SURVEY

UNIT 34, PHASE 2, ROLLING GREEN ESTATES CONDOMINIUM
LOCATED IN THE SE 1/4 AND SW 1/4 SECTION 18
TOWN 3 NORTH, RANGE 17 EAST
TOWN OF LAFAYETTE, WALWORTH COUNTY, WI.


WORK ORDERED BY -
DARLEY WOOLEY
CAN DO CONSTRUCTION
308 EAST OAK CREST DRIVE
WALES, WI 53183

FARRIS, HANSEN & ASSOCIATES, INC.
ENGINEERING - ARCHITECTURE - SURVEYING
7 RIDGWAY COURT P.O. BOX 437
ELKHORN, WISCONSIN 53121
OFFICE: (262) 723-2098 FAX: (262) 723-5886

REVISIONS

PROJECT NO.
6720
DATE:
01/17/05
SHEET NO.
1 OF 1

11661 0034

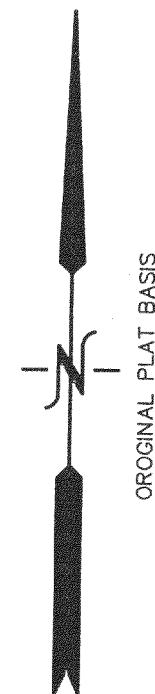

UNIT 35

UNIT 34
34,746 S.F.

UNIT 33

BRIAR DRIVE


TOF = 101.4
EXISTING
RESIDENCE

TOF = 101.1
EXISTING RESIDENCE

AS BUILT
RESIDENCE
T.O.F.=101.1'

BENCH MARK
TOP IRON REBAR
STAKE; ASSIGNED
ELEV.=97.90'

- LEGEND
- = FOUND IRON REBAR STAKE
 - = FOUND IRON PIPE STAKE
 - (XXX) = RECORDED AS

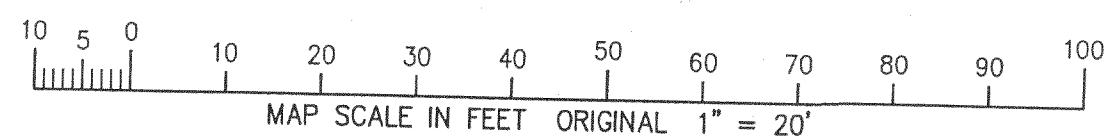

NOTE: COPIES OF THIS MAP TO WHICH THE FOLLOWING CERTIFICATE
WILL APPLY SHOW THE SURVEYOR'S ORIGINAL SEAL AND SIGNATURE
IN RED INK. COPIES BY ANY OTHER MEANS MAY HAVE ALTERATIONS
WHICH DO NOT REPRESENT THE SURVEYOR'S WORK PRODUCT.

I HEREBY CERTIFY THAT THE ABOVE DESCRIBED PROPERTY HAS BEEN
SURVEYED UNDER MY DIRECTION AND THAT THE ABOVE MAP IS A TRUE
REPRESENTATION THEREOF AND SHOWS THE SIZE AND LOCATION OF
THE PROPERTY AND ITS EXTERIOR BOUNDARIES. THIS SURVEY IS
MADE FOR THE USE OF THE PRESENT OWNERS OF THE PROPERTY, AND
ALSO THOSE WHO PURCHASE, MORTGAGE, OR GUARANTEE THE TITLE
THERETO WITHIN ONE YEAR FROM THE DATE HEREOF.

DATED: FEBRUARY 17, 2005

REVISED 05-24-2005
TO SHOW SIZE & LOCATION OF
AS BUILT FOUNDATION

PETER S. GORDON R.L.S. 2101