
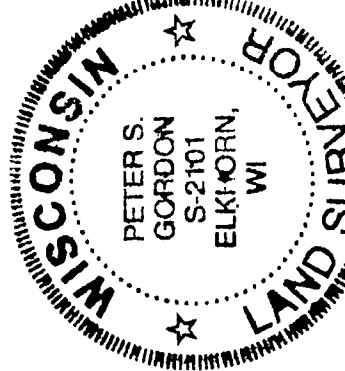
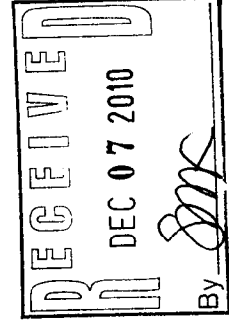
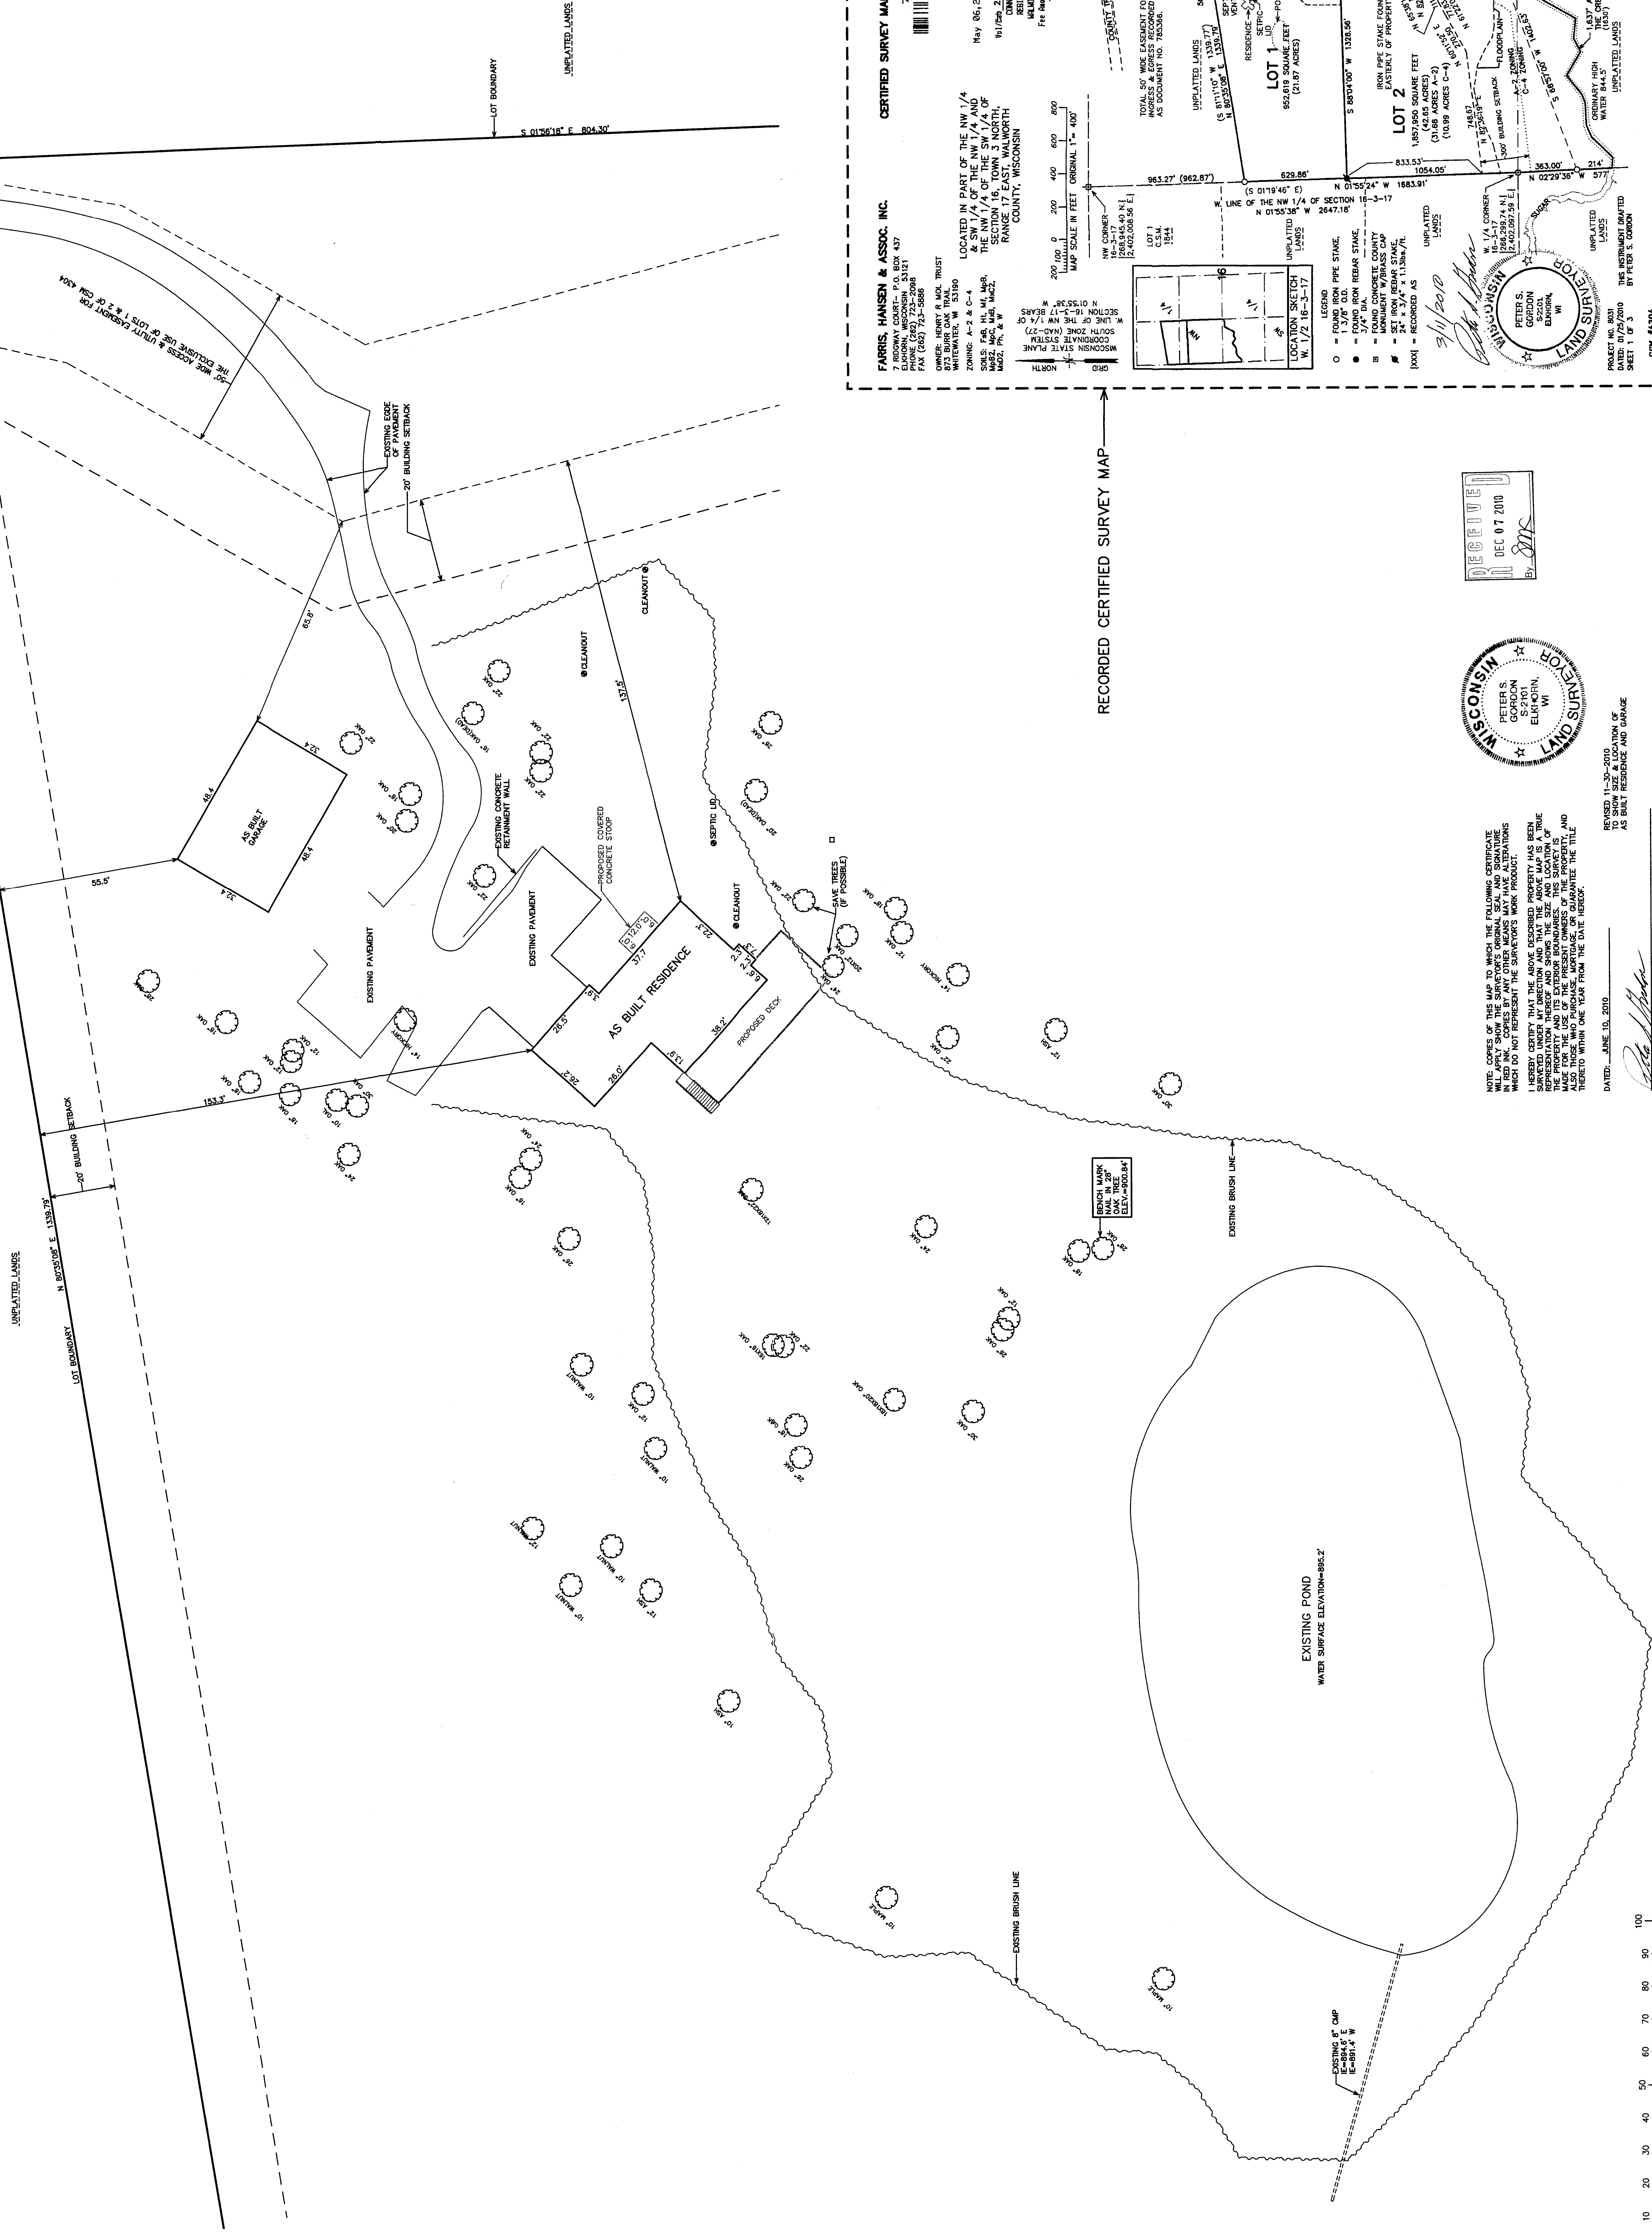


TOPOGRAPHICAL MAPPING & PERMIT PLAT

PART OF LOT 1 OF CERTIFIED SURVEY MAP NO. 4304

LOCATED IN PART OF THE NW 1/4 AND SW 1/4 OF THE SW 1/4 OF SECTION 16, TOWN 3 NORTH, RANGE 17 EAST, WALWORTH COUNTY, WISCONSIN

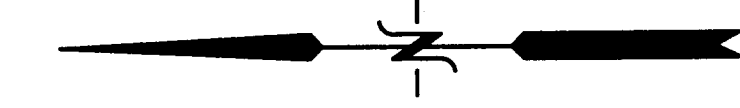


NOTE: COPIES OF THIS MAP TO WHICH THE FOLLOWING CERTIFICATE WILL APPLY SHOW THE SURVEYOR'S ORIGINAL SURVEY AND SURVEYING INSTRUMENTS AND RECORDS. THESE COPIES ARE NOT GUARANTEED TO BE TRUE AND ACCURATE. THE SURVEYOR'S ORIGINAL SURVEY AND SURVEYING INSTRUMENTS AND RECORDS ARE THE ONLY TRUE AND ACCURATE REPRESENTATION OF THE SURVEY. THE SURVEYOR'S ORIGINAL SURVEY AND SURVEYING INSTRUMENTS AND RECORDS ARE THE ONLY TRUE AND ACCURATE REPRESENTATION OF THE SURVEY. THE SURVEYOR'S ORIGINAL SURVEY AND SURVEYING INSTRUMENTS AND RECORDS ARE THE ONLY TRUE AND ACCURATE REPRESENTATION OF THE SURVEY.

DATED: JUNE 15, 2010
REVISION: 11-30-2010
BY: PETER S. GORDON
AS BUILT RESIDENCE AND GARAGE

FARRIS, HANSEN & ASSOCIATES, INC.
ENGINEERING - ARCHITECTURE - SURVEYING
7 ELKHORN, WISCONSIN 53121
P.O. BOX 437
ELKHORN, WISCONSIN 53121
OFFICE: (262) 723-2098 FAX: (262) 723-5886

REVISIONS
6/27/2010-AS BUILT RESIDENCE AND GARAGE
6/27/2010-AS BUILT RESIDENCE AND GARAGE

PROJECT NO.
8031.01
DATE
6/10/2010
SHEET NO.
1 OF 1

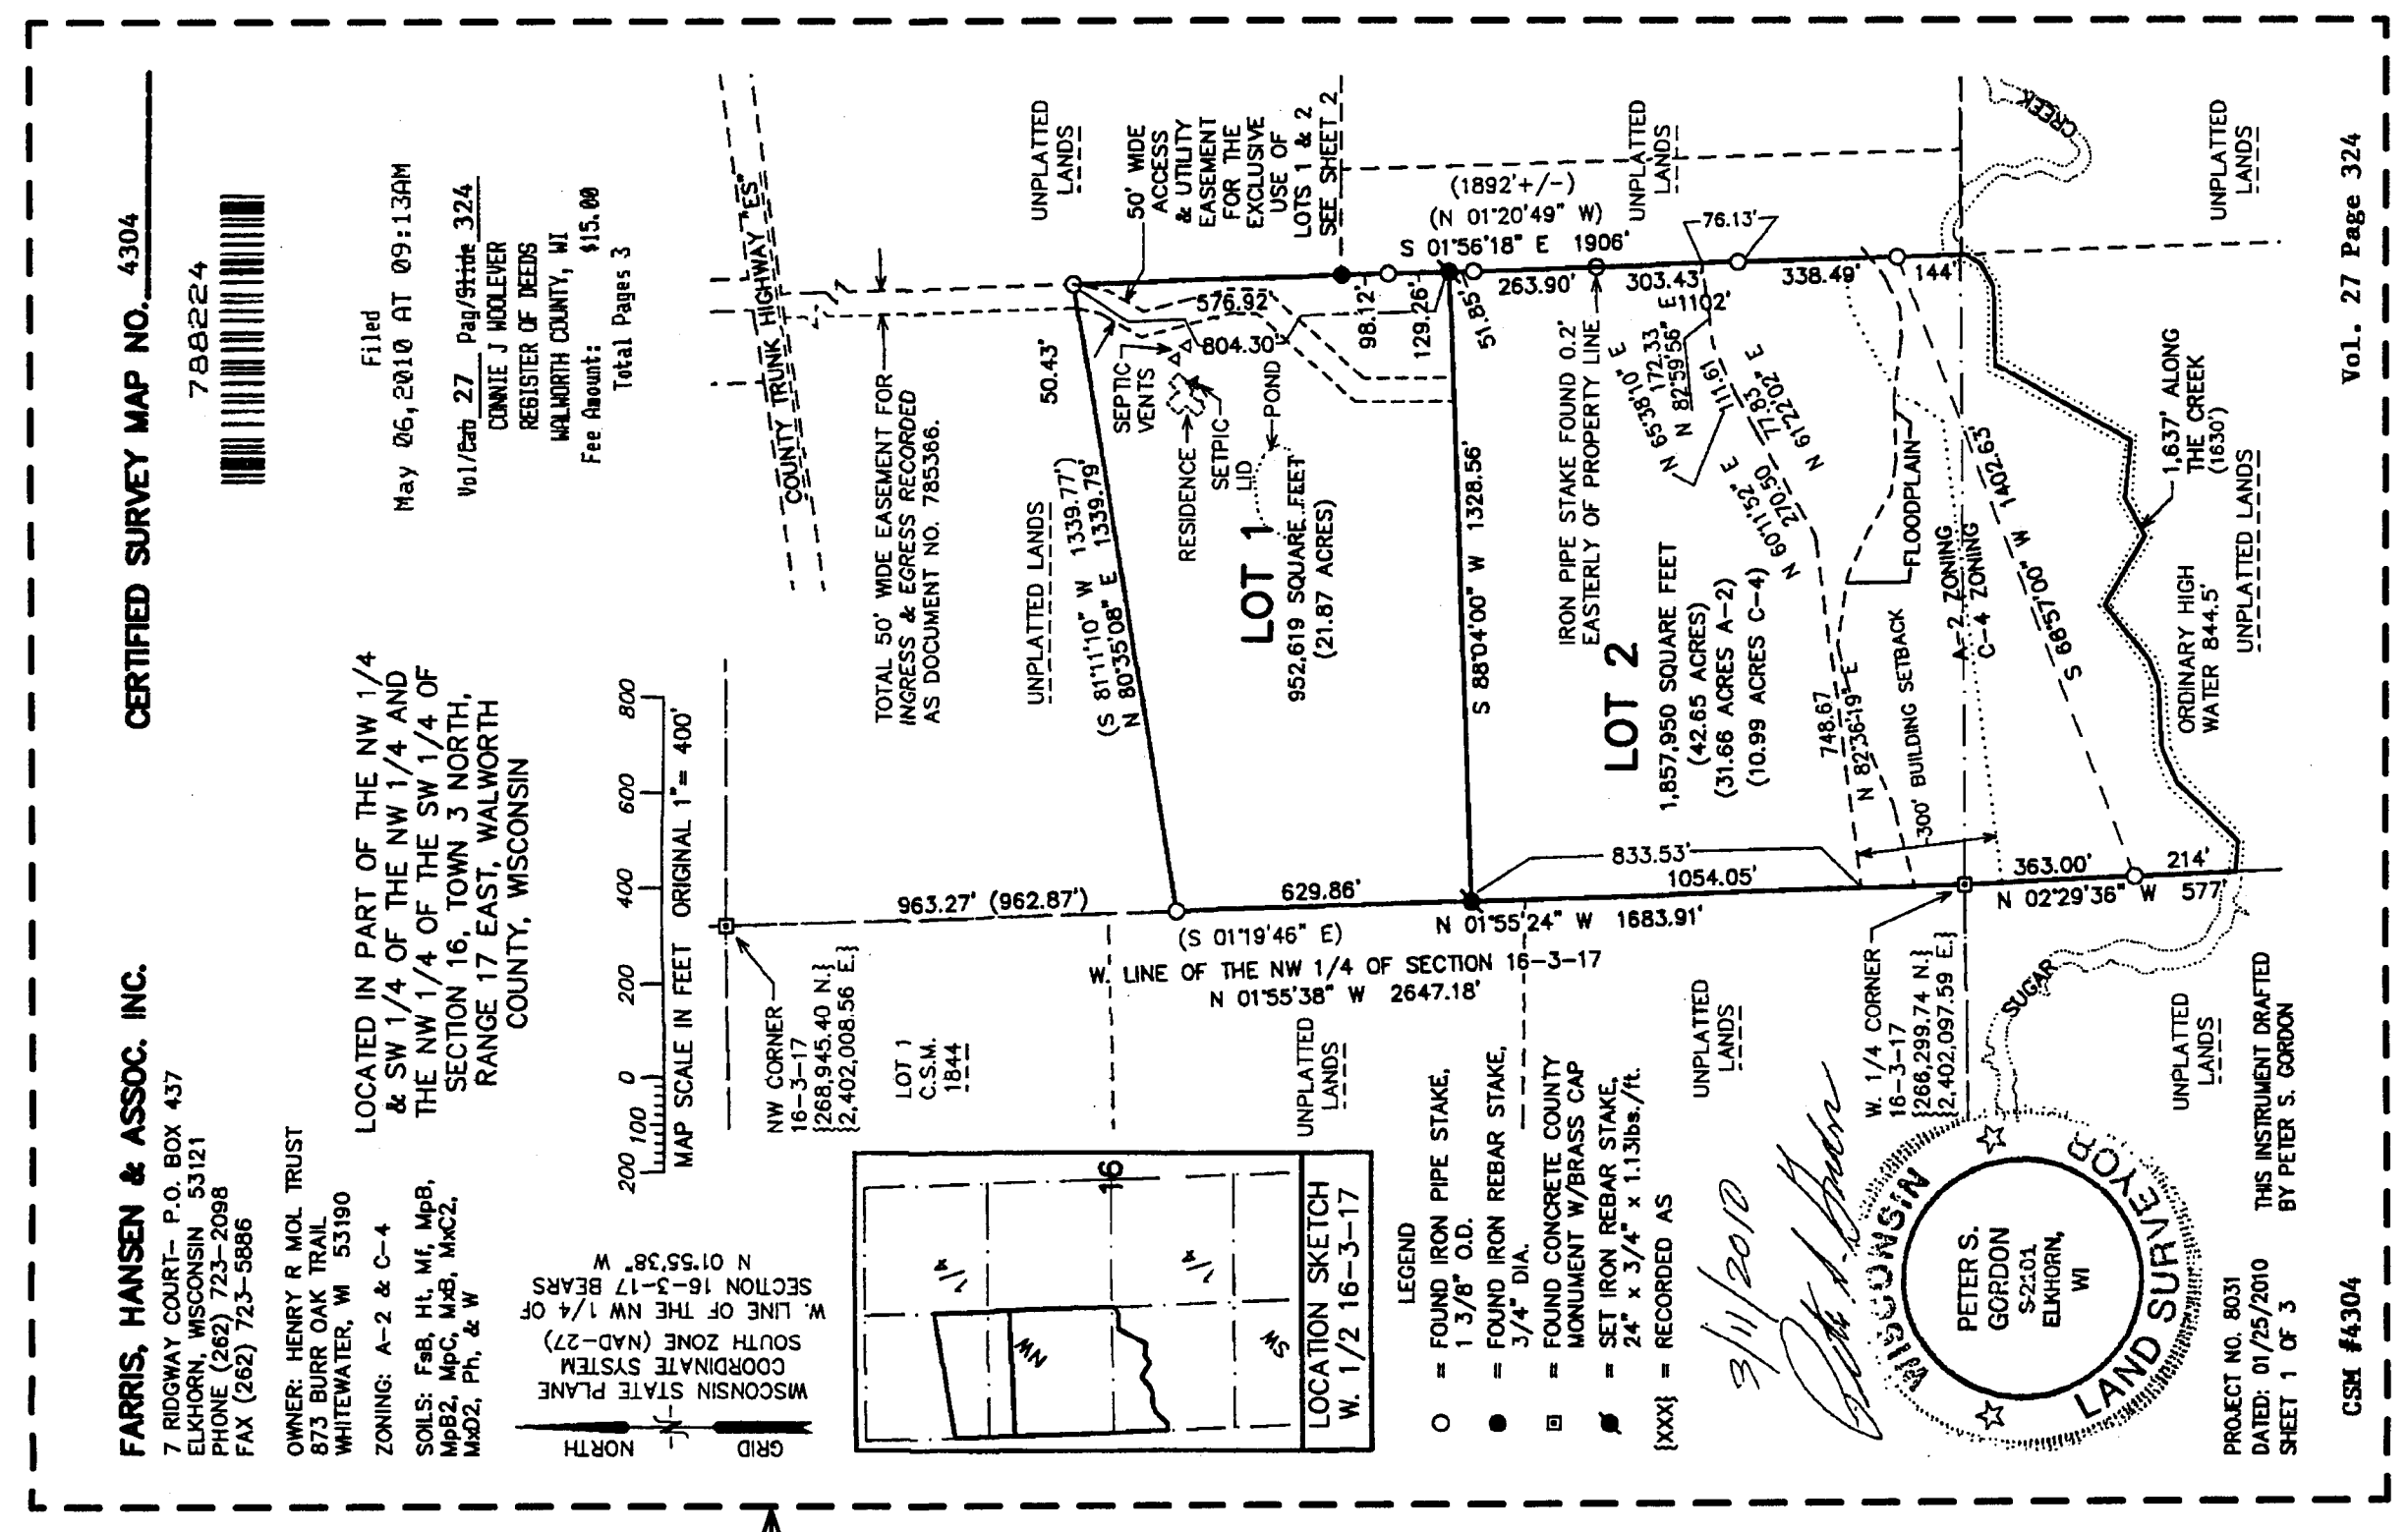

317-920

KA4304-1