

GOD'S COUNTRY, LTD. PROPERTY
TOWN OF LAFAYETTE
WALWORTH COUNTY, WISCONSIN

WORK ORDERED BY:
AL CHURCH - CHURCH CITY BUILDING
P.O. BOX 6 - 121 DEVILS LANE
WALWORTH, WI 53184

FARRIS, HANSEN & ASSOCIATES, INC.
ENGINEERING - ARCHITECTURE - SURVEYING
7 RIDGWAY COURT P.O. BOX 437
ELKHORN, WISCONSIN 53121
OFFICE: (262) 723-2098 FAX: (262) 723-5886

REVISIONS	
12/27/95-	TO SHOW PRO.
RES. & BARN	
08/22/02-	TO SHOW AS-
BUILT RES. &	
BARN	
12/22/05-	ADD COUNTY
TOPO	
01/05/06-	PARCEL LEGAL
DESCRIPTION	
AND SKETCH	
01-24-06	CORRECT TYPO
02/20/2006	ADD PROPOSED POND
07/11/2006	REZONE MAP
05/30/2007	8/12/2007-KB
CONDITIONAL USE MAP	
7/16/2008-KB	UPDATE EXTG. RES.

PROJECT NO.
4420.05

DATE
01/06/06

SHEET NO.
1 OF 1

PLAT OF SURVEY



GOD'S COUNTRY, LTD. PROPERTY

THE EAST 1/2 OF THE SE 1/4 SECTION 7 TOWN 3 NORTH, RANGE 17 EAST WALWORTH COUNTY, WISCONSIN

NOTE: PORTIONS OF ROADS, UTILITIES, TOPOGRAPHY, ETC.
TAKEN FROM SURVEYS OF RECORD, TAX MAPS,
ENGINEERING PLANS, AND COUNTY AERIAL
TOPOGRAPHIC MAPS.

LEGAL DESCRIPTION
PARCEL 1

LOCATED IN PART OF THE NORTHEAST 1/4 AND SOUTHEAST 1/4 OF THE SOUTHEAST 1/4 OF SECTION 7, TOWN 3 NORTH, RANGE 17 EAST, TOWN OF LA FAYETTE, WALWORTH COUNTY, WISCONSIN, MORE PARTICULARLY DESCRIBED AS FOLLOWS:
COMMENCING AT A CONCRETE COUNTY MONUMENT FOUND MARKING THE SOUTHEAST CORNER OF SAID SECTION 7 (T&N:R17E); THENCE ALONG THE SOUTH LINE OF SAID SOUTHEAST 1/4, S 88DEG 53MIN 40SEC W, 424.45 FEET TO THE POINT OF BEGINNING; THENCE CONTINUE, S 88DEG 53MIN 40SEC W, 800.00 FEET TO THE WEST LINE OF EAST 1/2 OF SAID SOUTHEAST 1/4; THENCE ALONG SAID WEST LINE, N 00DEG 48MIN 42SEC W, 1830.00 FEET; THENCE N 88DEG 53MIN 40SEC E, 701.58 FEET; THENCE S 15DEG 06MIN 07SEC E, 803.85 FEET; THENCE S 00DEG 48MIN 42SEC E, 1050.00 FEET TO THE POINT OF BEGINNING. CONTAINING 1,569,600 SQUARE FEET (36.03 ACRES) OF LAND, MORE OR LESS.

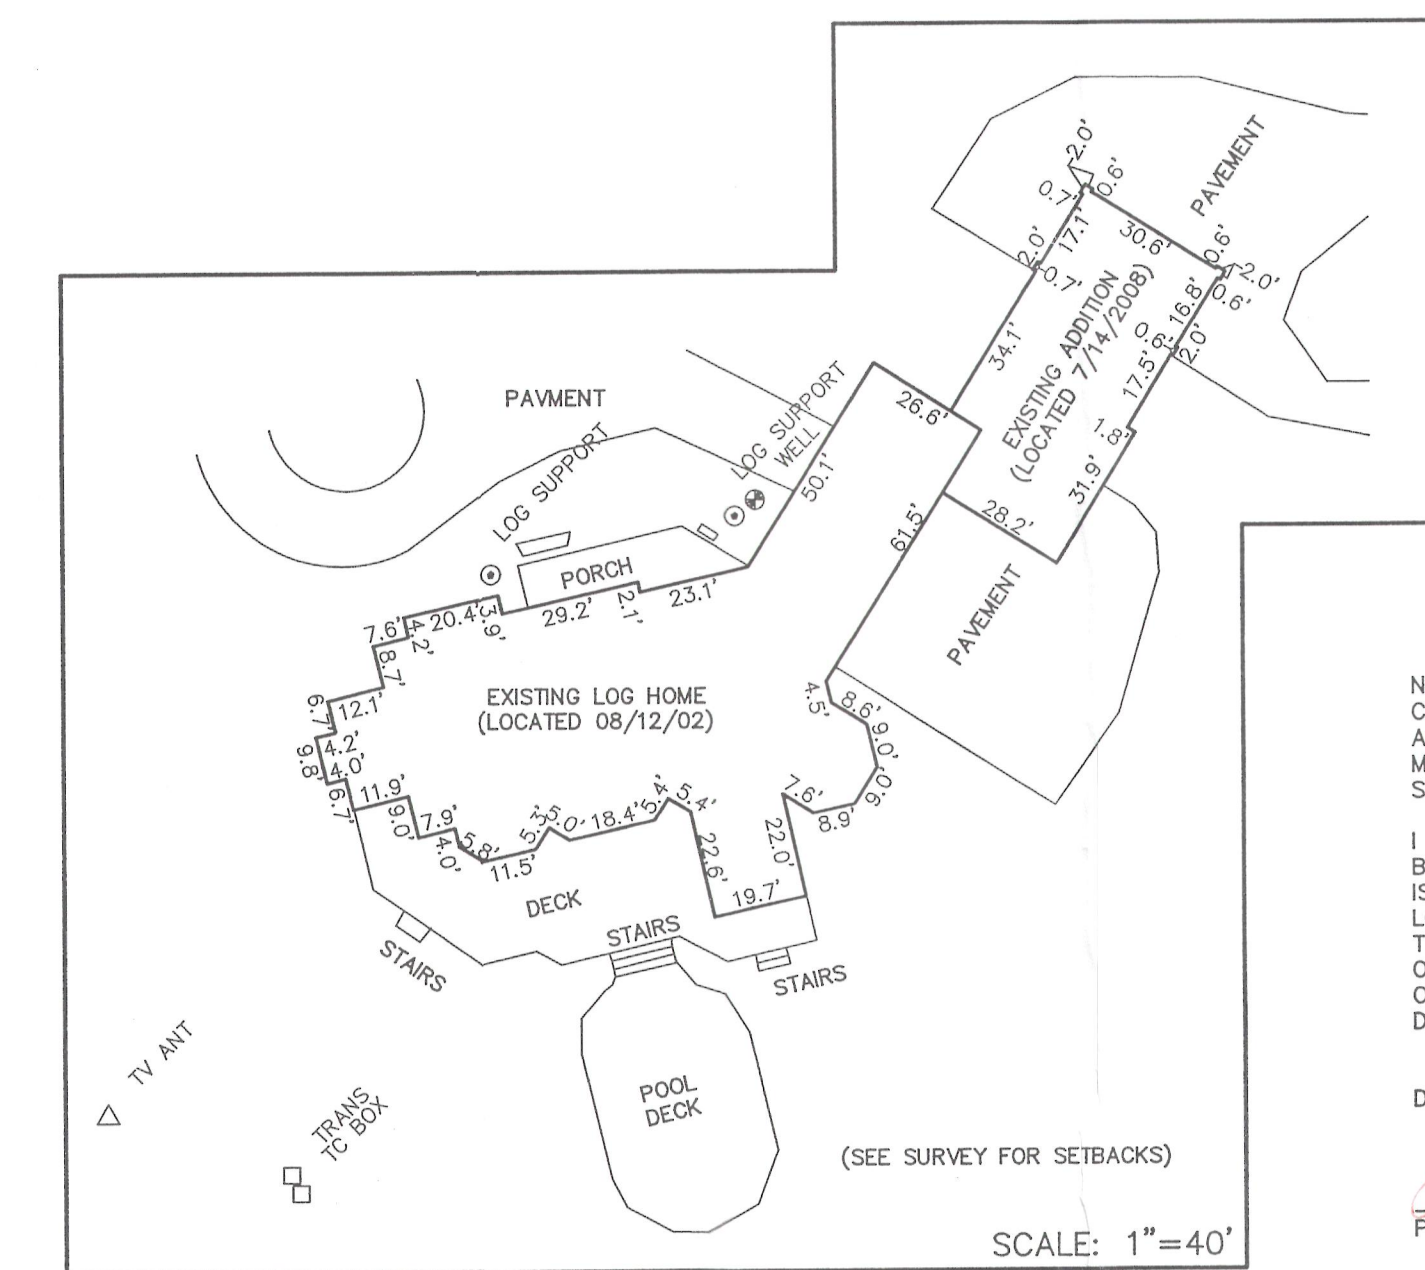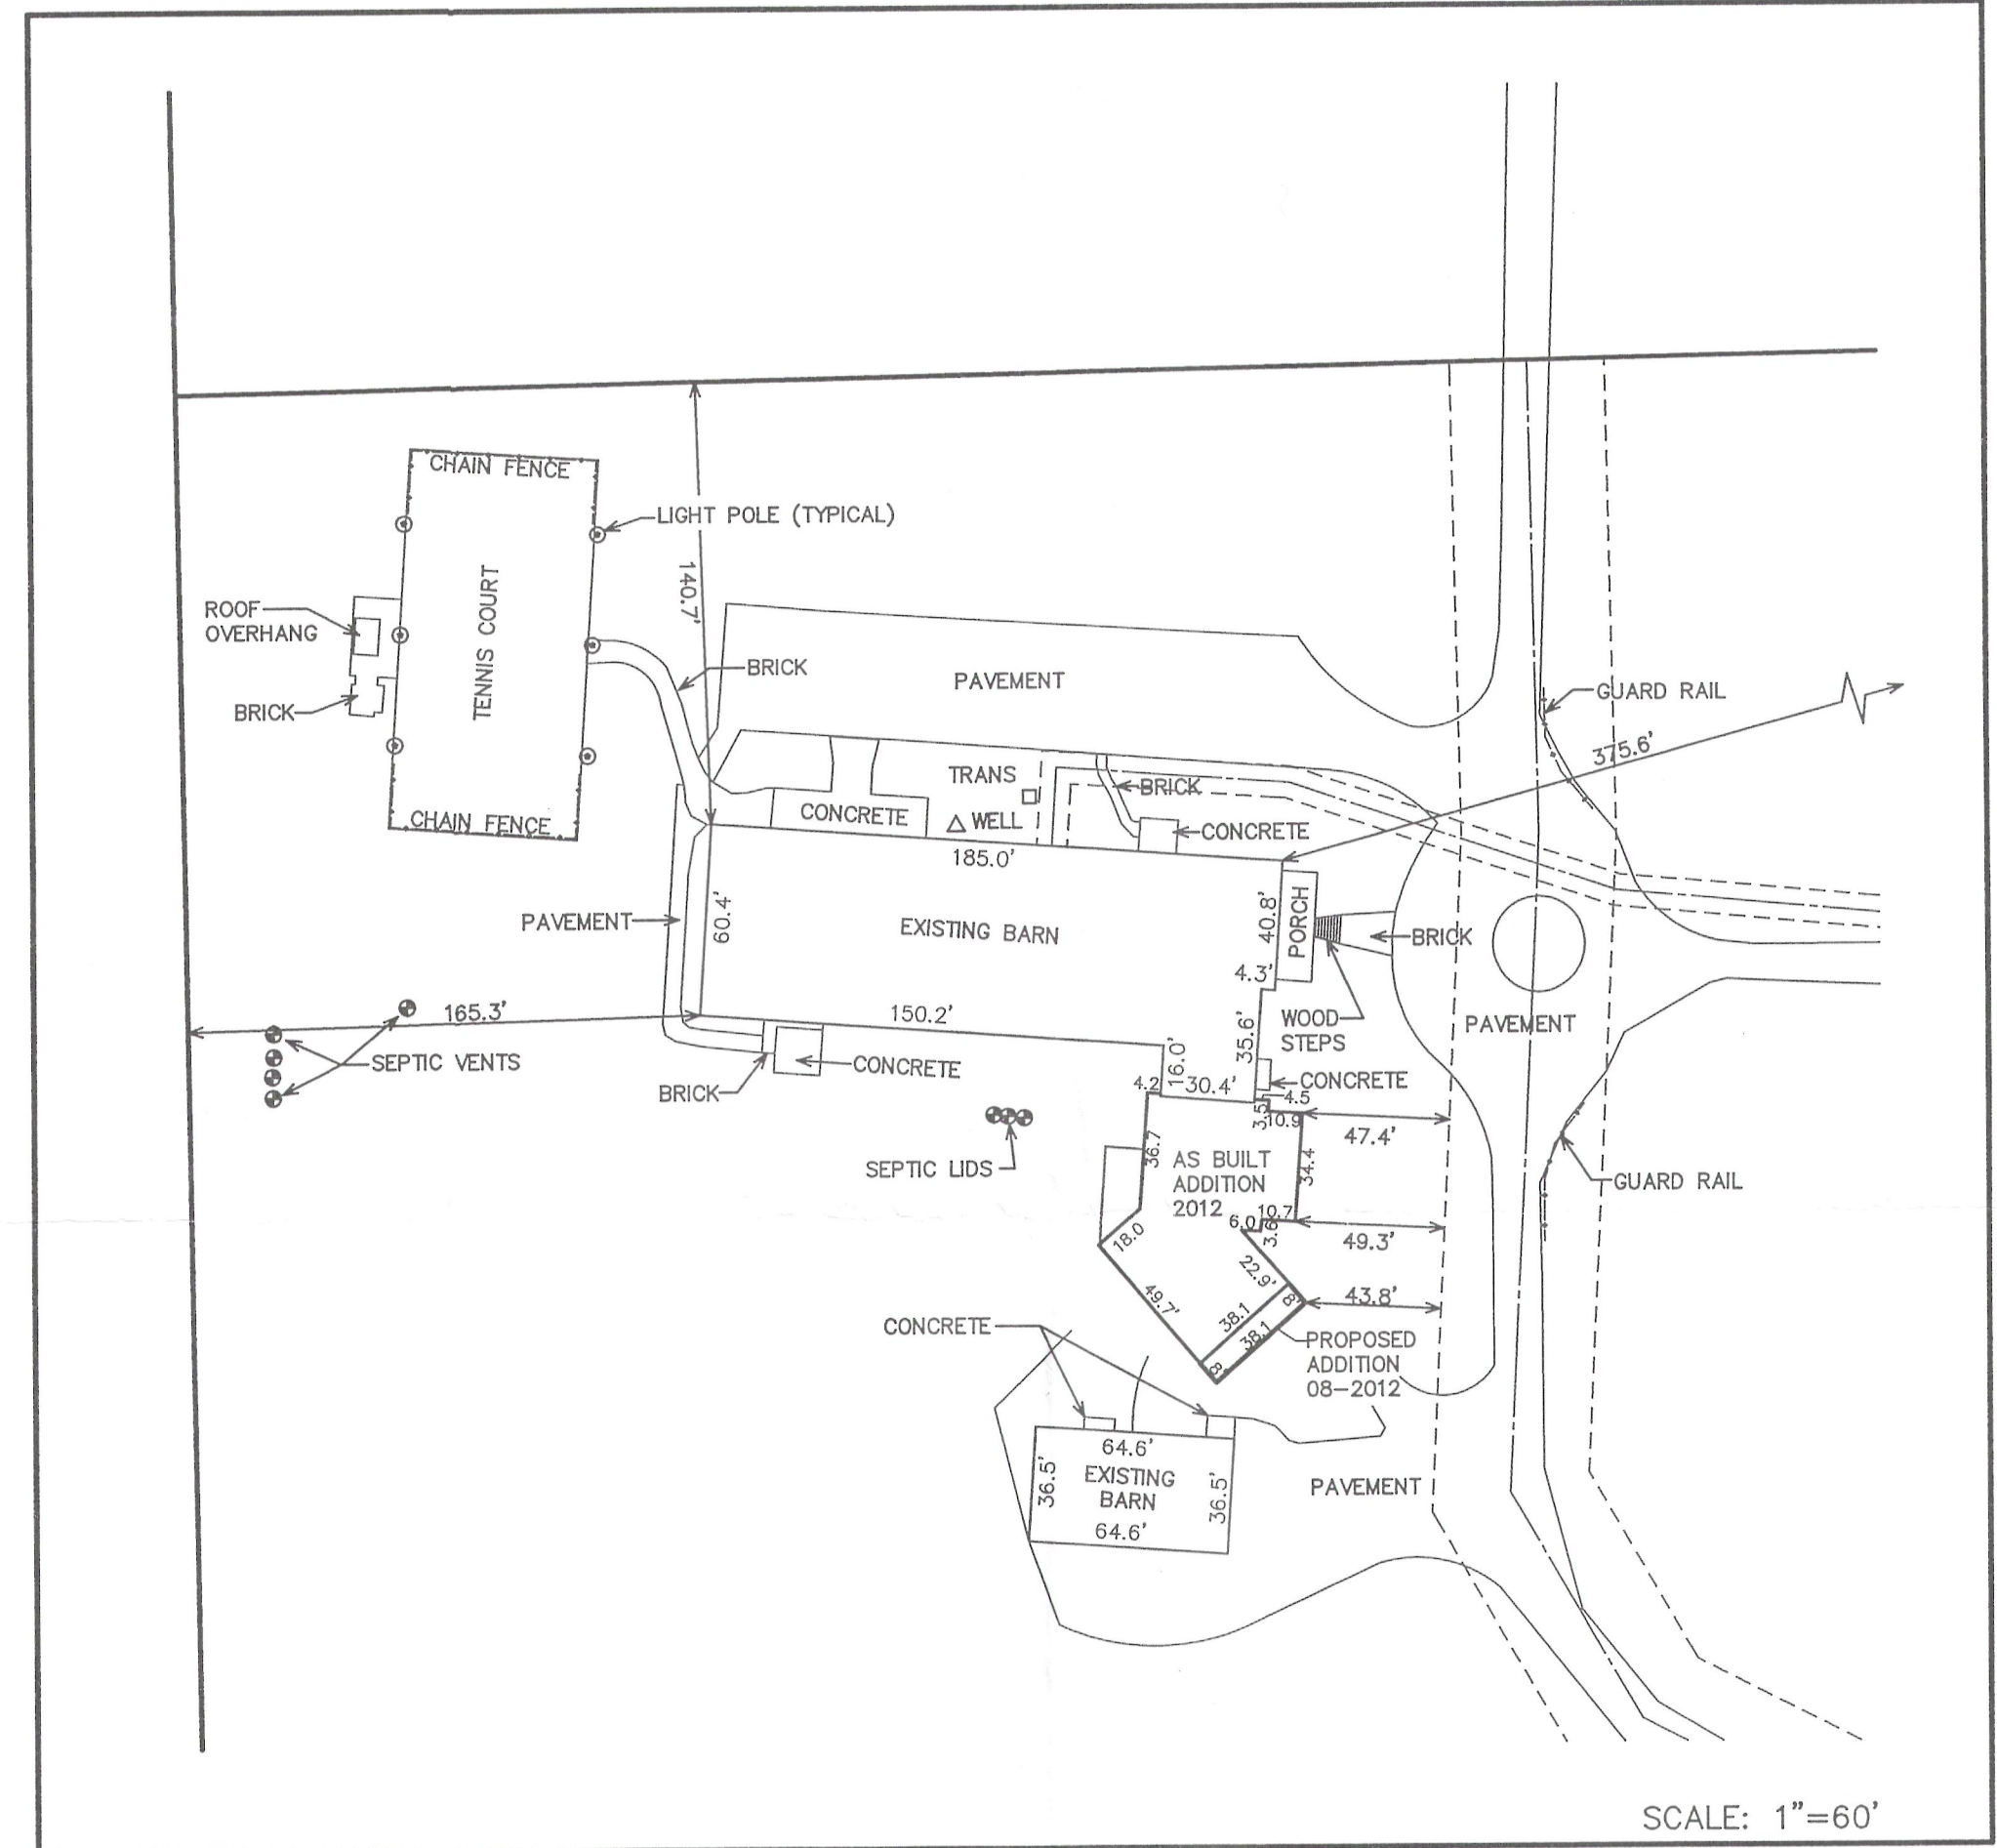

NOTE: COPIES OF THIS MAP TO WHICH THE FOLLOWING
CERTIFICATE WILL APPLY SHOW SURVEYOR'S ORIGINAL SEAL
AND SIGNATURE IN RED INK. COPIES BY ANY OTHER MEANS
MAY HAVE ALTERATIONS WHICH DO NOT REPRESENT THE
SURVEYOR'S WORK PRODUCT.


I HEREBY CERTIFY THAT THE ABOVE DESCRIBED PROPERTY HAS
BEEN SURVEYED UNDER MY DIRECTION AND THAT THE ABOVE MAP
IS A TRUE REPRESENTATION THEREOF AND SHOWS THE SIZE AND
LOCATION OF THE PROPERTY AND ITS EXTERIOR BOUNDARIES.
THIS SURVEY IS MADE FOR THE USE OF THE PRESENT OWNERS
OF THE PROPERTY, AND ALSO THOSE WHO PURCHASE, MORTGAGE,
OR GUARANTEE THE TITLE THERETO WITHIN ONE YEAR FROM THE
DATE HEREOF.

DATED: 11/17/95

PETER S. GORDON
R.L.S. 2101

REVISED 09-11-2008
TO SHOW PROPOSED BUILDING
REVISED 11-11-2008
TO SHOW AS BUILT BUILDING
REVISED 08-02-2012
TO SHOW AS BUILT ADDITION &
PROPOSED ADDITION

317-951

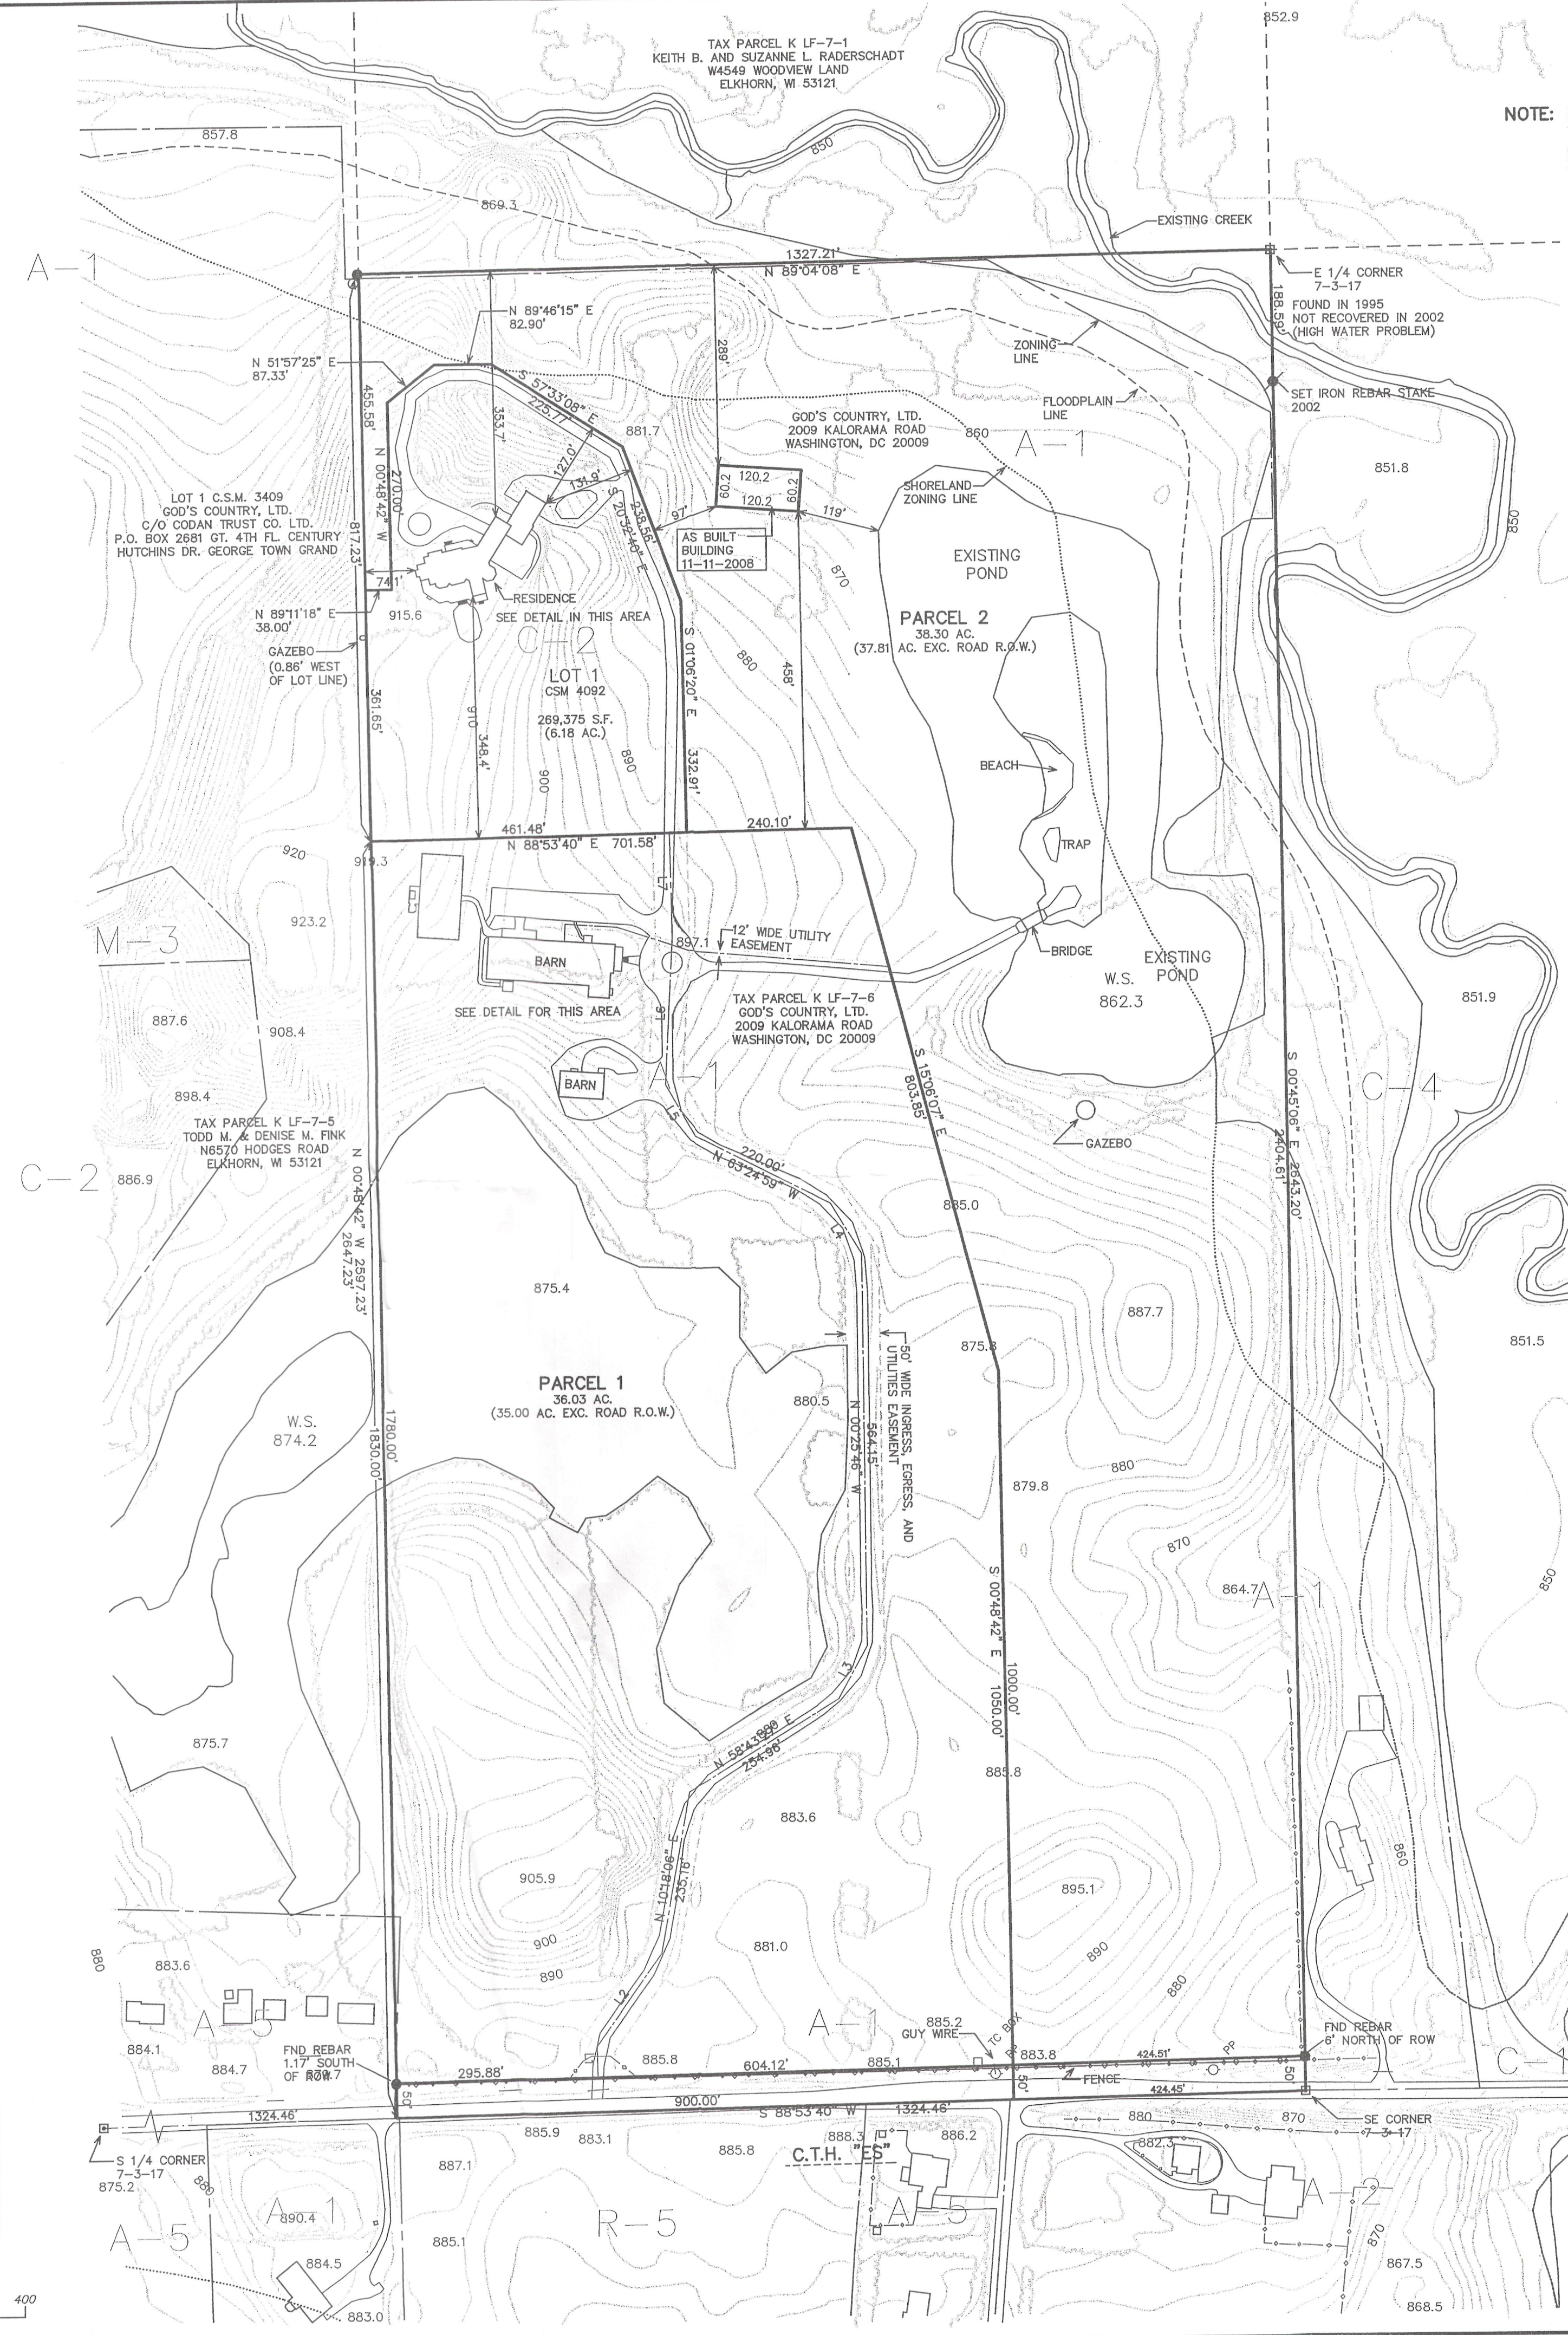

LEGEND

- FOUND COUNTY MONUMENT
- SET IRON REBAR STAKE
- FOUND IRON PIPE STAKE
- FOUND IRON REBAR STAKE
- RECORDED AS

LINE	BEARING	DISTANCE
L1	N 01°06'20" W	45.77
L2	N 35°48'21" E	162.27
L3	N 29°08'51" E	86.97
L4	N 31°55'23" W	85.27
L5	N 30°18'23" W	83.76
L6	N 02°48'12" E	208.48
L7	N 01°06'20" W	150.00

MAP SCALE IN FEET ORIGINAL 1"=150'

KLF 7-6 KLF7-6A KA4098-1