



PREPARED FOR
ANDY SZMANSKY
KEEFE REAL ESTATE
1040 N. WISCONSIN ST.
ELKHORN WI. 53121

PLAT OF SURVEY OF

LOT 4 OF CERTIFIED SURVEY MAP NO. 514, ACCORDING TO
THE PLAT THEREOF RECORDED IN VOLUME 2 OF CERTIFIED
SURVEYS ON PAGE 348 AS DOCUMENT NO. 695565, TOWN OF
LaFAYETTE, WALWORTH COUNTY, WISCONSIN.


KROTT SURVEYING INC.
(262) 248-3697
N 3705 WILLOW BEND LANE
LAKE GENEVA WI. 53147

C.L. BALSAM DRIVE
(66' WIDE)

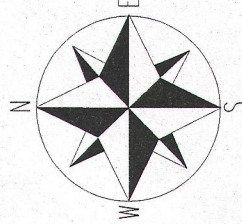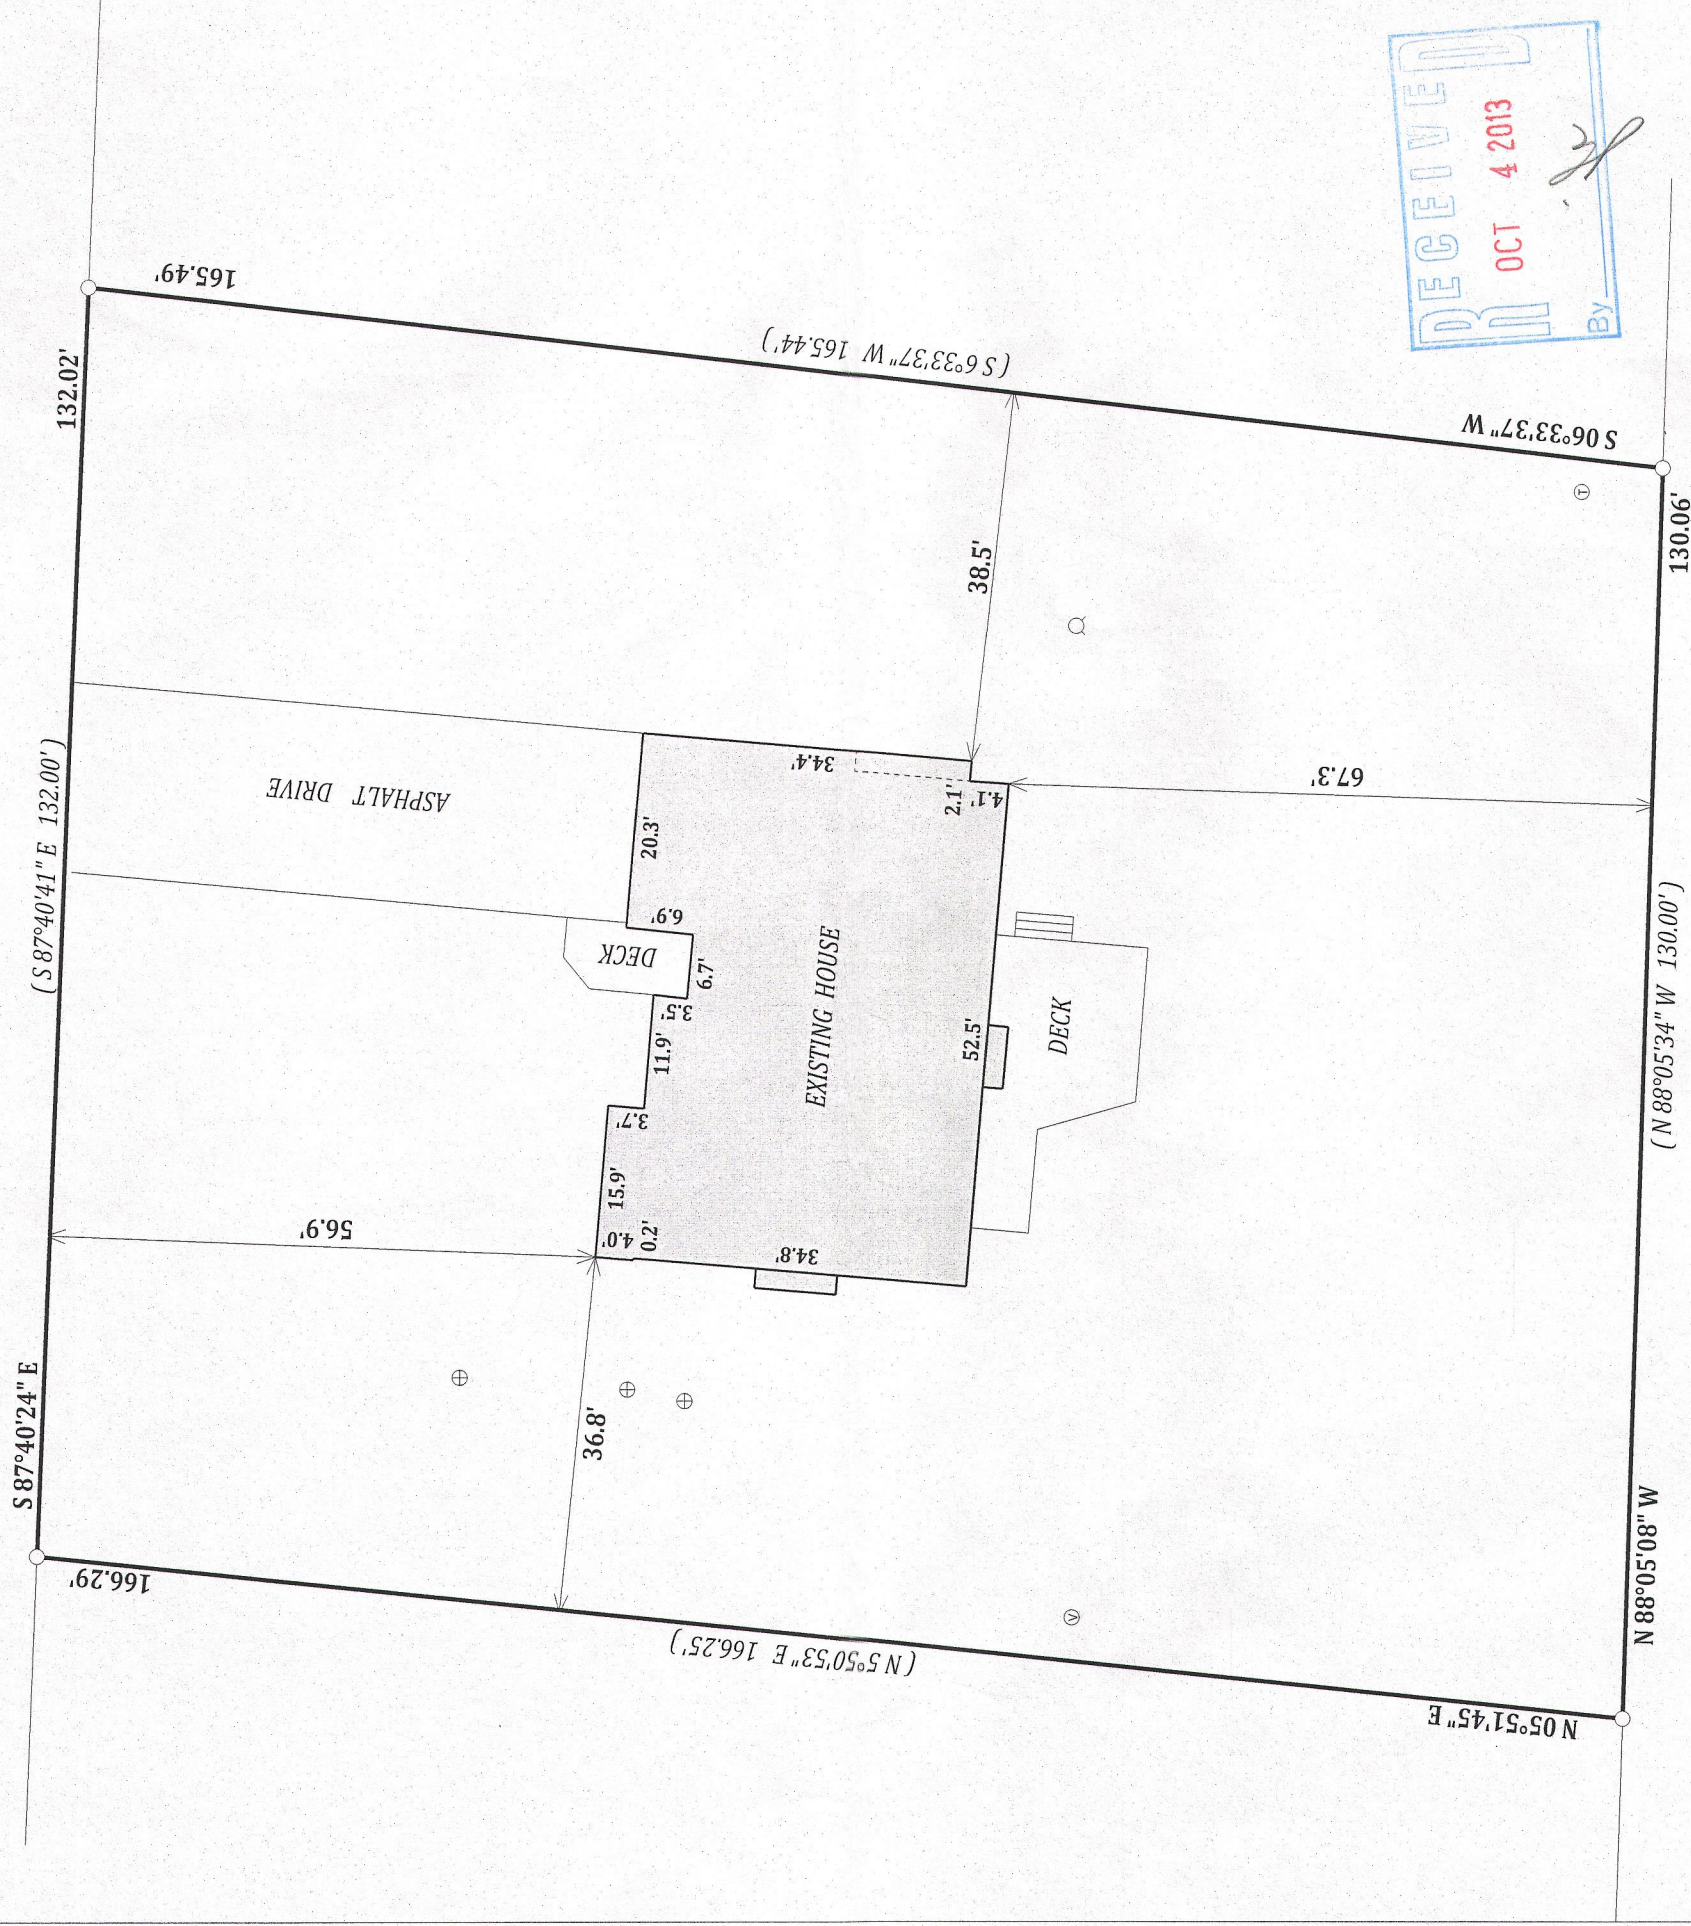

SCALE 1" = 20'

NOTE: BEARINGS ARE REFERENCED TO C.S.M. NO. 514

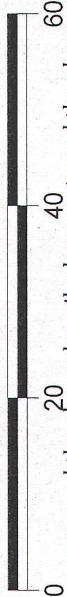

I have surveyed the above-described property and the above map is a true representation thereof and shows the size and location of the property, its exterior boundaries, the location and dimensions of all structures thereon, fences apparent easements and roadways and visible encroachments, if any.

DATED THIS 3rd DAY OF OCTOBER 2013

John P. Krott

JOHN P. KROTT S-2258
WISCONSIN REGISTERED LAND SURVEYOR
(NOTE: THIS IS NOT A CERTIFIED COPY
UNLESS SIGNED IN RED INK)

LEGEND

○ FOUND IRON PIPE

⊕ CONCRETE ACCESS COVER

⊙ VENT

⊙ WELL

(XX) RECORDED AS

TAX ID # K451400004

JOB # 13-155

317-974