

PART OF THE SOUTHEAST 1/4 OF SECTION 15, T. 3 N., R. 17 E.
OF THE 4TH P.M., TOWNSHIP OF LAFAYETTE, COUNTY OF WALWORTH,
STATE OF WISCONSIN AND MORE PARTICULARLY DESCRIBED AS FOLLOWS:
COMMENCE AT AN IRON PIPE STAKE AT THE SOUTHEAST CORNER OF WALWORTH
COUNTY CERTIFIED SURVEY MAP NO. 529, THENCE N. 1°21'23" W., ALONG
THE EAST LINE OF CSM # 529, 266.31 FEET TO AN IRON PIPE STAKE AND
THE PLACE OF BEGINNING OF PARCEL OF LAND HEREINAFTER DESCRIBED:
THENCE CONTINUE N. 1°21'23" W., ALONG EAST LINE OF CSM # 529,
9.00 FEET TO AN IRON PIPE STAKE; THENCE N. 88°38'37" E., 12.00
FEET TO AN IRON PIPE STAKE; THENCE S. 1°21'23" E., 9.00 FEET TO
AN IRON PIPE STAKE; THENCE S. 88°38'37" W., 12.00 FEET TO THE
PLACE OF BEGINNING. CONTAINING 108 SQUARE FEET OF LAND.

SCALE 1" = 40'

ALL CORNERS OF LOT SURVEYED ARE MARKED BY 1" BY 24" IRON PIPE STAKES


BEARINGS ARE RELATIVE TO THE EAST LINE OF CERTIFIED SURVEY MAP NO. 529 WHICH WAS USED AS RECORDED AS N.1°21'23" W.

[illegible]

The subject is a citizen of the United States of the present age, who is young and also those who follow him, together, guarantee the title of the work, and the date of the report.

dated at Burlington, N.H. 27th day
of AUGUST 1978

John F. Degen
John F. Degen, Land Surveyor S 242

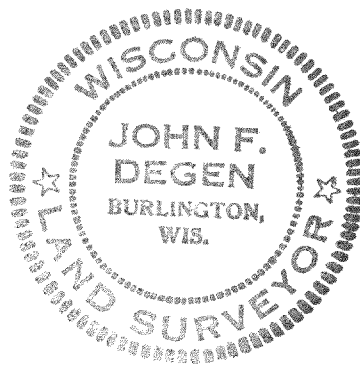

SE CORNER
CSM # 529 → PIPE
N 89° 59' 43" W

A diagram of a square plot. The top side is labeled $N 88^{\circ} 38' 37'' E$ with a distance of 12. The right side is labeled $S 1^{\circ} 21' 23'' E$ with a distance of 9.00. The bottom side is labeled $S 88^{\circ} 38' 37'' W$ with a distance of 12. The left side is labeled 9.00. The plot is represented by a square with a small circle at the bottom-left corner.

E. LINE CSM # 529
N 102° 23' W 266.31