

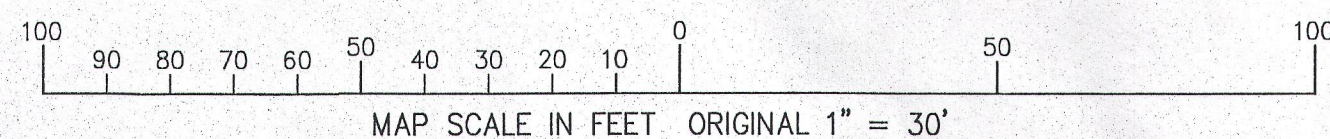


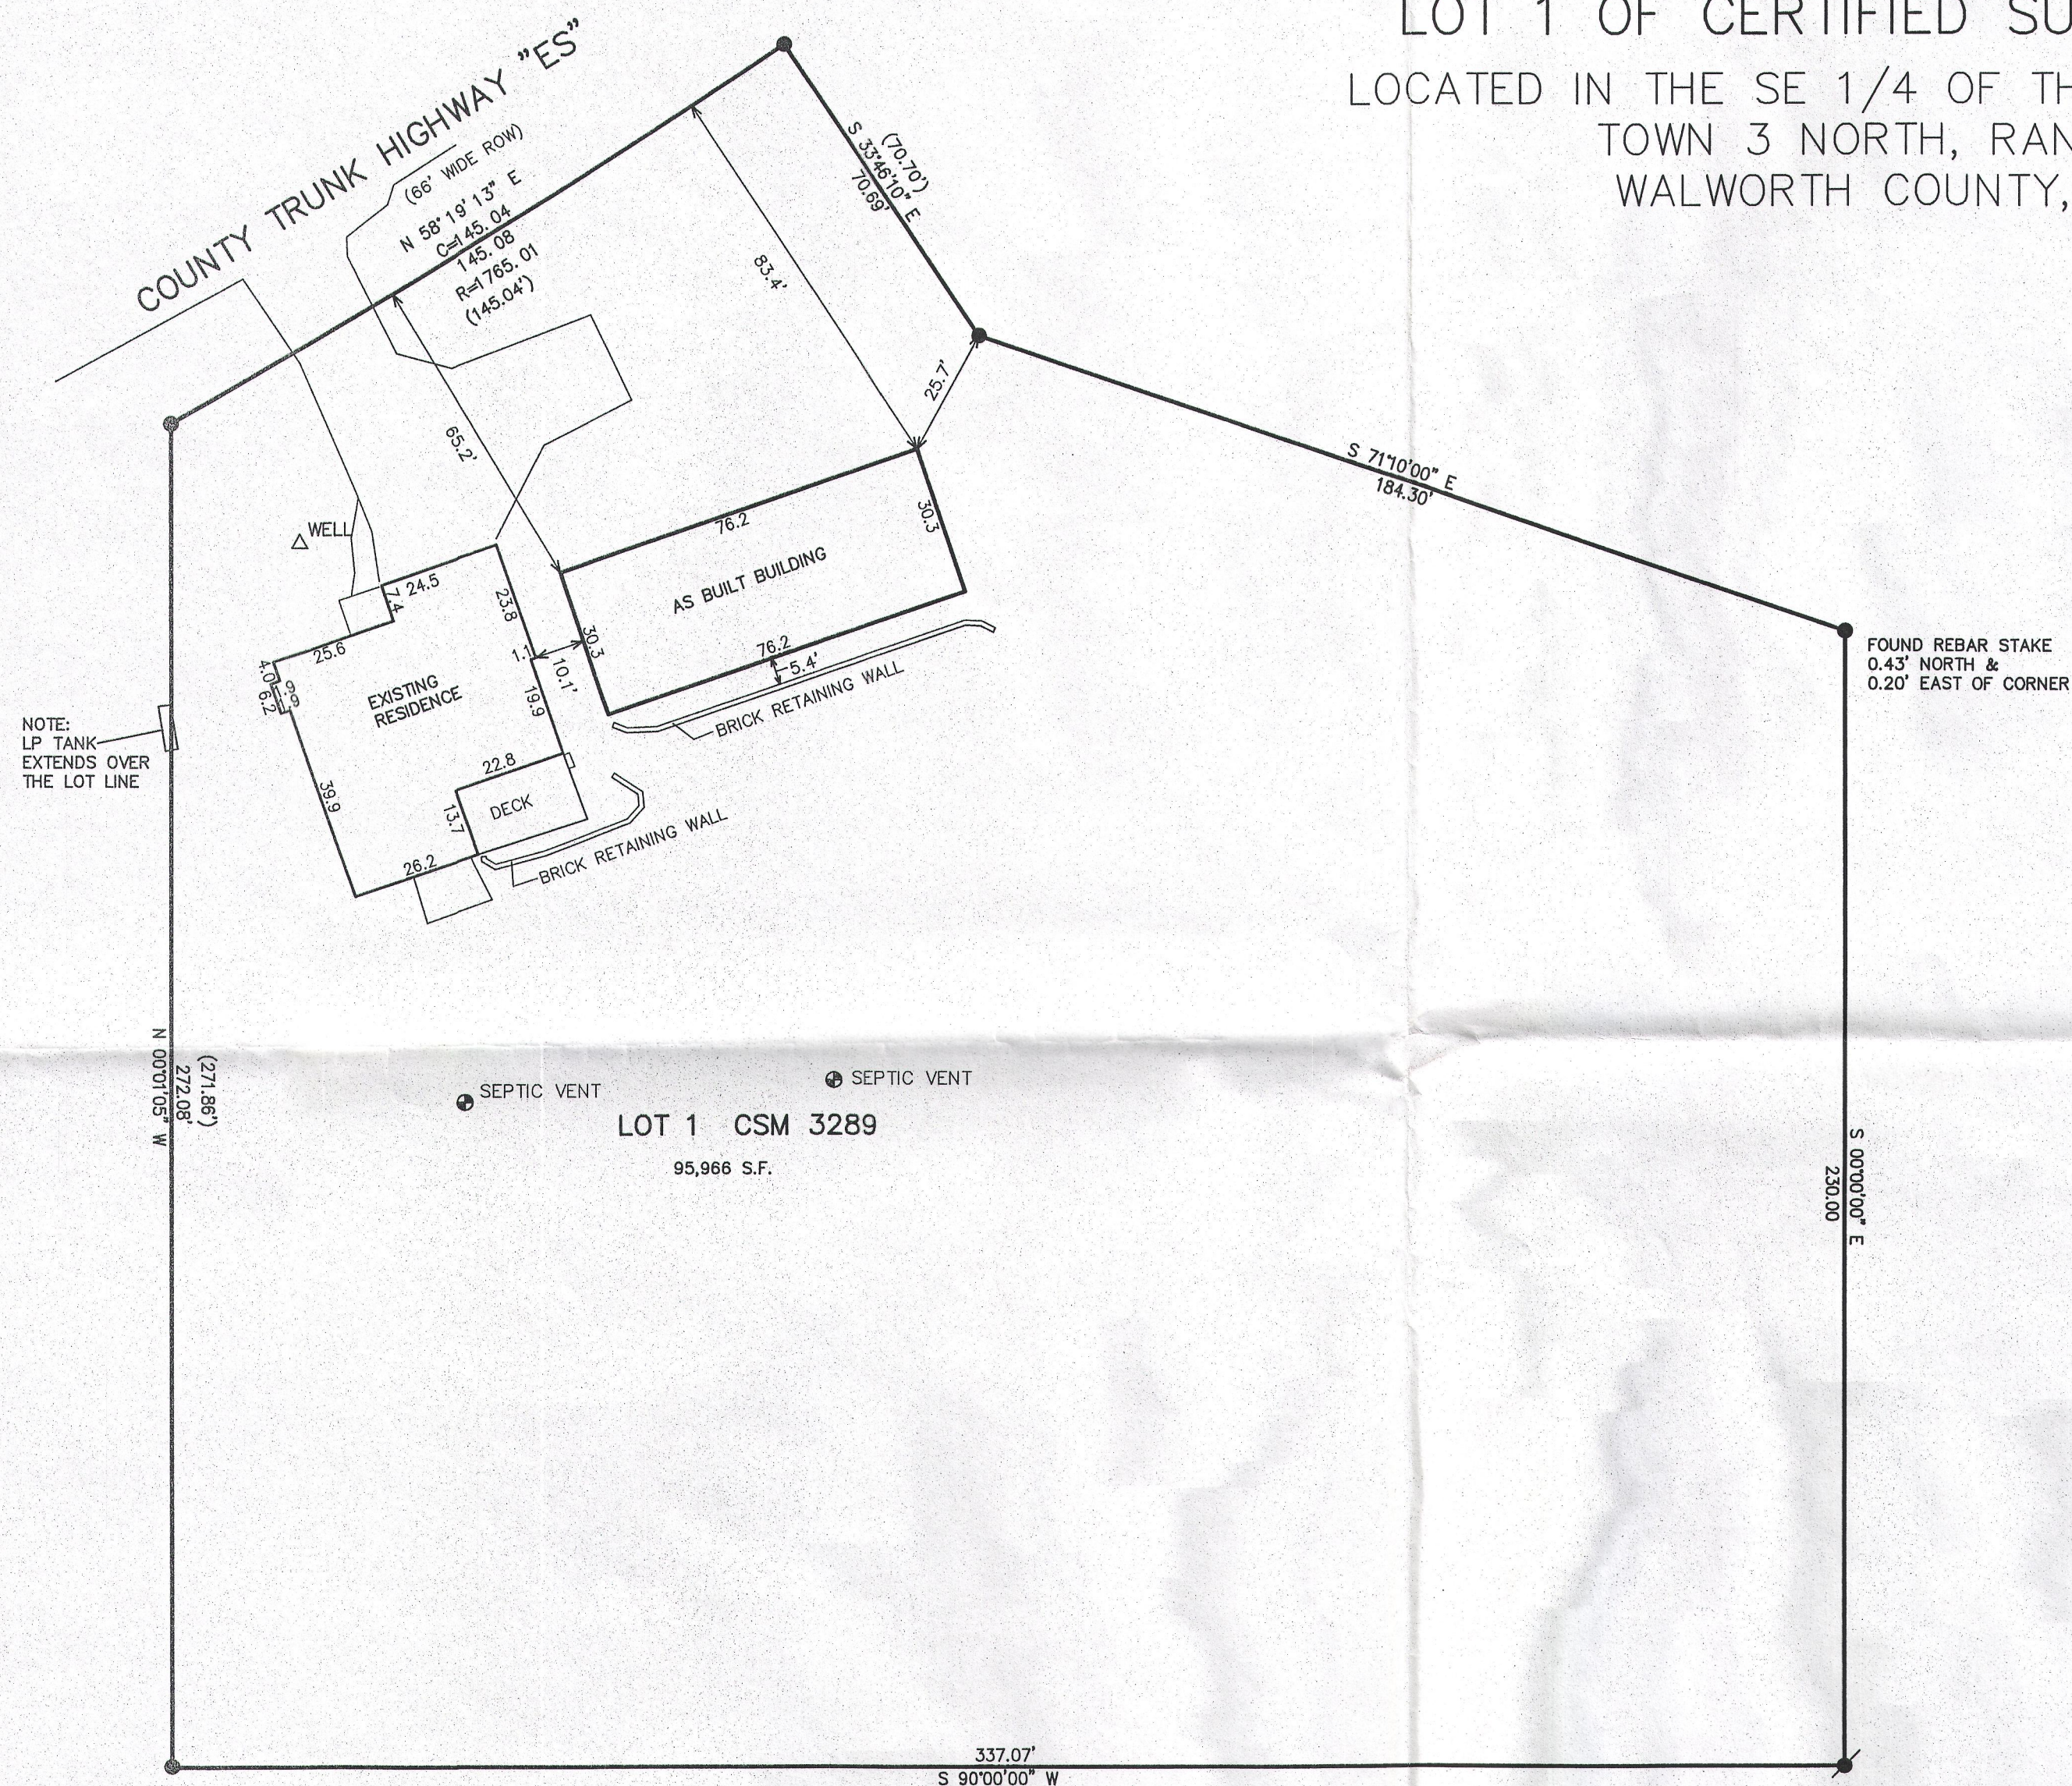

PLAT OF SURVEY

LOT 1 OF CERTIFIED SURVEY MAP 3289

LOCATED IN THE SE 1/4 OF THE NW 1/4 SECTION 10
TOWN 3 NORTH, RANGE 17 EAST
WALWORTH COUNTY, WISCONSIN

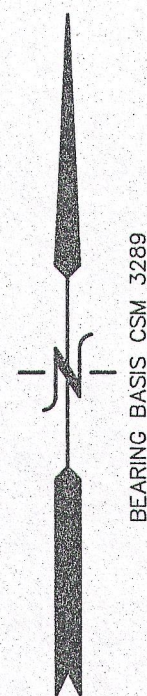



- LEGEND
- = FOUND IRON REBAR STAKE
 - ⦿ = SET IRON REBAR STAKE
 - (XXX) = MEASURED DISTANCE 2016

NOTE: COPIES OF THIS MAP TO WHICH THE FOLLOWING CERTIFICATE WILL APPLY SHOW THE SURVEYOR'S ORIGINAL SEAL AND SIGNATURE IN RED INK. COPIES BY ANY OTHER MEANS MAY HAVE ALTERATIONS WHICH DO NOT REPRESENT THE SURVEYOR'S WORK PRODUCT.

I HEREBY CERTIFY THAT THE ABOVE DESCRIBED PROPERTY HAS BEEN SURVEYED UNDER MY DIRECTION AND THAT THE ABOVE MAP IS A TRUE REPRESENTATION THEREOF AND SHOWS THE SIZE AND LOCATION OF THE PROPERTY AND ITS EXTERIOR BOUNDARIES. THIS SURVEY IS MADE FOR THE USE OF THE PRESENT OWNERS OF THE PROPERTY, AND ALSO THOSE WHO PURCHASE, MORTGAGE, OR GUARANTEE THE TITLE THERETO WITHIN ONE YEAR FROM THE DATE HEREOF.

DATED: DECEMBER 1, 2016

Peter S. Gordon
PETER S. GORDON P.L.S. 2101

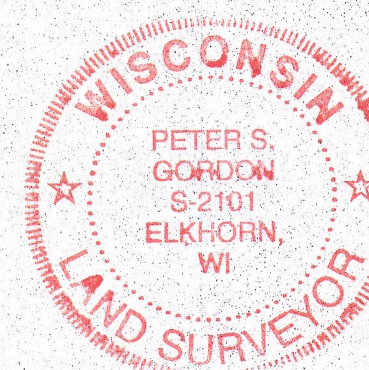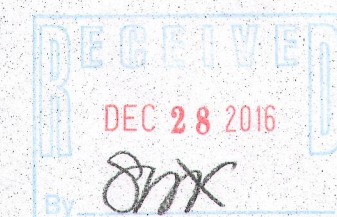

WORK ORDERED BY:
MIKE PORTER
W 3599 CTY RD ES
ELKHORN, WI. 53121

FARRIS, HANSEN & ASSOCIATES, INC.
ENGINEERING - ARCHITECTURE - SURVEYING
7 RIDGWAY COURT P.O. BOX 437
ELKHORN, WISCONSIN 53121
OFFICE: (262) 723-2098 FAX: (262) 723-5886

REVISIONS

PROJECT NO.
5545.16
DATE:
08-22-2016
SHEET NO.
1 OF 1

DEC 01 2016

X:\Projects\5545\5545_16\DCAD\SURVEY LOT1

KA3289-1

317 1035