


Plat of Survey


Unit 21 of Phase 2 of Rolling Green Country Estates,

a condominium located in the Southeast 1/4 of Section 18, Town 3 North, Range 17 East, Town of LaFayette, Walworth County, Wisconsin.

Surveyed for: Ryan & Kristen Servais
N5645 Townline Road
Elkhorn, Wisconsin. 53121

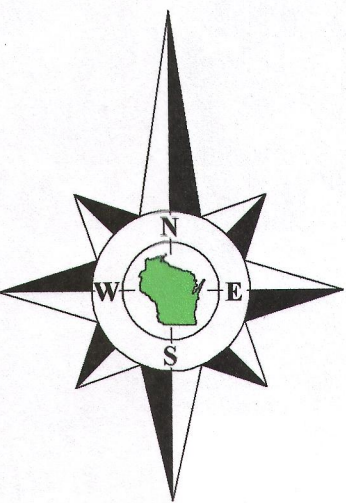

Bearings reference to the plat of Rolling Green Country Estates.

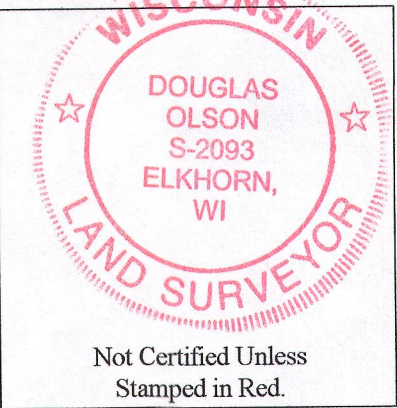

- Notes:
- 1) This survey plat is not certified unless signed and sealed in red ink.
 - 2) This survey is subject to Wisconsin lien laws. This Plat of Survey is the notice of intent to file lien. Lien waiver required.

Copyright 2016 by Olson Land Surveying, LLC.

All rights reserved. No part of this survey plat may be reproduced or transmitted in any form by any means - graphic, electronic, or mechanical, including photocopying, tracing, or information storage and retrieval systems - without permission in writing from Douglas G. Olson, Olson Land Surveying, LLC.

I, Douglas G. Olson, Wisconsin Professional Land Surveyor, do hereby certify that this survey was performed by me, or under my direction in full compliance with the owner's/agent's instructions and Chapter A-E 7 of the Wisconsin Administrative Code "Minimum Standards for Property Surveys"; and that this map is an accurate representation thereof to the best of my knowledge and belief.

Douglas G. Olson
Wisconsin Professional Land Surveyor - 2093

Unit 20

Unit 21
Tax Parcel
KRG 00021
0.632 Acre
27,532 Sq.Ft.

Poured Concrete Foundation
W4648

Base for Driveway

Pebble Drive
(66' Wide)

Unit 22

Tax Parcel
KLF 1800004P

Survey Date: November 22, 2016.
Revisions: No. 1 - 100d spikes set in excavation
No. 2 - Poured Concrete Foundation

Scale in Feet
1" = 20'
0 10' 20' 40'

Olson Land Surveying, LLC
45 South Wisconsin Street * P.O. Box 322 * Elkhorn, Wisconsin. 53121
Telephone: (262) 723-3434 * Facsimile: (262) 723-8044
Email: doug@olsonsurveying.com

Legend
Found Iron Pipe
Found Iron Rod
Set Wood Stake
Recorded Information
Utility Pedestal
PVC Pipe
Asphalt Surface
Gravel

Sheet 1 of 1 Sheets
Drawing Name:
Job Reference Number
2016.129

2016.129

KRG-21 317-1046