
PLAT OF SURVEY -OF-

LOT 15, BLOCK 1, ALPINE TOWER ESTATES, A SUBDIVISION LOCATED IN PART OF THE NORTHEAST 1/4 OF SECTION 13, TOWN 3 NORTH, RANGE 17 EAST OF THE FOURTH PRINCIPAL MERIDIAN, TOWN OF LAFAYETTE, COUNTY OF WALWORTH AND STATE OF WISCONSIN.

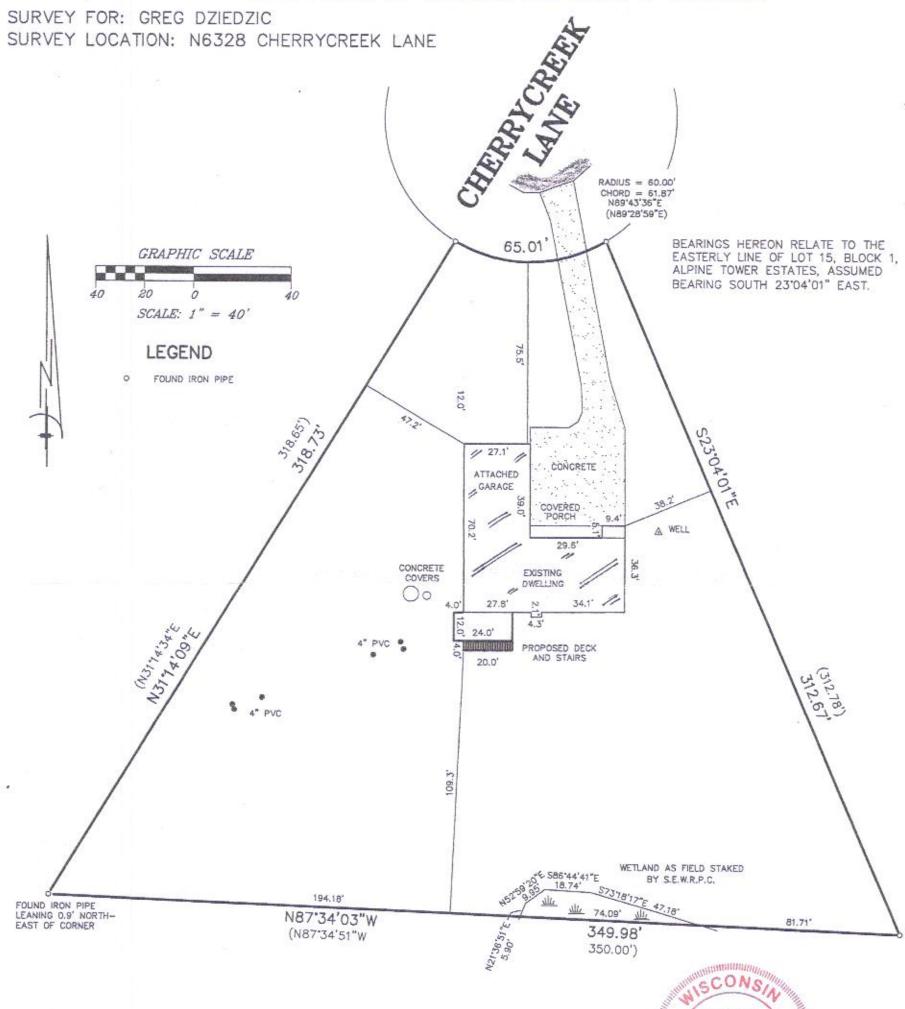

"I hereby certify that I have surveyed the above described property and that the above map is a correct representation thereof and shows the size and location of the property, its exterior boundaries, the location of all visible structures and dimensions of all principal buildings thereon, boundary fences, apparent easements, roadways and encroachments, if any."

"This survey is made for the use of the present owners of the property, and those who purchase, mortgage, or guarantee the title thereto within one year from date hereof."





THIS IS NOT AN ORIGINAL PRINT UNLESS THIS SEAL IS RED.



B.W. SURVEYING, INC.

LAND SURVEYS
MAPPING AND PLANNING
412 N. PINE STREET
BURLINGTON, WI 53105
(262)-767-0225

ROBERT J. WETZEL S S-1778

NOVEMBER 6, 2017 DATE

9497 JOB NUMBER