## LAND-MARK SURVEYING Mark L. Miritz

Wisconsin Professional Land Surveyor S-2582

N9330 Knuteson Drive Whitewater, WI 53190 Phone:(262)495-3284 MARKMIRITZ@ LAND-MARKSURVEYING.COM

**ORDERED BY: LAKE GENEVA AREA REALTY** 101 BROAD ST., SUITE C3 **LAKE GENEVA, WI 53147** 


**LAND SURVEYOR S-2582** 

JOB NO. 19.203

DATE: FEB. 21, 2019

## SURVEY

Lot 14, of Ridgeview Estates, being a Subdivision of a part of the Northwest 1/4 and Southwest 1/4 of the Northeast 1/4 of Section 19, Town 3 North, Range 17 East. Said land being in the Town of LaFayette, County of Walworth, State of Wisconsin.

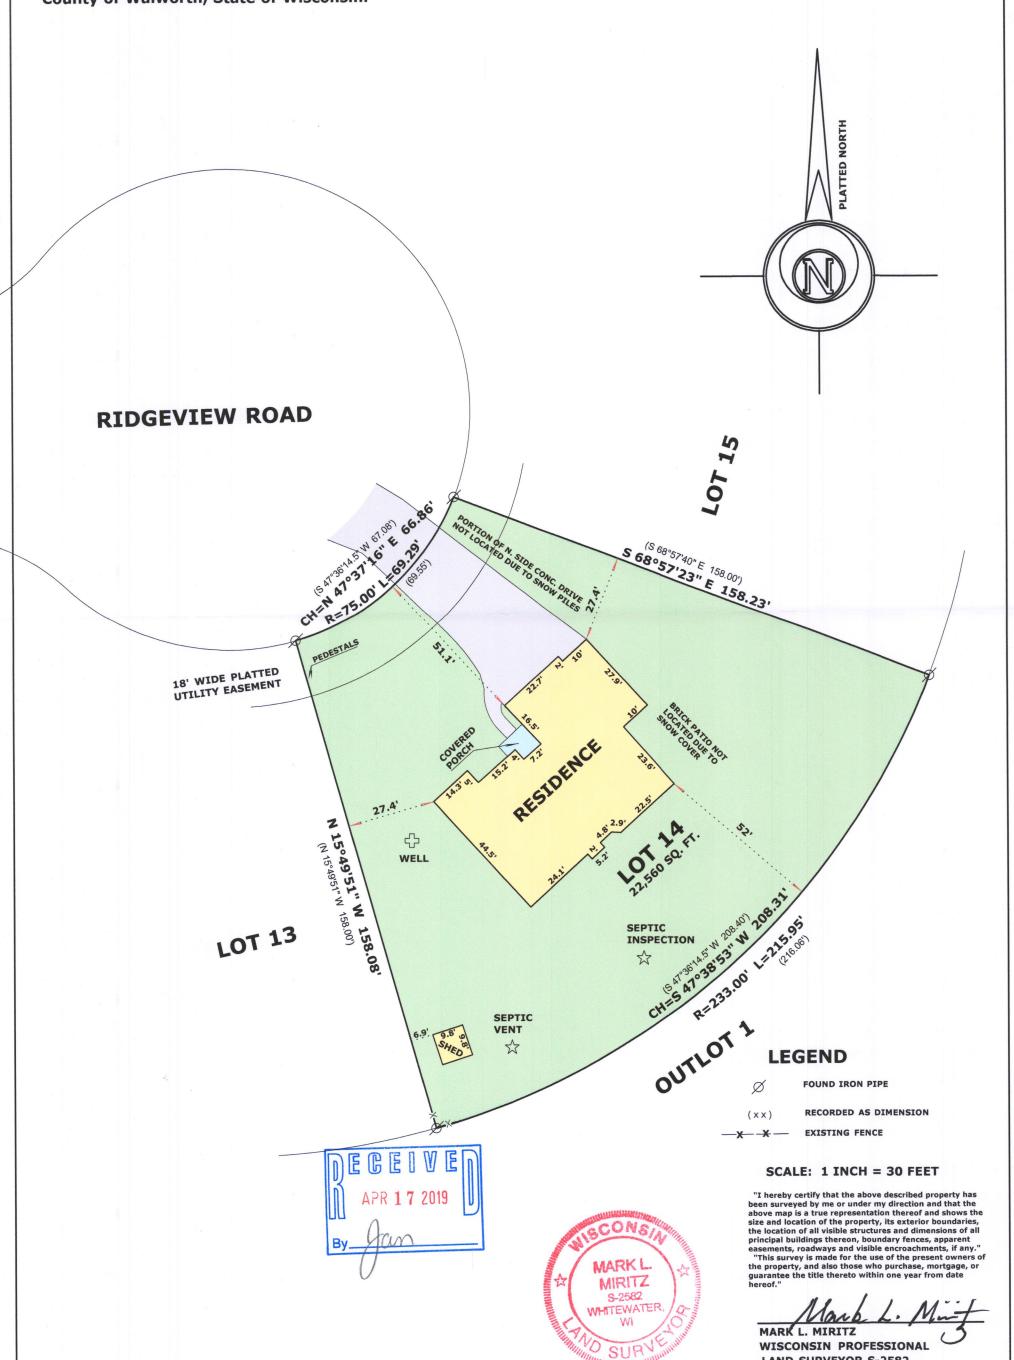

KRID-14

317-1096