


PLAT OF SURVEY

OF UNIT 40, PHASE 2, ROLLING GREEN COUNTRY ESTATES,
A CONDOMINIUM BEING PART OF THE SE 1/4 AND SW 1/4
OF SECTION 18, T. 3 N., R. 17 E., OF THE 4TH P.M., TOWN OF
LAFAYETTE, WALWORTH COUNTY, WISCONSIN.

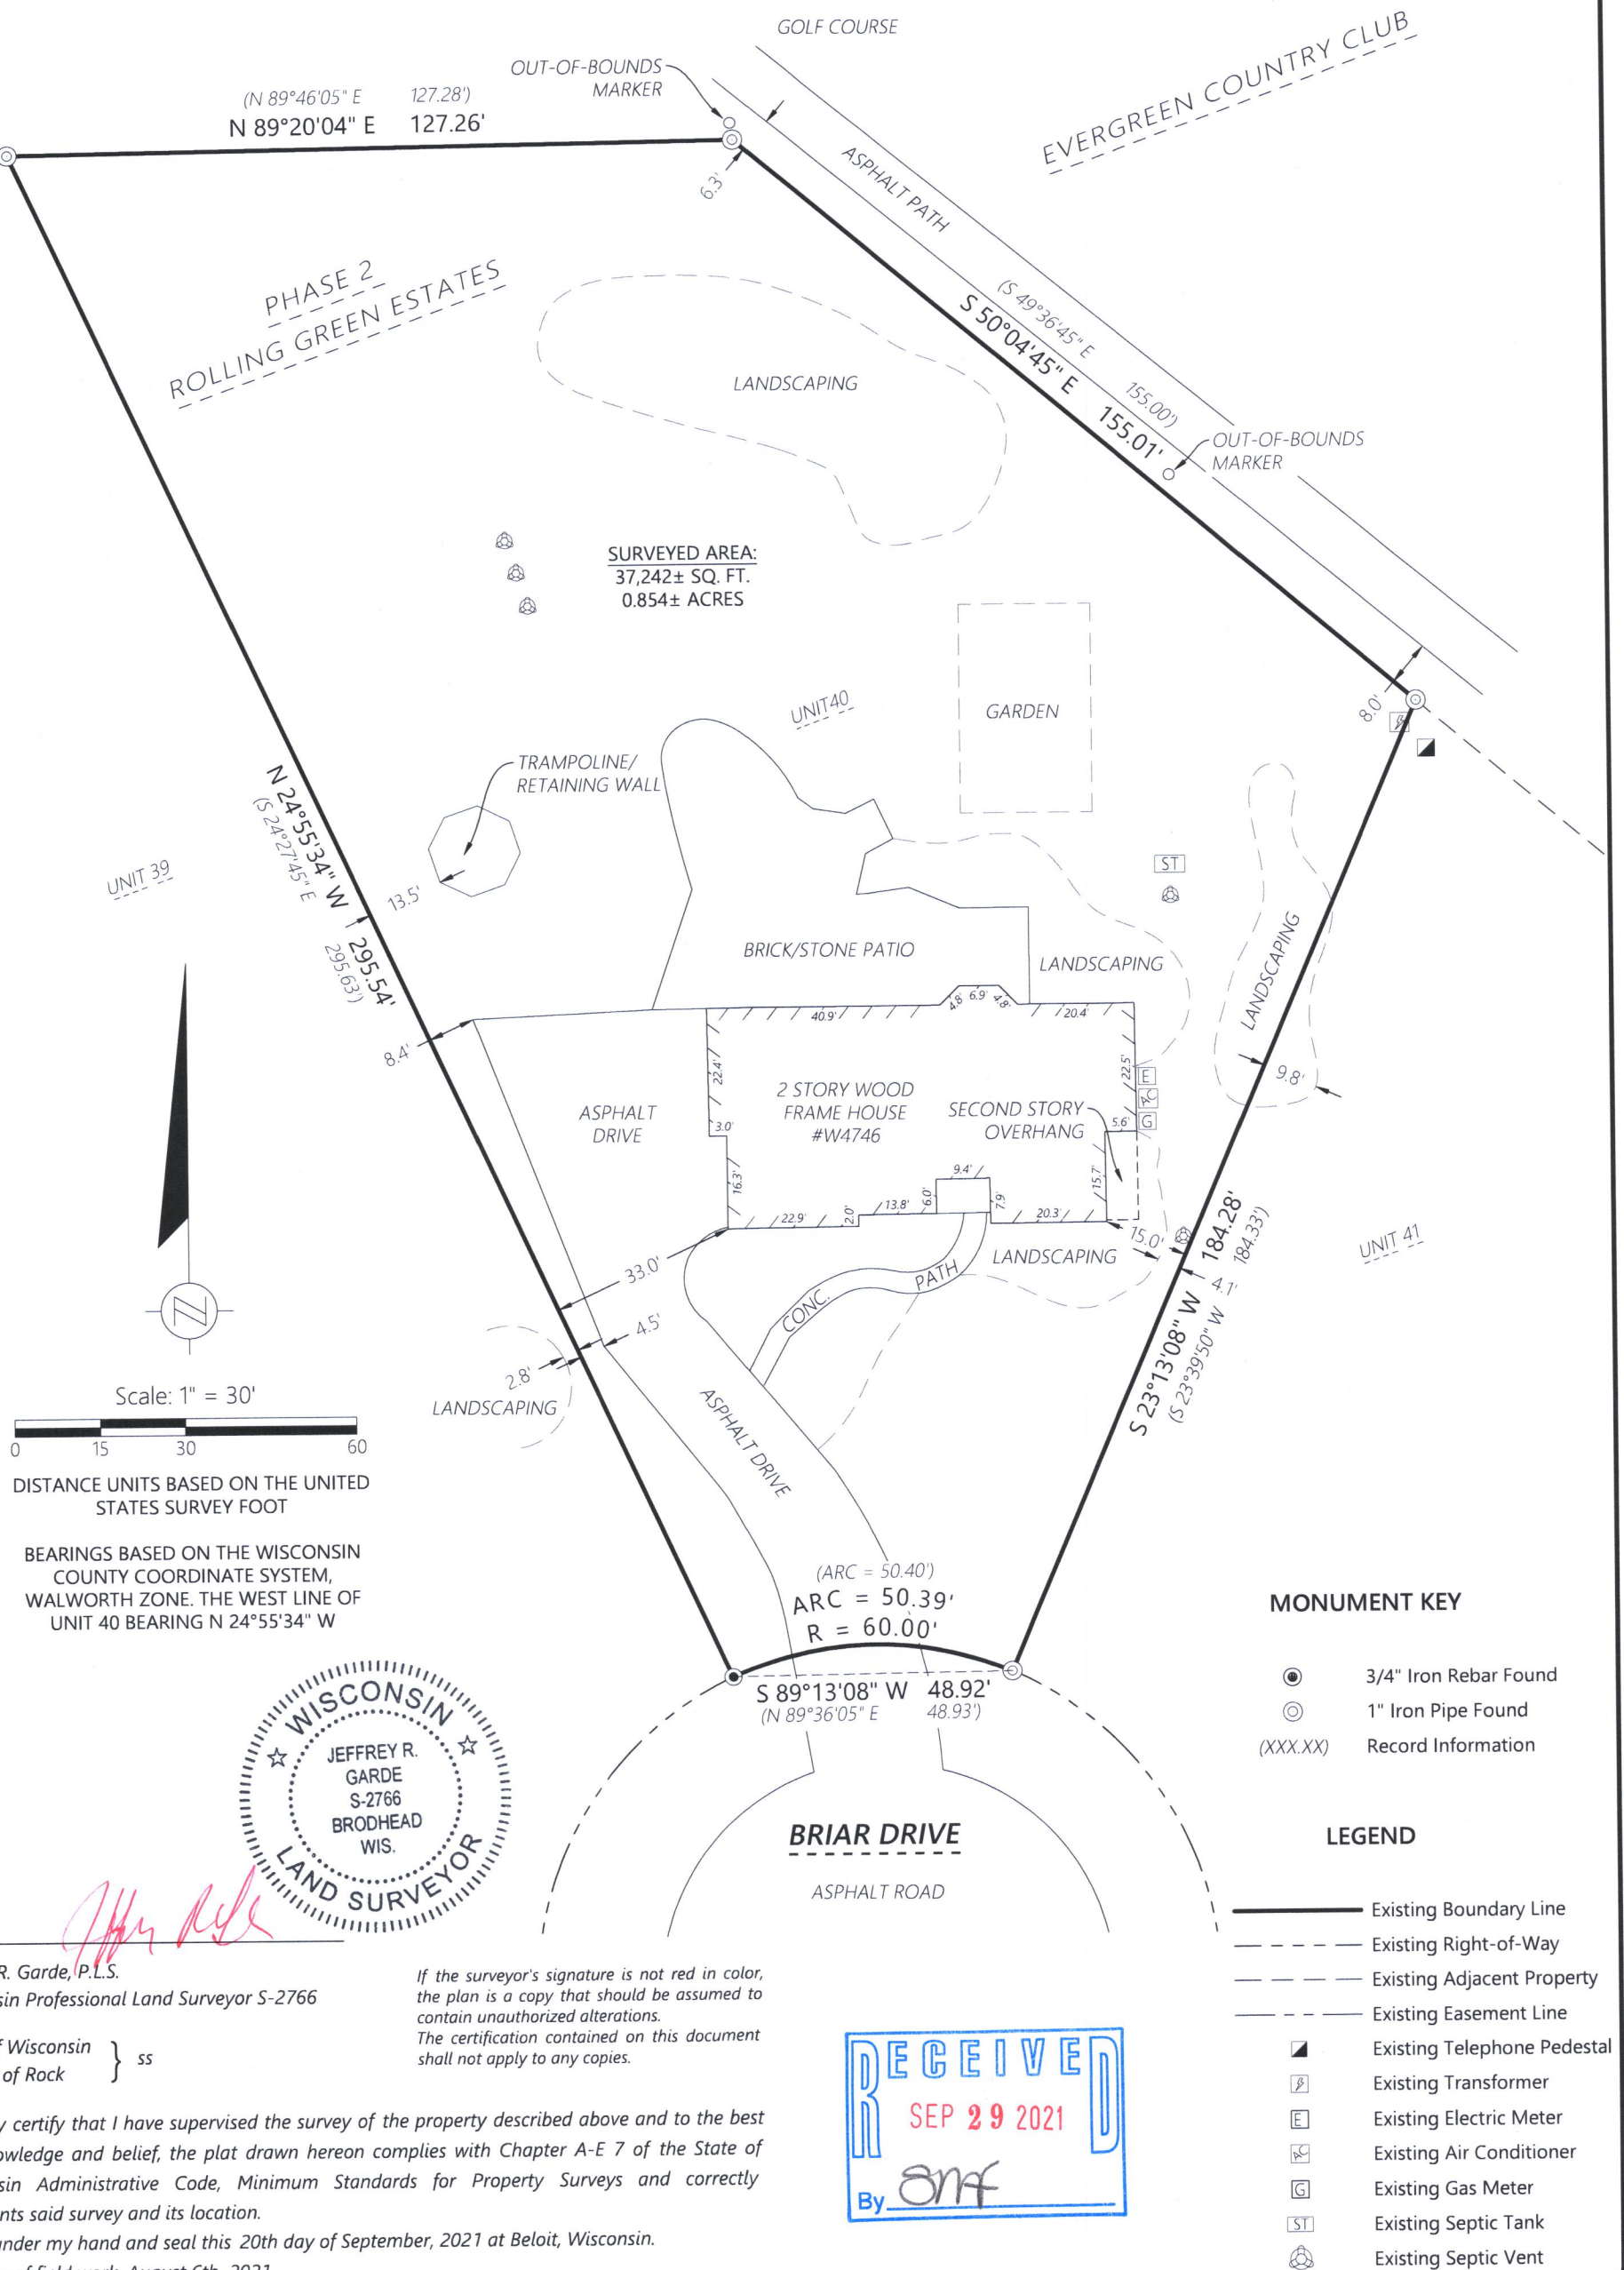

Jeffrey R. Garde, P.L.S.
Wisconsin Professional Land Surveyor S-2766

State of Wisconsin } ss
County of Rock

I hereby certify that I have supervised the survey of the property described above and to the best my knowledge and belief, the plat drawn hereon complies with Chapter A-E 7 of the State of Wisconsin Administrative Code, Minimum Standards for Property Surveys and correctly represents said survey and its location.

Given under my hand and seal this 20th day of September, 2021 at Beloit, Wisconsin.

Last day of field work August 6th, 2021

If the surveyor's signature is not red in color, the plan is a copy that should be assumed to contain unauthorized alterations. The certification contained on this document shall not apply to any copies.

ORDER NO: 34003

FIELD CREW: ROW
DRAWN BY: DJE
SHEET 1 OF 1

FOR THE EXCLUSIVE USE OF:

Eric Rybski
W4746 Briar Drive
Elkhorn, WI 53121

PLAT OF SURVEY

Batterman
engineers surveyors planners

2857 Bartells Drive Beloit, Wisconsin 53511
608.365.4464 www.rhbatterman.com

