

FARRIS, HANSEN & ASSOCIATES, INC.


7 RIDGEWAY COURT, P.O. BOX 487, ELKHORN, WISCONSIN

TEL. 414-723-2098



LOCATION: LOT 138 OF EVERGREEN ESTATES  
IN SEC 13, T3N, R17E, WALWORTH CO WI.

WORK ORDERED BY: ERSKINE CONSTRUCTION

10 0 10 20 30 40 50 60 70 80 90 100  
MAP SCALE IN FEET

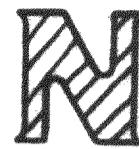

MAP LEGEND  
 O = IRON PIPE STAKE FOUND  
 = IRON PIPE STAKE SET  
 ● = IRON ROD STAKE FOUND  
 = IRON ROD STAKE SET  
 O = CONCRETE MONUMENT FOUND  
 (XXXXX) = RECORD DIMENSION

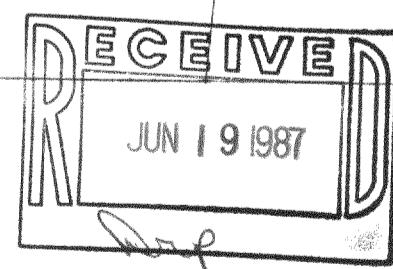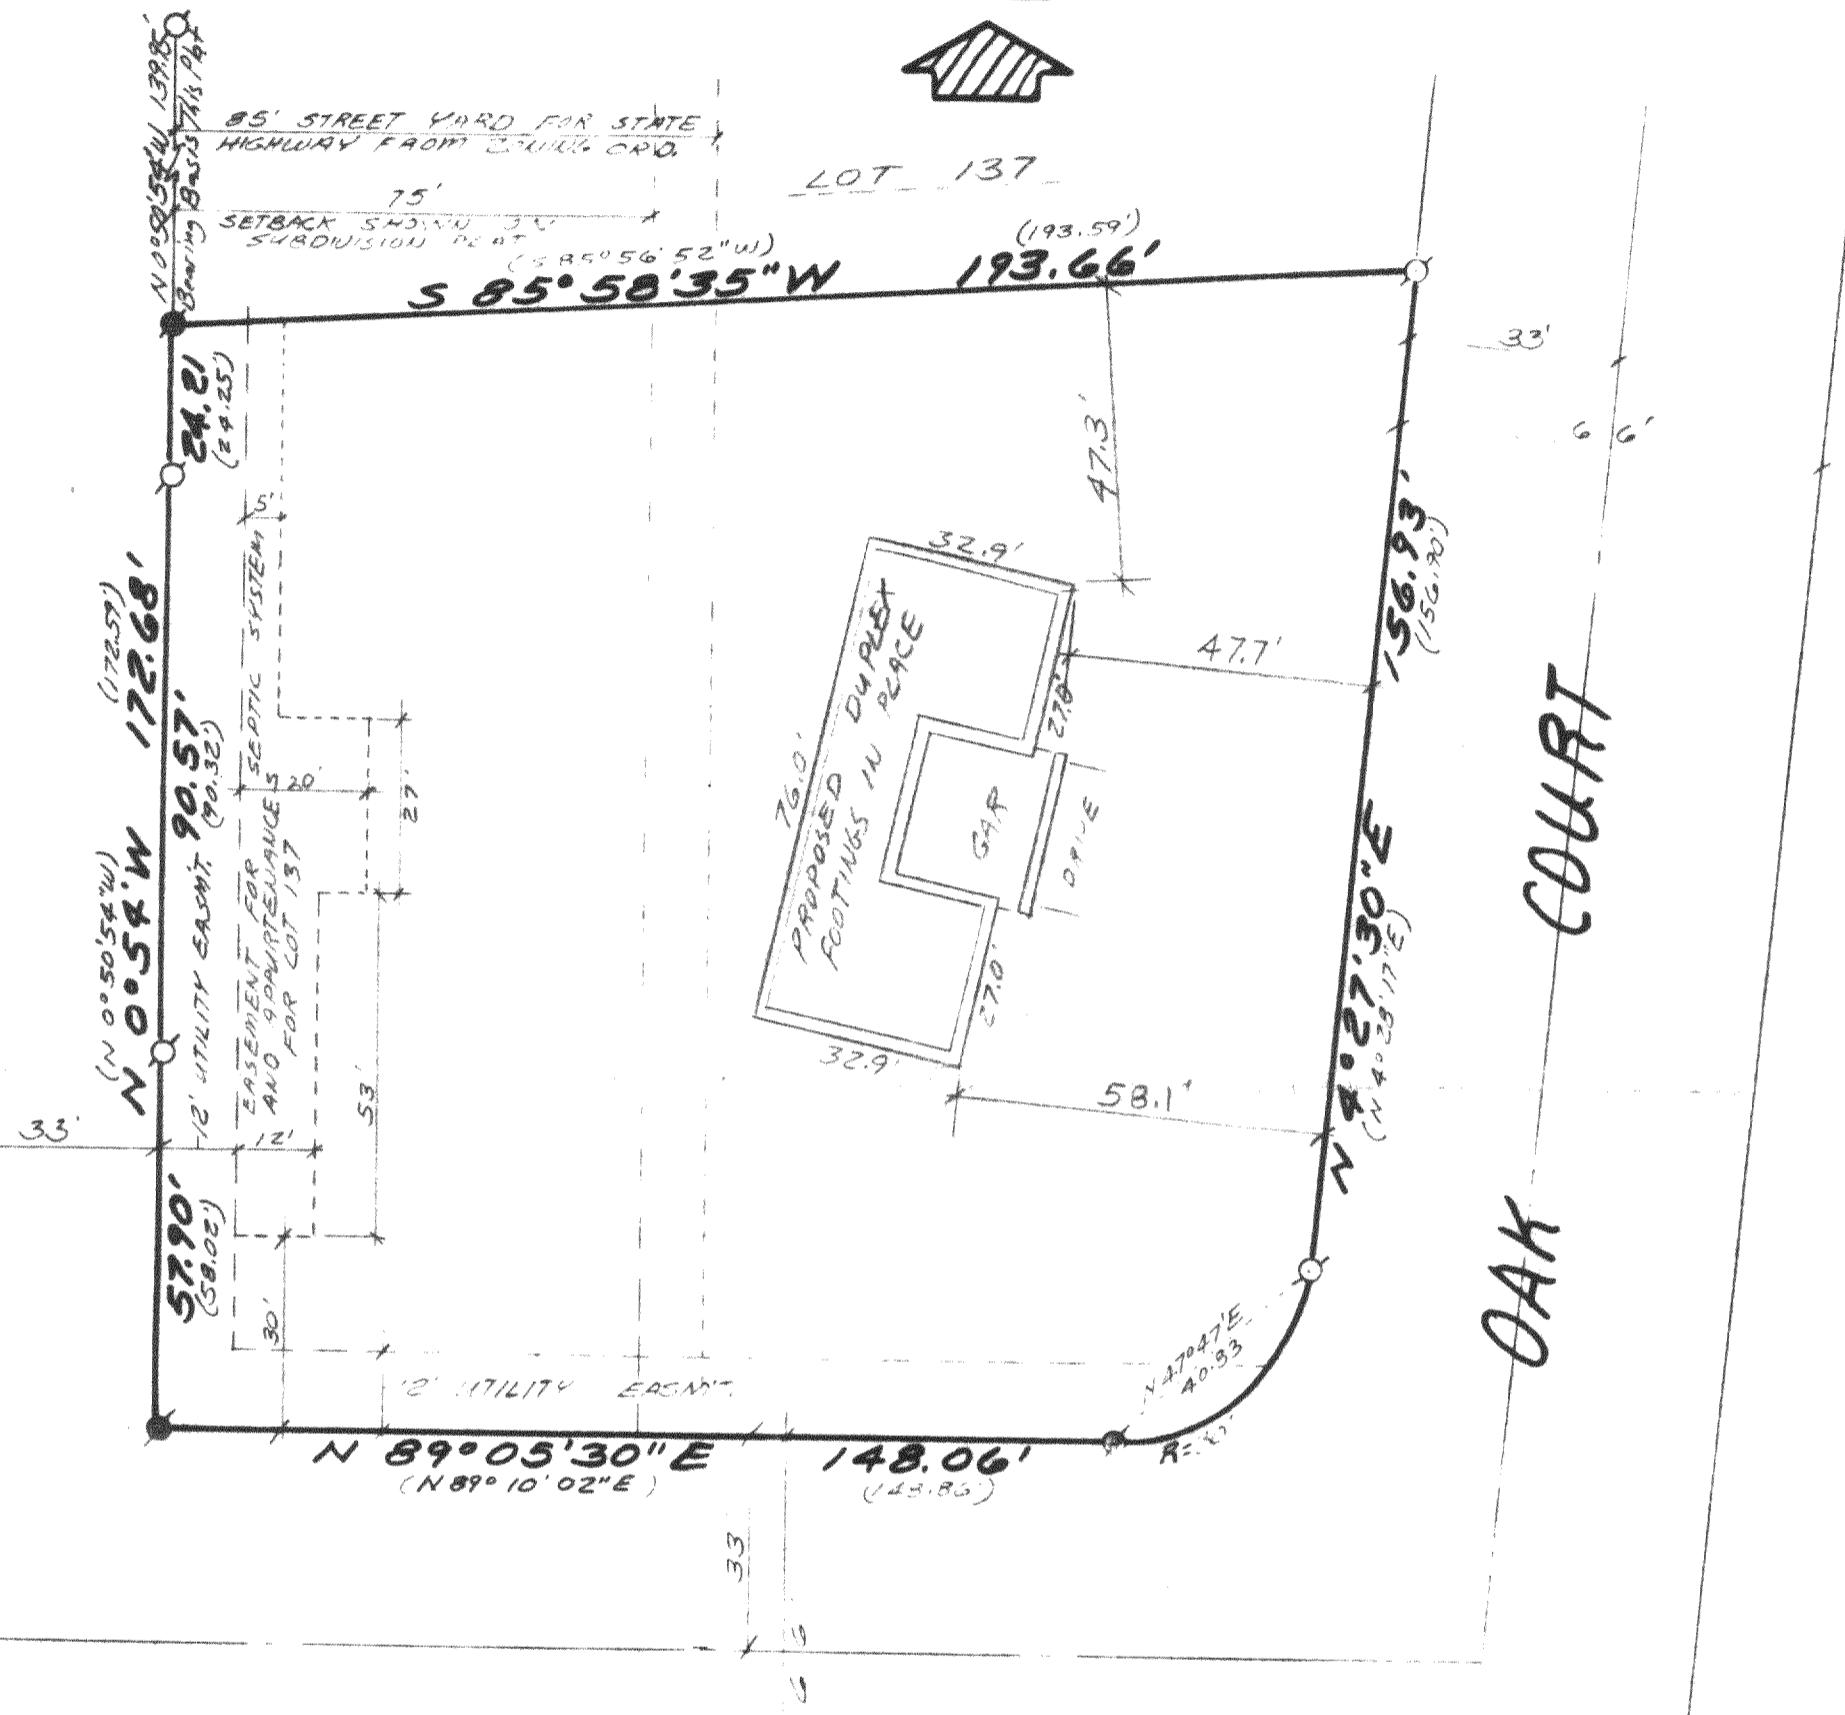

I hereby certify that the above described property has been surveyed under my direction and that the above map is a true representation thereof and shows the size and location of the property, its exterior boundaries, the location of all visible structures and dimensions of all principal buildings thereon, boundary fences, apparent easements, roadways and visible encroachments, if any. This survey is made for the use of the present owners of the property, and also those who purchase, mortgage, or guarantee the title thereto within one year from the date hereof.

DATED : JUNE 9, 1987

REVISED: JUNE 17, 1987 TO LOCATE EXISTING FOOTINGS & SEPTIC EASMT.

PROJ. NO. 2823

*Robert J. Farris*