


KOLB LAND CONSULTING, INC.
LAND SURVEYING • SUBDIVIDING • LAND PLANNING

929 WILLIAMS STREET

LAKE GENEVA, WISCONSIN 53147

414-248-3697

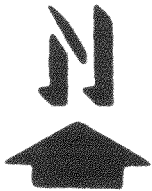


SCALE: 1" = 200'

LEGEND

Ø - IRON PIPE FOUND


ORDERED BY: KEN PLUESS %
MAIN STREET REALTY, INC.
2874 MAIN STREET
EAST TROY, WI. 53128

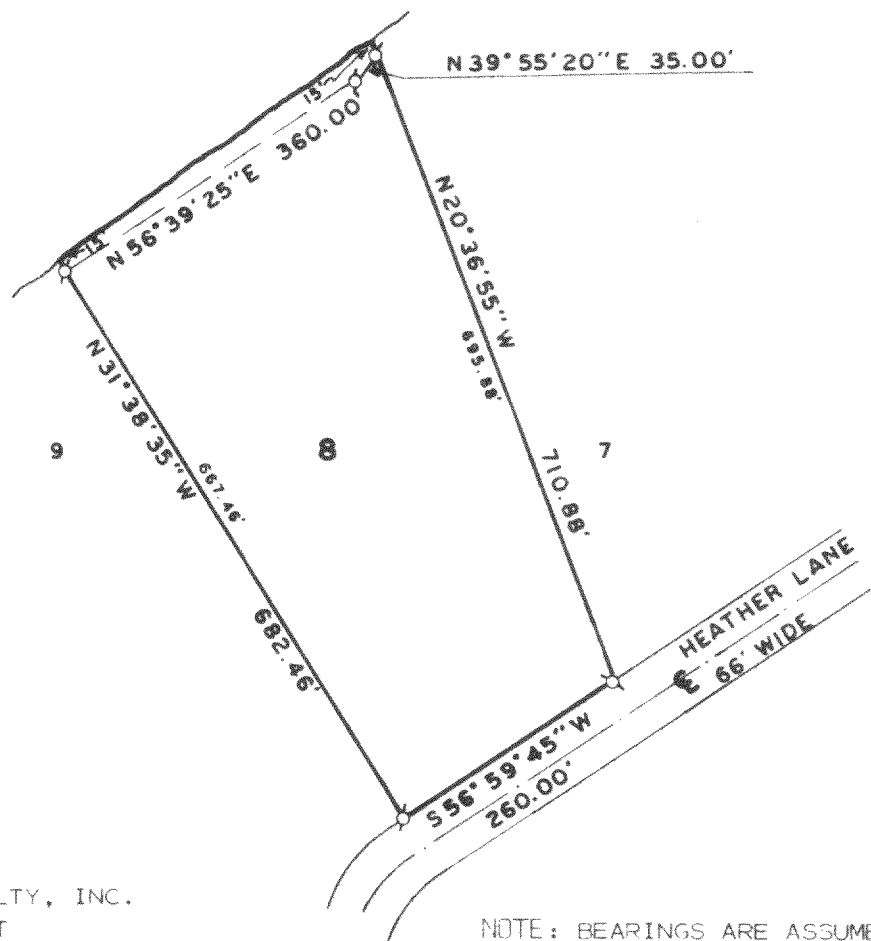

NOTE: BEARINGS ARE ASSUMED AS
SHOWN ON EXISTING SURVEY
RECORDS.

PLAT OF SURVEY OF

LOT 8 OF HEATHERWOOD SUBDIVISION, LOCATED IN THE
SOUTHEAST 1/4 OF SECTION 4, T3N, R17E, TOWN OF
LAFAYETTE, WALWORTH COUNTY, WISCONSIN.

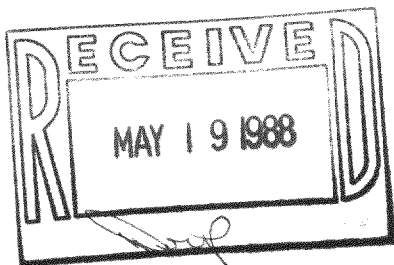

I, HAROLD H. KOLB, DO HEREBY CERTIFY
THAT I HAVE SURVEYED THE PROPERTY
HEREON DESCRIBED ACCORDING TO THE
OFFICIAL RECORDS AND THAT THE PLAT
HEREON IS A CORRECT REPRESENTATION
OF THE LOT LINES TO THE BEST OF MY
KNOWLEDGE AND BELIEF.
SURVEY NOT VALID UNLESS SURVEYOR'S
SIGNATURE IS IN RED.

HAROLD H. KOLB

WISCONSIN REGISTERED LAND SURVEYOR, S-187

DATE AUGUST 6, 1987

REVISED _____

REVISED _____