

WALWORTH COUNTY  
SURVEYING & MAPPING  
LAKE GENEVA, WISCONSIN

MISTY MOORS COURT

LOT 1

FOUNDATION

66'

N4°53'10"W 92.11'

64.5'

24'

9'

23.5'

52'

28.1'

25.3'

13.7'

17.4'

22'

33.7'

33.7'


N85°06'50"E 340.95'

SCOTCH HEATHER LANE


66'

PLAT OF SURVEY OF

A FOUNDATION LOCATION ON LOT 1 OF CERTIFIED  
SURVEY MAP NO. 830, LOCATED IN SECTION 4,  
T 3 N, R 17 E, WALWORTH COUNTY, WISCONSIN.

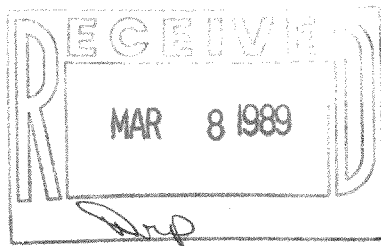

ORDERED BY: KEN WELNITZ  
1001 HWY. 14 NORTH  
JANESVILLE, WISCONSIN  
53545

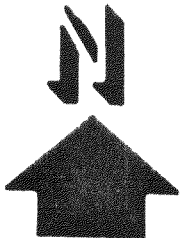

SCALE: 1" = 30'

Ø = IRON PIPE FOUND

I, ROBERT M. BAERENWALD, DO HEREBY CERTIFY THAT I  
HAVE SURVEYED THE PROPERTY HEREON DESCRIBED ACCORDING  
TO THE OFFICIAL RECORDS AND THAT THE PLAT HEREON IS A  
CORRECT REPRESENTATION OF THE PROPERTY LINES TO THE  
BEST OF MY KNOWLEDGE AND BELIEF.

Robert M. Baerenwald  
ROBERT M. BAERENWALD  
WISCONSIN REGISTERED LAND SURVEYOR, S-1508

Dec. 20, 1988  
DATE JOB NO. 1796

NOTE: THIS IS NOT A CERTIFIED COPY UNLESS SEALED.

317-168