

Farris, Hansen & Associates, Inc.

7 RIDGEWAY COURT, P.O. BOX 437, ELKHORN, WISCONSIN

TEL. 414-723-2098

LOCATION: Lot 36 Evergreen Country Club Estates
IN NW 1/4 Sec. 19, T. 3N., R. 17E.
Walworth County, WI.


WORK ORDERED BY:

John Smith Construction

MAP SCALE IN FEET

MAP LEGEND

- ⊗ - IRON PIPE STAKE FOUND
- IRON PIPE STAKE SET
- IRON ROD STAKE FOUND
- - IRON ROD STAKE SET
- CONCRETE MONUMENT FOUND
- (X) - RECORD DIMENSION

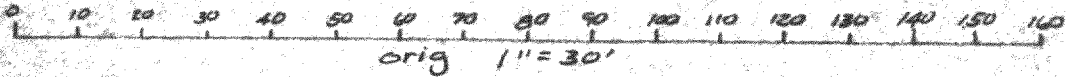


- Plat of Survey -

Lot 37

Lot 36

Lot 35

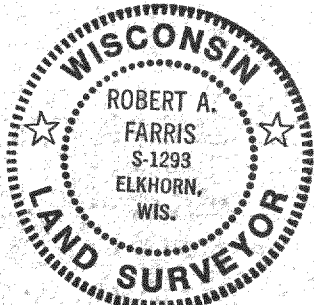

NOTE: COPIES OF THIS MAP TO WHICH THE FOLLOWING CERTIFICATE WILL APPLY ARE BLUE LINE PRINTS SHOWING SURVEYOR'S SEAL AND SIGNATURE IN BLACK INK. COPIES BY ANY OTHER MEANS MAY HAVE ALTERATIONS WHICH DO NOT REPRESENT THE SURVEYOR'S WORK PRODUCT.

I hereby certify that the above described property has been surveyed under my direction and that the above map is a true representation thereof and shows the size and location of the property, its exterior boundaries, the location of all visible structures and dimensions of all principal buildings thereon, boundary fences, apparent easements, roads and visible encroachments, if any. This survey is made for the use of the present owners of the property, and also those who purchase, mortgage, or guarantee the title thereto within one year from the date hereof.

317-178

KE-36

DATED :

Apr 24, 1989

Robert C. Jamis

PROJ. NO. 3197