


**Wisconsin Registered Land Surveyor S-1594**

**Rt. 3, Box 273**  
**Elkhorn, Wisconsin 53121**  
**Phone: (414) 723-4260 (office)**  
**(414) 723-4813 (residence)**





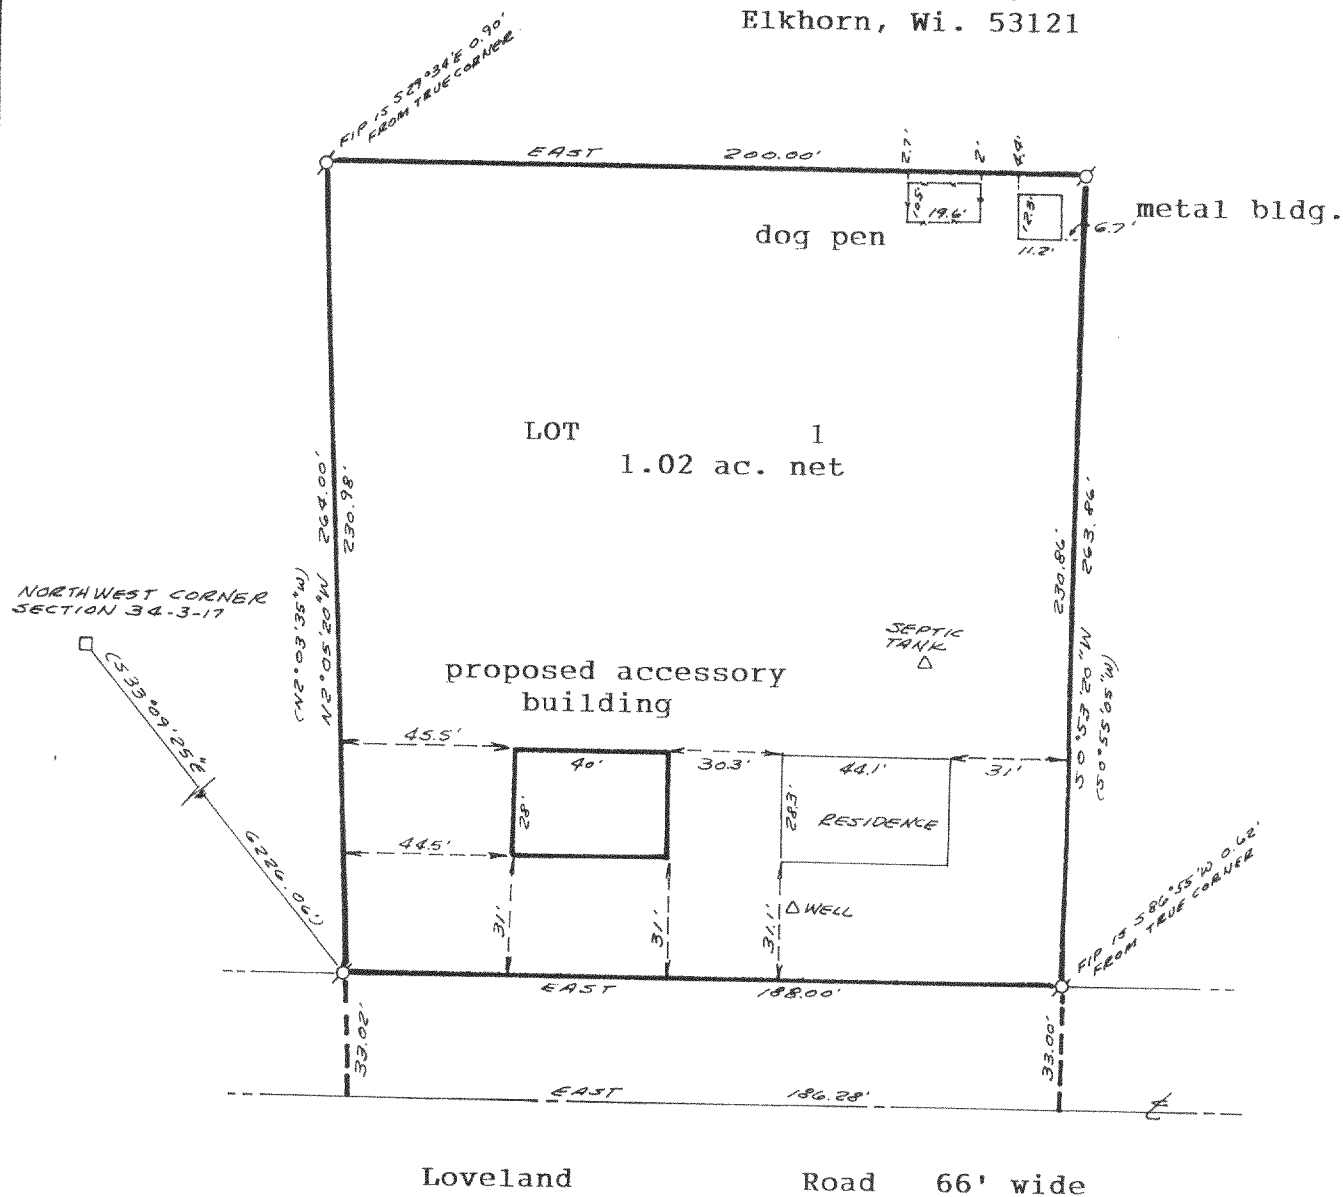


# PLAT OF SURVEY



LOT 1 OF CERTIFIED SURVEY MAP NO. 325, located in the west  $\frac{1}{2}$  of the Southeast  $\frac{1}{4}$  of Section 34, Town 3 North, Range 17 East, Walworth County, Wisconsin.

Ordered By: Ralph Joost  
Route 3 Box 299  
Elkhorn, Wi. 53121



### Legend

-  FOUND IRON PIPE  
 FOUND IRON ROD  
 FOUND BRASS CAPPED MONUMENT  
 FOUND CONCRETE MONUMENT  
 CHISEL CUT IN CONCRETE  
 SET IRON ROD, 24" LONG, WEIGHING  
 1.5 LBS./LINEAL FT., 3/4" DIA.  
 SET IRON ROD, 30" LONG, WEIGHING  
 4.5 LBS./LINEAL FT., 1-11/16" DIA.  
 (xx) RECORDED AS DIMENSION  
 —x—x— EXISTING FENCE

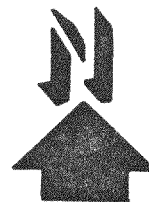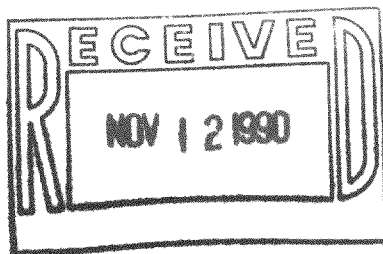

SCALE: 1" = 50 FEET


"I hereby certify that I have surveyed the above described property and that the above map is a true representation thereof and shows the size and location of the property, its exterior boundaries, the location of all visible structures and dimensions of all principal buildings thereon, boundary fences, apparent easements, roadways and visible encroachments, if any."

"This survey is made for the use of the present owners of the property, and also those who purchase, mortgage, or guarantee the title thereto within one year from date hereof."

Kenneth B. Abernathy  
ETH B. ABERNATHY JR

KENNETH B. ABERNATHY, JR.  
WISCONSIN REGISTERED LAND SURVEYOR,  
S-1594

Date: 7/28/90 Job No. 90.707

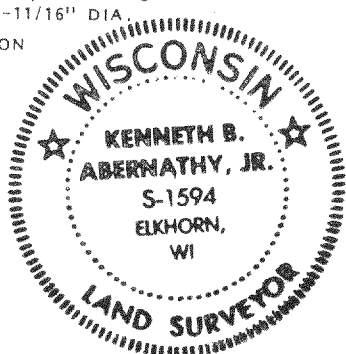

67-206

Tax Key  
KA-3250000