Plat of Survey



JAHNKE & JAHNKE ASSOCIATES INC.

Consultants in Engineering, Planning, Subdivisions and Surveying

711 W. MORELAND BLVD. -- WAUKESHA, WISCONSIN 53188

TELEPHONE (414) 542-5797

FOR: BIELINSKI BROS. BUILDERS, INC. RE: BAILEY

LEGAL DESCRIPTION: Lot 24, Block 2, ALPINE TOWER ESTATES, a subdivision located in part of the NE 1/4 of Section 13, T3N, R17E, of the 4th P.M. Town of Lafayette, Walworth County, Wisconsin.

Bench Mark 100.00 (Assumed Datum) Top of 8 inch telephone pedestal near NW lot corner. Existing Top of Foundation 100.08

97.3 - Existing elevation Suggested Residence Grade: Living Room Floor $\underline{101.0}^{\star}$

Garage Opening 99.38


Garage Floor 99.5±* 12/7/92 - Basement constructed

*suggested grade only

and located as shown.

NOTE: No iron pipes were placed at lot corner as part of this survey.

SURVEY CERTIFICATE: I have surveyed the above described property and the map shown is a true representation thereof and shows the size and location of the property, its exterior boundaries, the location and dimensions of all visible structures thereon, fences, apparent easements and roadways and visible encroachments if any. This survey is made for the exclusive use of the present owners of the property and also those who purchase, mortgage or guarantee the title thereto within one (1) year from date hereof and as to

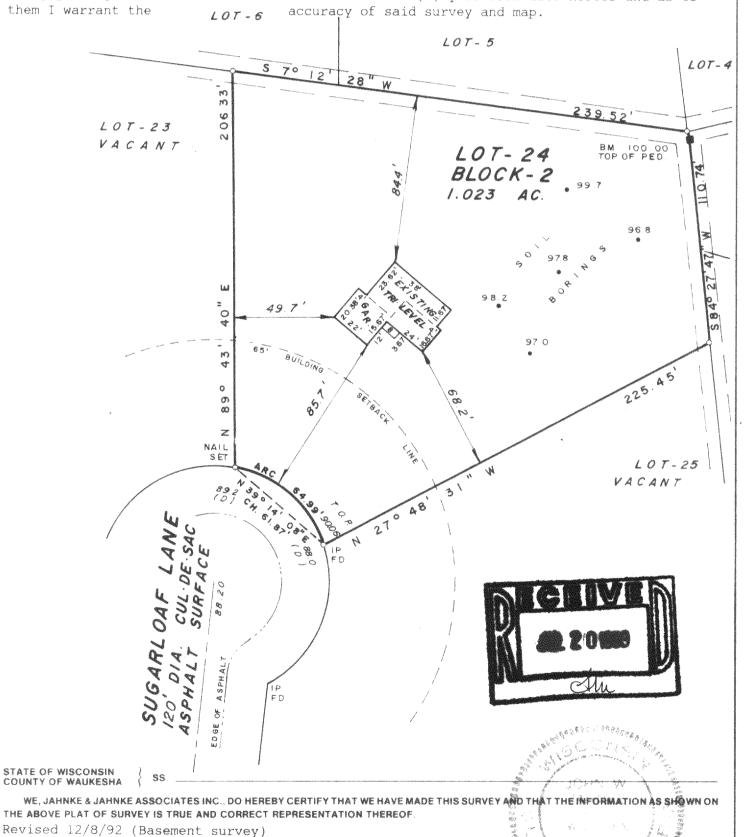

PAGE _19

KAT-46

DATED THIS 24th DAY OF September

PLAT No. P.S. Walworth 159 BOOK Walworth #6

RICHARD P. JAHNKE - WIS. Reg. No. \$-318

JOHN W. JAHNKE - Wie Neg. No. S-917