
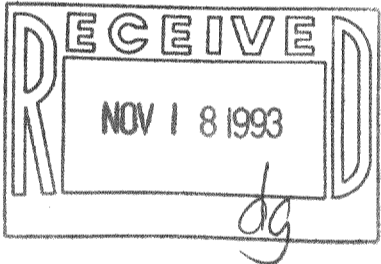


PLAT OF SURVEY
-OF-

LOT 2, CERTIFIED SURVEY MAP No. 1085, located in the Southwest 1/4 of the Southeast 1/4 of Section 21, Township 3 North, Range 17 East in the Town of Lafayette, Walworth County, Wisconsin.

Survey For: Paul Reiherzer


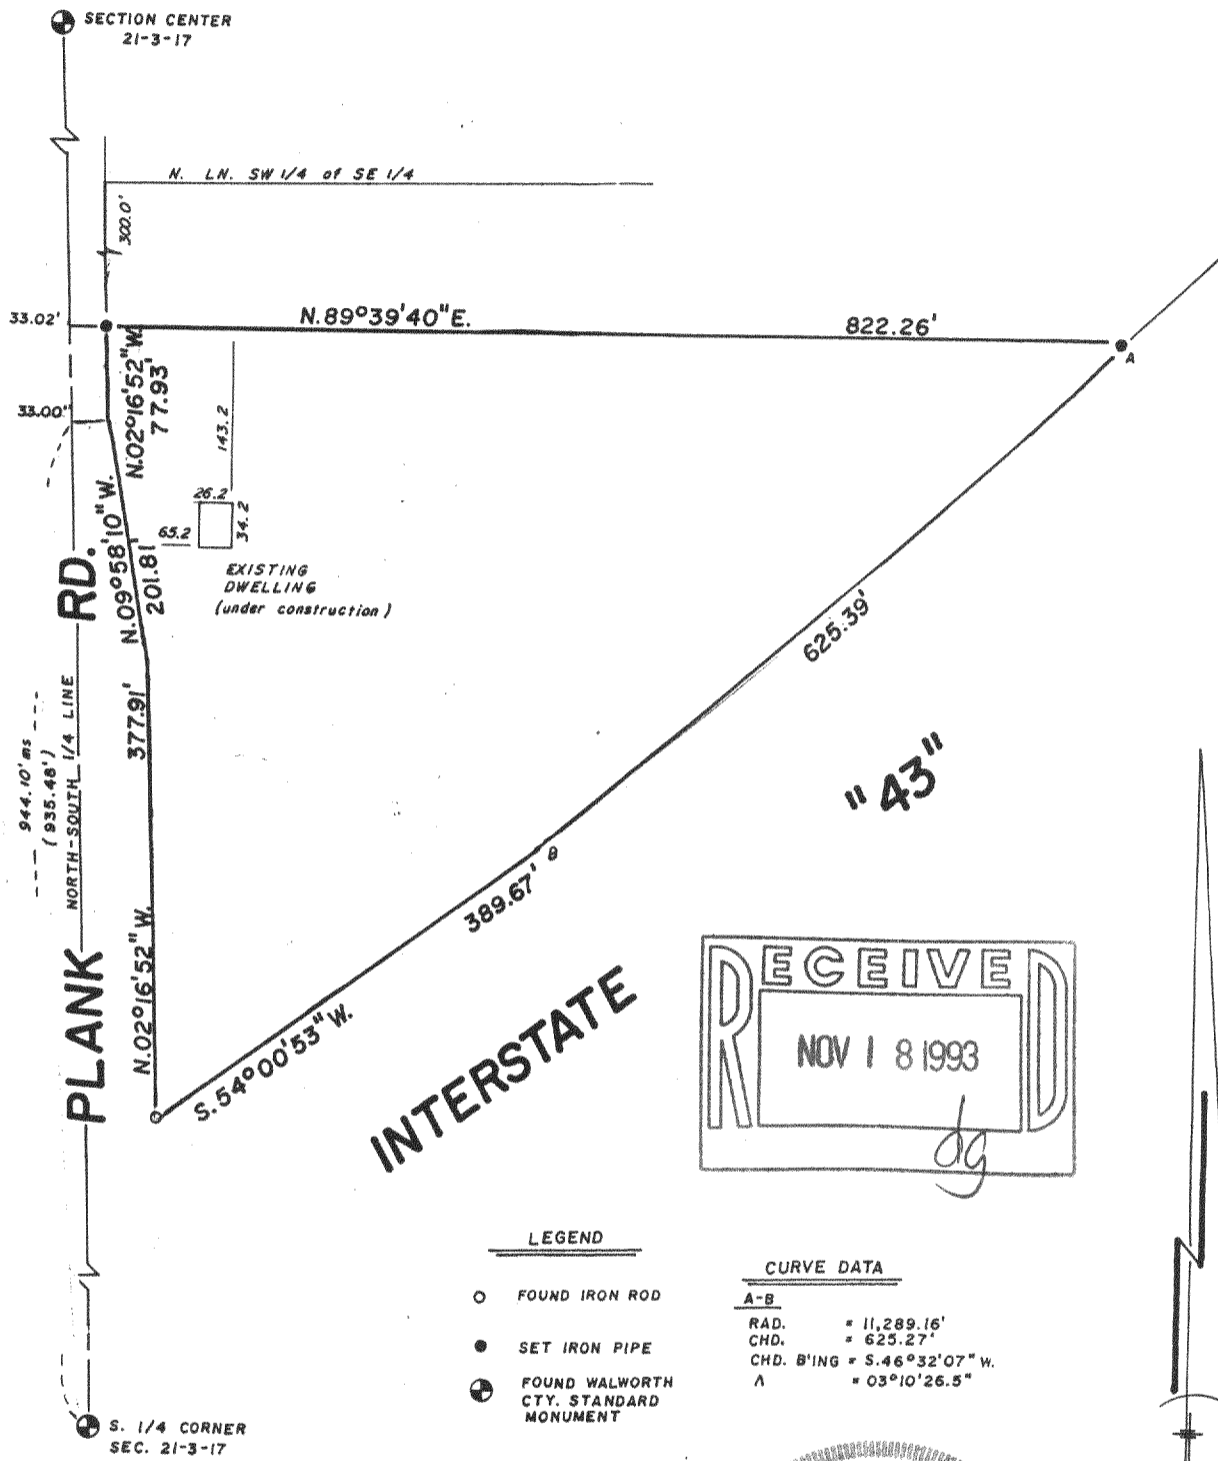


LEGEND


- FOUND IRON ROD
- SET IRON PIPE
- ⊕ FOUND WALWORTH CTY. STANDARD MONUMENT

CURVE DATA

| A-B | |
|------------|------------------|
| RAD. | = 11,289.16' |
| CHD. | = 625.27' |
| CHD. B'ING | = S.46°32'07" W. |
| Δ | = 03°10'26.5" |

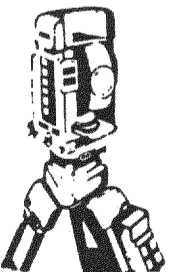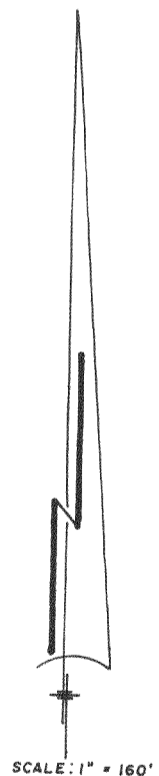

B.W. SURVEYING
Land Surveys
Mapping And Planning
35117 Academy Road
Burlington, Wisconsin 53105
(414) 534-4109

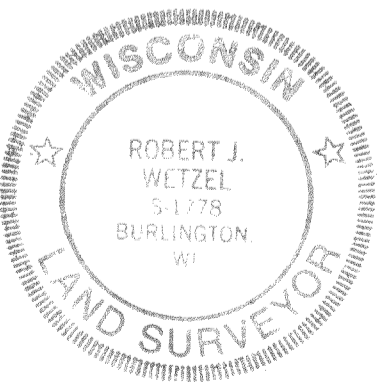

"I hereby certify that I have surveyed the above described property and that the above map is a true representation thereof and shows the size and location of the property, its exterior boundaries, the location of all visible structures and dimensions of all principal buildings thereon, boundary fences, apparent easements, roadways and encroachments, if any."

THIS IS NOT AN ORIGINAL PRINT
UNLESS THIS SEAL IS RED

Robert J. Wetzel
ROBERT J. WETZEL
REGISTERED LAND SURVEYOR - 1778

"This survey is made for the use of the present owners of the property, and those who purchase, mortgage, or guarantee the title thereto within one year from date hereof."

AUGUST 13, 1993
DATE

1349
JOB NUMBER

KA-1085-2

317-306