


PLAT OF SURVEY


LOT 104 OF EVERGREEN ESTATES
SUBDIVISION LOCATED IN SECTIONS 18
AND 19, TOWN 3 NORTH, RANGE 17 EAST,
TOWN OF LaFAYETTE, WALWORTH COUNTY,
WISCONSIN.

ORDERED BY: JOHN SMITH, BUILDER
313 BAKER ST.
ELKHORN, WI. 53121

NOTE: BUILDING WAS LAID OUT WITH WOOD STAKES AS
INDICATED. BUILDER/ EXCAVATER TO CHECK FIELD DIMENSIONS
TO INSURE PROPER PLAN INTERPERTATION. OFFSET STAKES
HAVE BEEN PROVIDED AT 3 CORNERS.

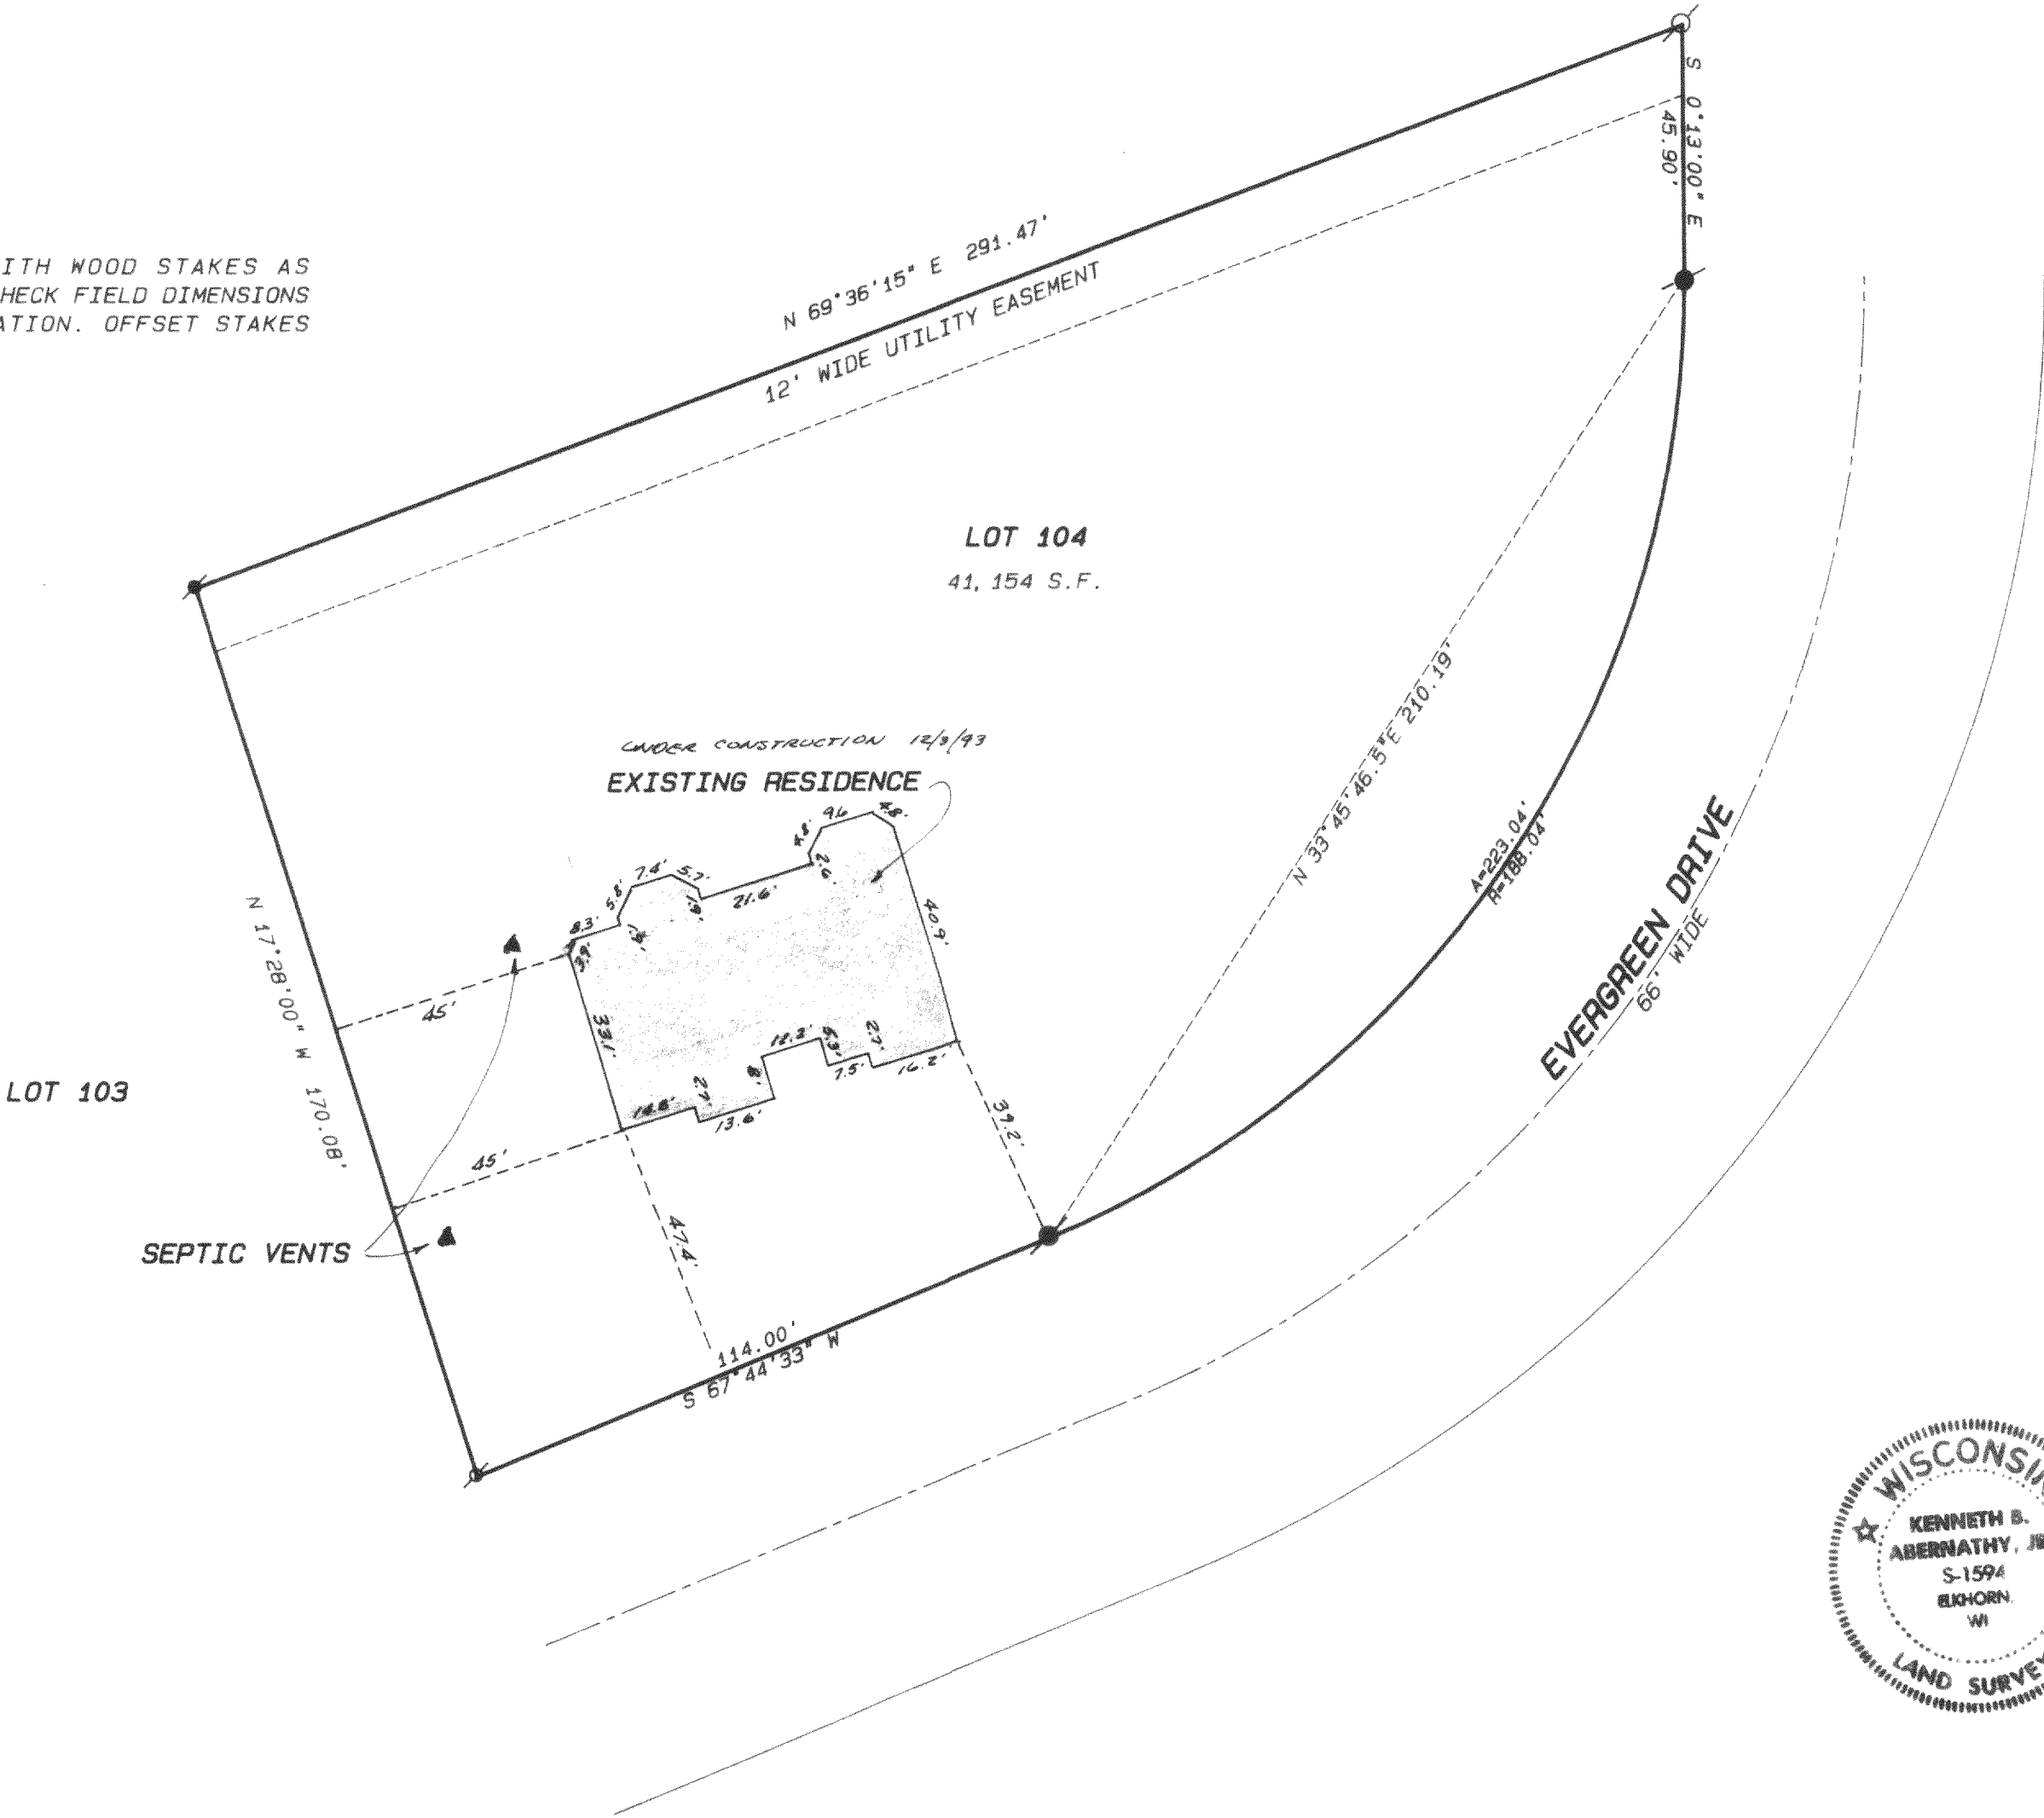

- Legend
- FOUND IRON PIPE
 - FOUND IRON ROD
 - FOUND BRASS CAPPED MONUMENT
 - FOUND CONCRETE MONUMENT
 - CHISEL CUT IN CONCRETE
 - SET IRON ROD, 24" LONG, WEIGHING 1.5 LBS./LINEAL FT., 3/4" DIA.
 - SET IRON ROD, 30" LONG, WEIGHING 4.5 LBS./LINEAL FT., 1-11/16" DIA.
 - (xx) RECORDED AS DIMENSION
 - EXISTING FENCE

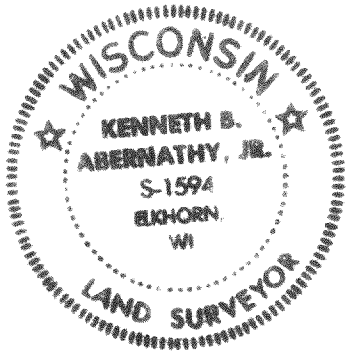

SCALE: 1" = 30 FEET

"I hereby certify that I have surveyed the above described property and that the above map is a true representation thereof and shows the size and location of the property, its exterior boundaries, the location of all visible structures and dimensions of all principal buildings thereon, boundary fences, apparent easements, roadways and visible encroachments, if any."

"This survey is made for the use of the present owners of the property, and also those who purchase, mortgage, or guarantee the title thereto within one year from date hereof."

Kenneth B. Abernathy, Jr.
KENNETH B. ABERNATHY, JR.
WISCONSIN REGISTERED LAND SURVEYOR,
S-1594
Date: 12/3/93 Job No. 93.1017

"AS BUILT"

