PLAT OF SURVEY


LOCATION:

EVERGREEN DRIVE, LA FAYETTE, WISCONSIN

LEGAL DESCRIPTION:LOT 118 IN EVERGREEN ESTATES, BEING A SUBDIVISION OF A PART OF THE SW 1/4 OF THE NW 1/4 AND THE SW 1/4 OF THE SW 1/4 AND THE NW 1/4 OF THE SW 1/4 AND THE SW 1/4 OF TH SECTION 18 AND THE SW 1/4 OF THE NW 1/4 AND THE NW 1/4 OF THE NW 1/4 AND THE NE 1/4 OF THE NW 1/4 AND THE SE 1/4 OF THE NW 1/4 AND THE NW 1/4 OF THE NE 1/4 OF SECTION 19, T 3 N, R 17 E, IN THE TOWN OF LA FAYETTE, WALWORTH COUNTY, WISCONSIN.

DECEMBER 13, 1978

SURVEY NO. 54921

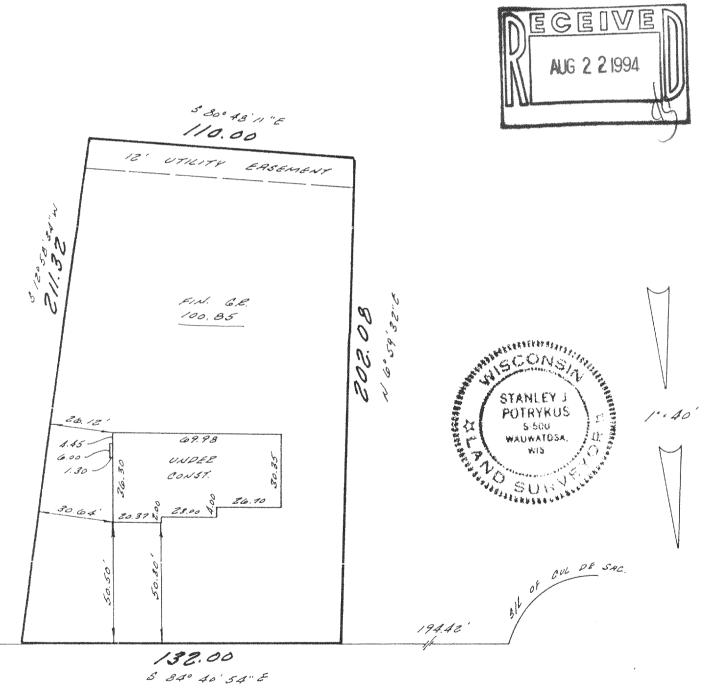

EVERGREEN

REGISTERED LAND SURVEYORS WAUWATOSA, WIS. 53226 611 N. MAYFAIR RD.

66

DE.

453-9151

I HEREBY CERTIFY THAT I HAVE SURVEYED THE ABOVE DESCRIBED PROPERTY AND THAT THE ABOVE MAP IS A TRUE REPRESENTATION THEREOF AND SHOWS THE SIZE AND LOCATION OF THE PROPERTY, ITS EXTERIOR BOUNDARIES, THE LOCATION OF ALL VISIBLE STRUCTURES AND DIMENSIONS OF ALL PRINCIPAL BUILDINGS THEREON, BOUNDARY FENCES, APPARENT EASEMENTS AND ROADWAYS AND VISIBLE ENCROACHMENTS, IF ANY.

METROPOLITAN SURVEY SERVICE, INC. THIS SURVEY IS MADE FOR THE EXCLUSIVE USE OF THE PRESENT OWNERS OF THE PROPERTY. AND ALSO THOSE WHO PURCHASE, MORTGAGE, OR GUARANTEE THE TITLE THERETO WITHIN ONE (1) YEAR FROM DATE HEREOF

SIGNED

STANLEY L POTRYKUS REMITERED LAND SURVEYOR S-800 317-325