


Services Offered
 Commercial Site Development
 Subdivision Design and Platting
 Planning and Plan Review
 Streets and Highway Design
 Drainage Studies
 Water Distribution Systems
 Sewer Collection Systems
 Construction Surveying and Stake-out Services
 GPS Surveying
 Certified Soil Testing

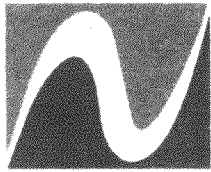


Nienow Engineering Assoc.
 Consulting Engineers and Surveyors
 229 E. Main Street
 Waterford, WI 53185
 (414) 534-9190 Fax (414) 534-9192

962313
 962313S1.DWG

PLAT OF SURVEY

LOT 8, BLOCK 4, ALPINE TOWER ESTATES, BEING A SUBDIVISION
 LOCATED IN THE NORTHEAST 1/4 OF SECTION 13, TOWN 3 NORTH,
 RANGE 17 EAST, TOWN OF LA FAYETTE, WALWORTH COUNTY, WISCONSIN.


SURVEYED FOR: EMBASSY HOMES
 OEHLERS RESIDENCE

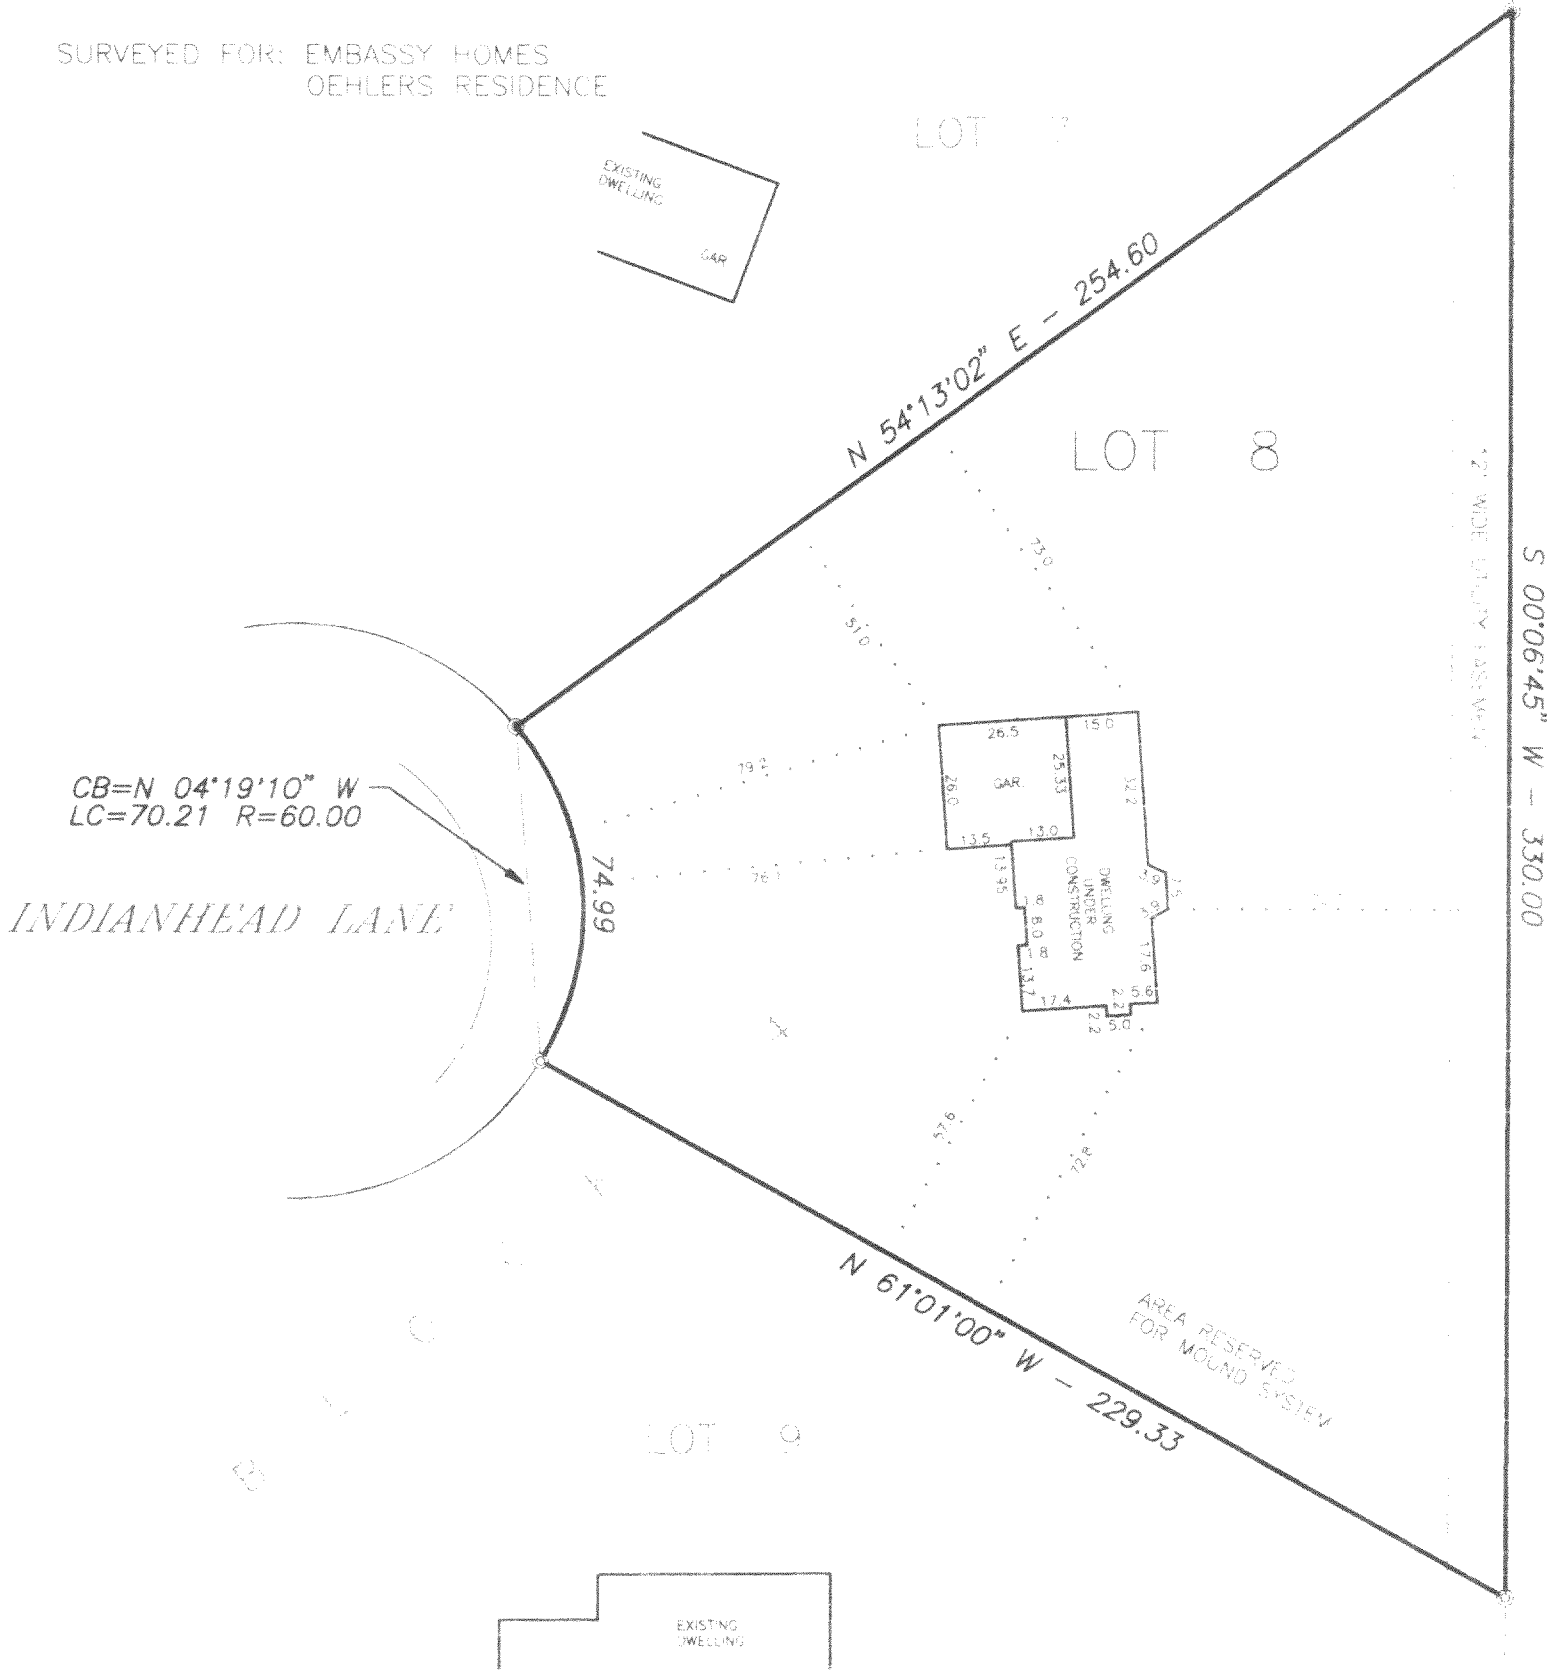

CB=N 04°19'10" W
 LC=70.21 R=60.00

INDIANHEAD LANE

- LEGEND**
- - PK NAIL
 - ⊙ - FOUND IRON PIPE
 - - SET IRON PIPE
 - x- - FENCE
 - () - RECORDED AS
 - - FOUND BRASS CAPPED MONUMENT
 - - FOUND CONCRETE MONUMENT

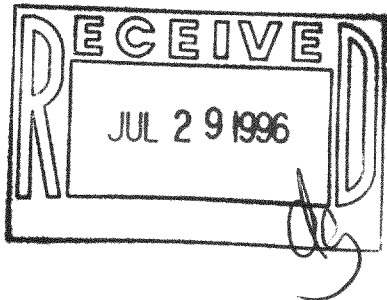

SCALE: 1" = 40'



STATE OF WISCONSIN)
 RACINE COUNTY)

I HEREBY CERTIFY THAT I HAVE SURVEYED THE ABOVE DESCRIBED PROPERTY AND THE ABOVE MAP IS A TRUE REPRESENTATION THEREOF AND SHOWS THE SIZE AND LOCATION OF THE PROPERTY, THE LOCATION OF ALL VISIBLE STRUCTURES AND DIMENSIONS OF ALL PRINCIPAL BUILDINGS THEREON, BOUNDARY FENCES, APPARENT EASEMENTS, ROADWAY AND VISIBLE ENCROACHMENTS, IF ANY.


THIS SURVEY IS MADE FOR THE PRESENT OWNERS OF THE PROPERTY, AND ALSO THOSE WHO PURCHASE OR GUARANTEE THE TITLE THERETO WITHIN (1) YEAR FROM THE DATE HEREOF

DATED AT WATERFORD THIS 12TH DAY OF MARCH 1996

RECERTIFIED MAY 30, 1996


Gary B. Nienow

Services Offered
 Commercial Site Development
 Subdivision Design and Platting
 Planning and Plan Review
 Streets and Highway Design
 Drainage Studies
 Water Distribution Systems
 Sewer Collection Systems
 Construction Surveying and Stake-out Services
 GPS Surveying
 Certified Soil Testing

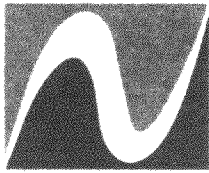

Nienow Engineering Assoc.
 Consulting Engineers and Surveyors
 229 E. Main Street
 Waterford, WI 53185
 (414) 534-9190 Fax (414) 534-9192


962313
 962313S1.DWG

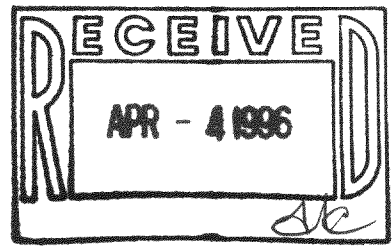

PLAT OF SURVEY

LOT 8, BLOCK 4, ALPINE TOWER ESTATES, BEING A SUBDIVISION
 LOCATED IN THE NORTHEAST 1/4 OF SECTION 13, TOWN 3 NORTH,
 RANGE 17 EAST, TOWN OF LA FAYETTE, WALWORTH COUNTY, WISCONSIN.

SURVEYED FOR: EMBASSY HOMES
 OEHLERS RESIDENCE

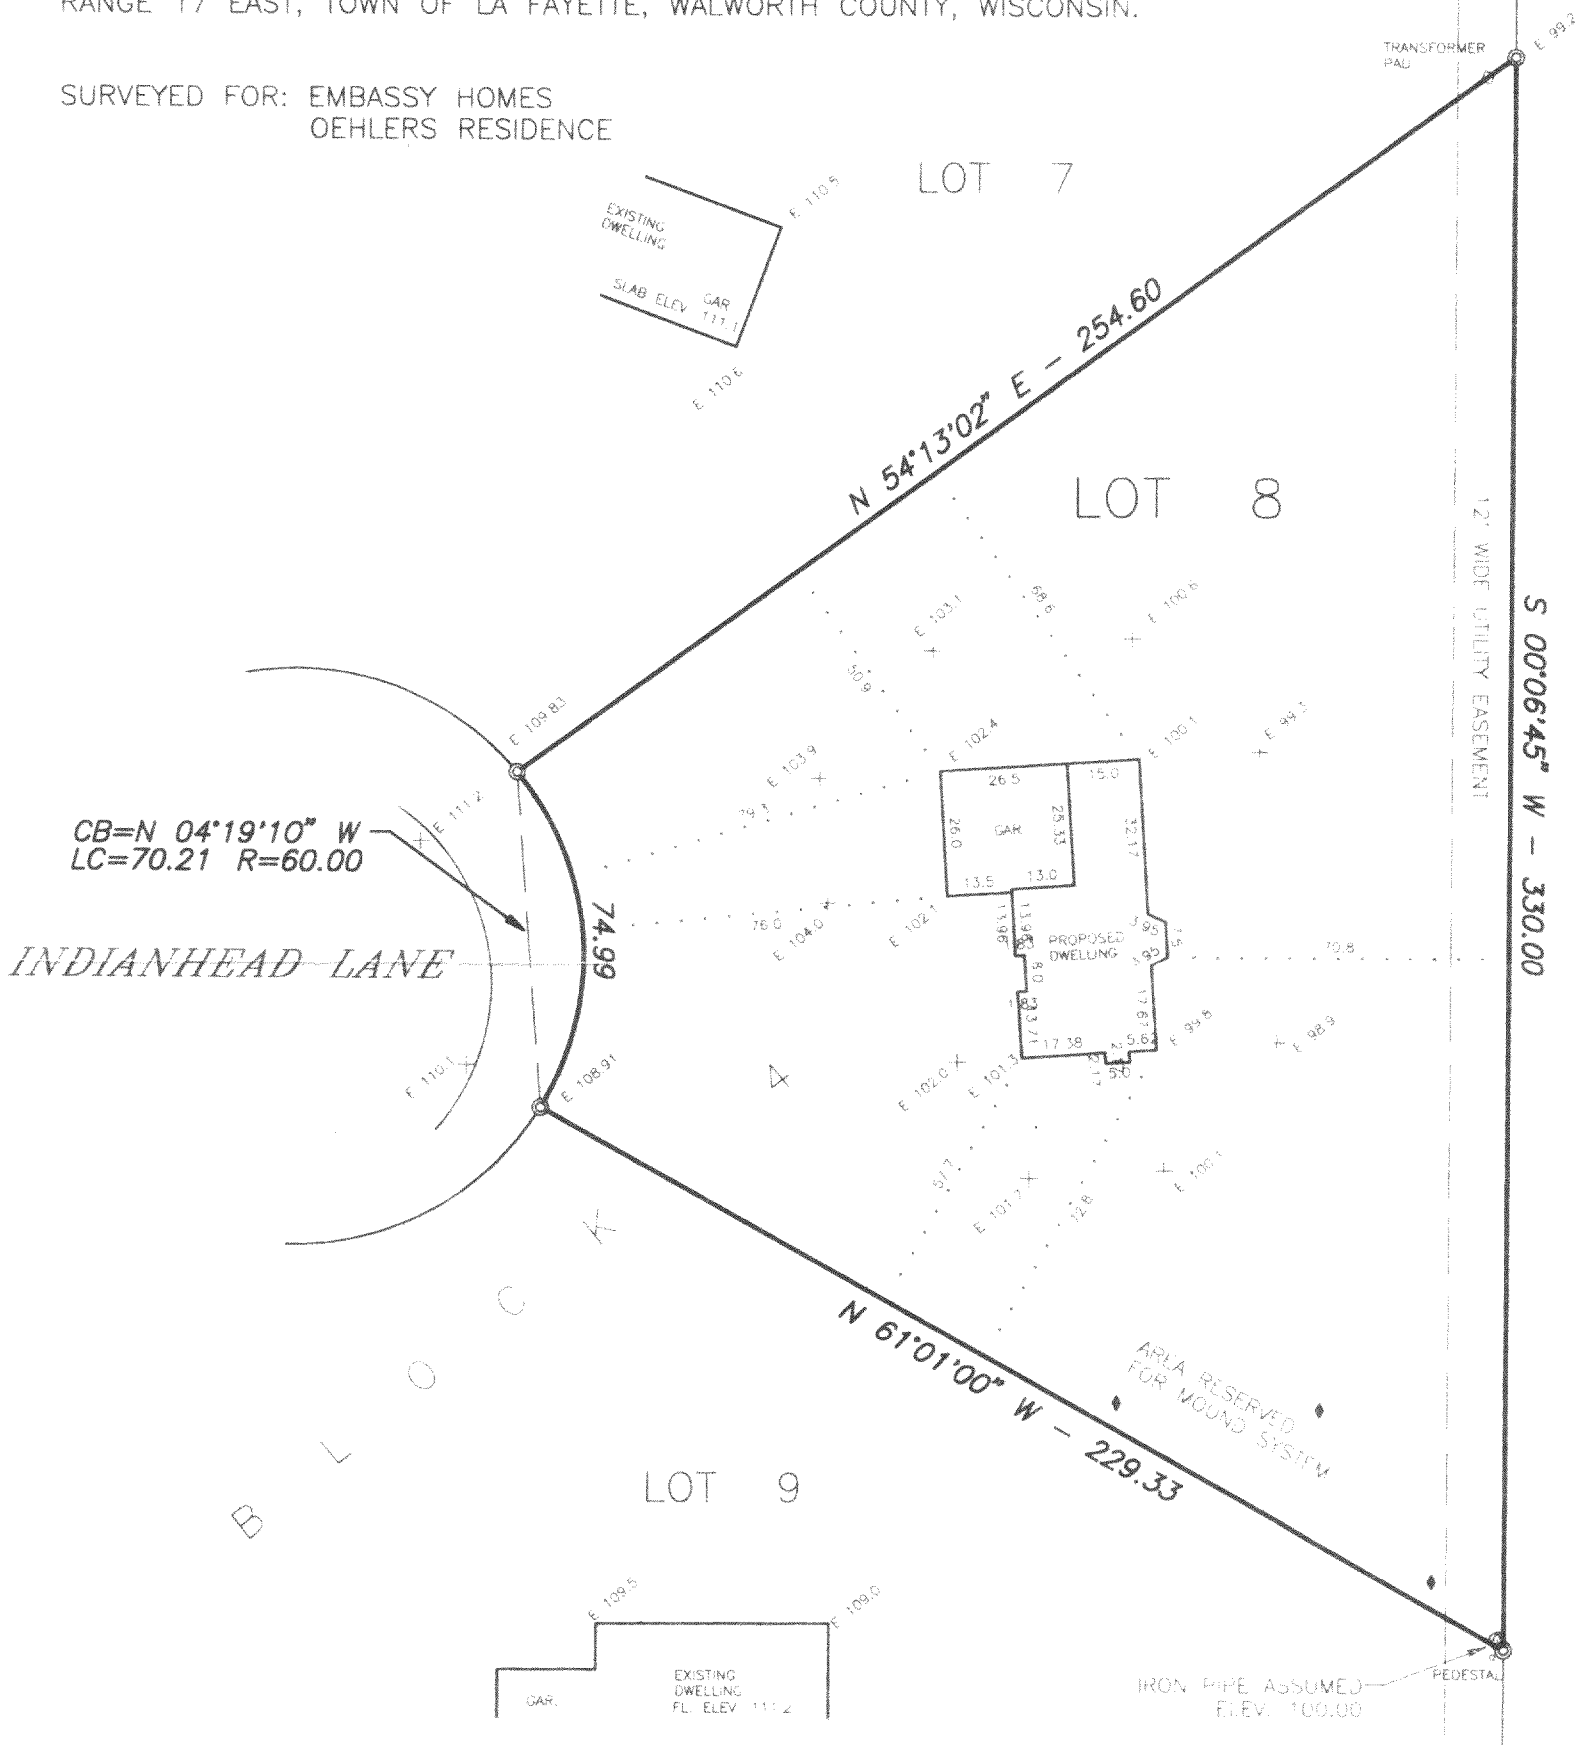


LEGEND

- + - CROSS CUT IN CONCRETE
- o - PK NAIL
- ⊙ - FOUND IRON PIPE
- - FOUND IRON ROD
- - SET IRON PIPE
- - FENCE
- () - RECORDED AS
- ⬇ - SOIL BORING
- ⊗ - BENCH MARK
- ⊕ - FOUND BRASS CAPPED MONUMENT
- ⊞ - FOUND CONCRETE MONUMENT

E = ELEVATIONS BASED ON SOILS
 REPORT DATUM

NOTE: SOIL BORING LOCATIONS AND BENCH
 MARK WERE TAKEN FROM SOILS REPORT

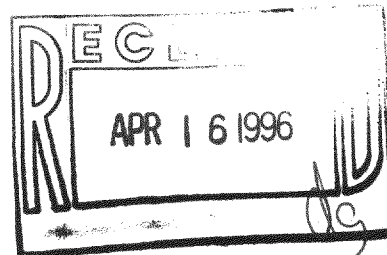

SCALE: 1" = 40'

STATE OF WISCONSIN)
 RACINE COUNTY)


I HEREBY CERTIFY THAT I HAVE SURVEYED THE ABOVE DESCRIBED PROPERTY AND THE ABOVE MAP IS A TRUE REPRESENTATION THEREOF
 AND SHOWS THE SIZE AND LOCATION OF THE PROPERTY, THE LOCATION OF ALL VISIBLE STRUCTURES AND DIMENSIONS OF ALL PRINCIPAL
 BUILDINGS THEREON, BOUNDARY FENCES, APPARENT EASEMENTS, ROADWAY AND VISIBLE ENCROACHMENTS, IF ANY.

THIS SURVEY IS MADE FOR THE PRESENT OWNERS OF THE PROPERTY, AND ALSO THOSE WHO PURCHASE, OR GUARANTEE THE TITLE THERETO
 WITHIN (1) YEAR FROM THE DATE HEREOF.

DATED AT WATERFORD THIS 12TH DAY OF MARCH 1996

RECERTIFIED _____

[Handwritten Signature]

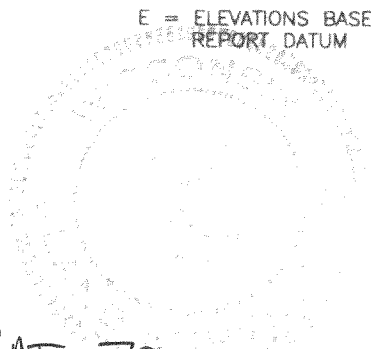

KAT-70
 317-377

N28961