

# PLAT OF SURVEY

**RSV ENGINEERING, INC.**  
ENGINEERS, PLANNERS, SURVEYORS  
CONSTRUCTION MANAGERS  
545 BAY VIEW ROAD, MUKWONAGO, WISCONSIN 53149 (414) 363-2004

RECERTIFICATION: 11/24/97

DATE: 9./30/97

FOR: LAZZARONI BUILDERS, INC.

DESCRIPTION: LOT 4, SUGAR CREEK FARMS BEING A SUBDIVISION  
LOCATED IN THE EAST  $\frac{1}{2}$  OF THE NE  $\frac{1}{4}$  OF  
SECTION 11, TOWN 9 NORTH, RANGE 17 EAST, TOWN  
OF LAFAYETTE, WALWORTH COUNTY, WISCONSIN.



## LEGEND

• IRON PIPE FOUND

- X - X - FENCE




SCALE 1" = 100'

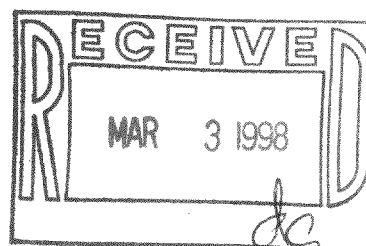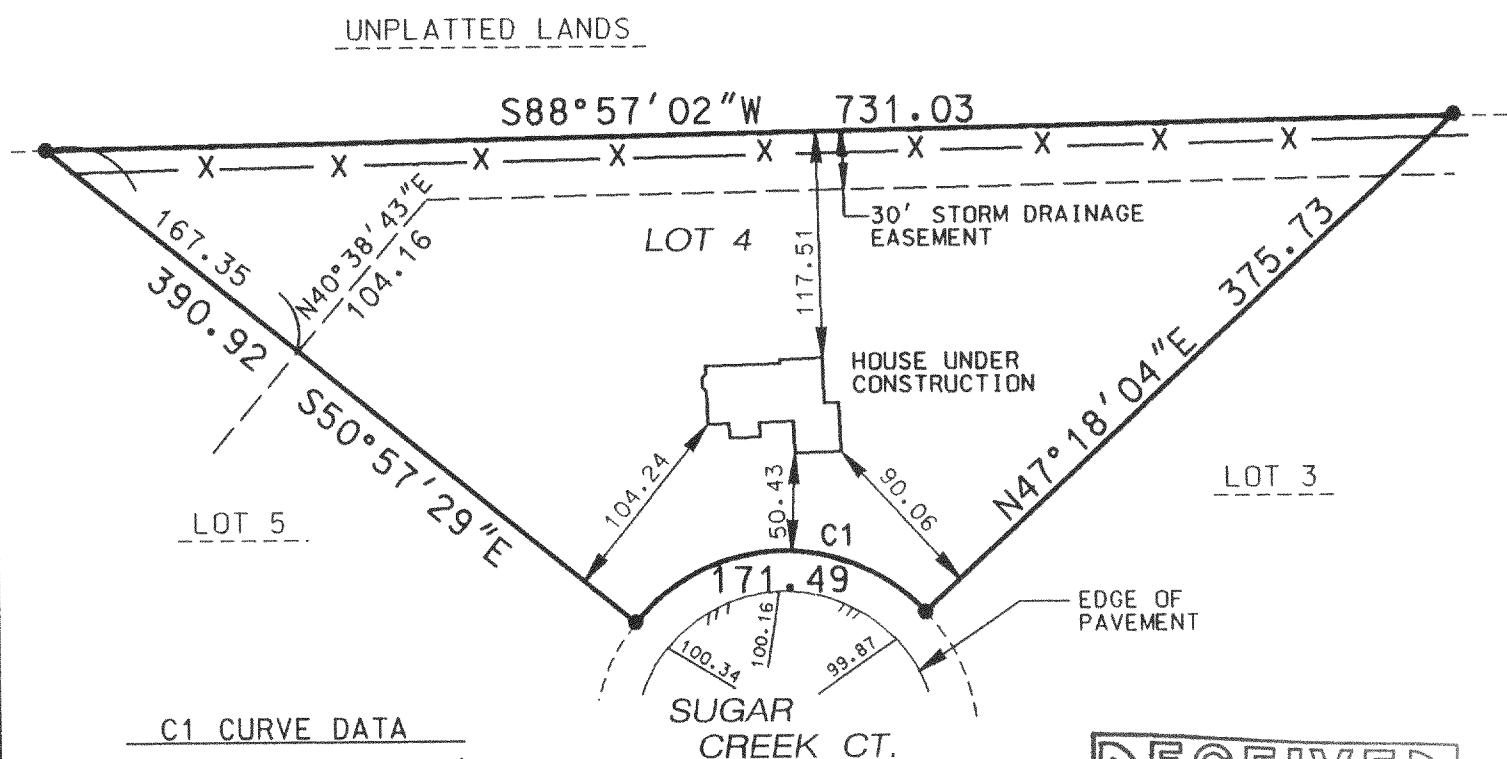

THE ABOVE MAP IS A TRUE REPRESENTATION THEREOF AND  
SHOWS THE SIZE AND LOCATION OF ALL THE PROPERTY,  
EXTERIOR BOUNDARIES, THE LOCATION OF ALL VISIBLE  
BOUNDARY FENCES, APPARENT EASEMENTS, ROADWAYS  
AND VISIBLE ENCROACHMENTS, IF ANY.

THIS SURVEY IS MADE FOR THE USE OF THE PRESENT  
OWNERS OF THE PROPERTY, AND ALSO THOSE WHO  
PURCHASE, MORTGAGE OR GUARANTEE TITLE THERETO  
WITHIN ONE (1) YEAR FROM DATE HERETO.

THIS IS ORIGINAL  
PRINT ONLY IF  
SEAL IS IMPRINTED  
IN RED

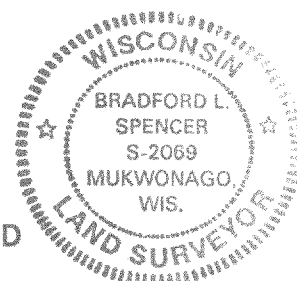

BRADFORD L. SPENCER, R.L.S. 2069

RSV# 97330.DGN

KS-4 317-413