

PLAT OF SURVEY

RSV ENGINEERING, INC
ENGINEERS, PLANNERS, SURVEYORS
CONSTRUCTION MANAGERS
ENVIRONMENTAL SCIENTISTS
801 MAIN STREET, MUKWONAGO, WISCONSIN 53149 (414) 363-2004



FOR: PAT WHITING

RECERT. 5/13/98
DATE: 8-11-97

DESCRIPTION: BEING LOT 6 OF SUGAR CREEK FARMS LOCATED IN THE EAST $\frac{1}{2}$ OF THE NE $\frac{1}{4}$ OF SECTION 11, TOWN 3 NORTH, RANGE 17 EAST, TOWN OF LAFAYETTE, WALWORTH COUNTY, WISCONSIN.

LEGEND

- 1" FOUND IRON PIPE OR REBAR

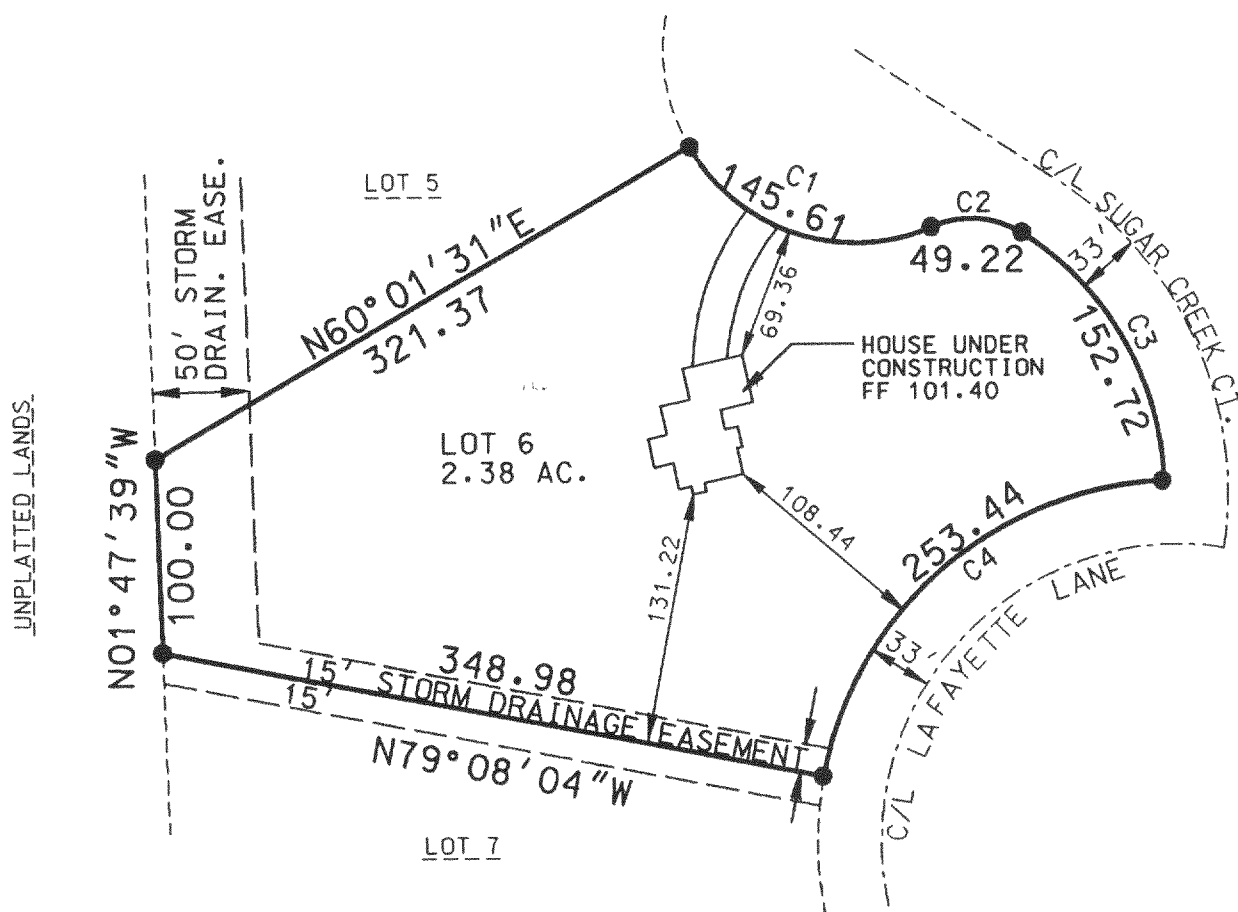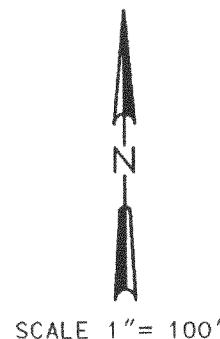

CURVE TABLE



NO.	ARC	DELTA	RADIUS	CHD.	BRG.
1	145.61	83°25'46"	100.00	133.08	S71°41'21"E
2	49.22	56°24'14"	50.00	47.26	S85°12'07"E
3	152.72	55°00'00"	159.10	146.93	S29°30'00"E
4	253.44	124°00'00"	188.26	332.45	S49°25'50"W

THE ABOVE MAP IS A TRUE REPRESENTATION THEREOF AND SHOWS THE SIZE AND LOCATION OF ALL THE PROPERTY, EXTERIOR BOUNDARIES, THE LOCATION OF ALL VISIBLE BOUNDARY FENCES, APPARENT EASEMENTS, ROADWAYS AND VISIBLE ENCROACHMENTS, IF ANY.

THIS SURVEY IS MADE FOR THE USE OF THE PRESENT OWNERS OF THE PROPERTY, AND ALSO THOSE WHO PURCHASE, MORTGAGE OR GUARANTEE TITLE THERETO WITHIN ONE (1) YEAR FROM DATE HERETO.

BRADFORD L. SPENCER, R.L.S. 2069

THIS IS ORIGINAL
PRINT ONLY IF
SEAL IS IMPRINTED
IN RED

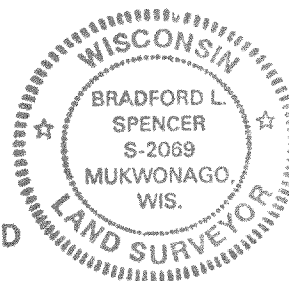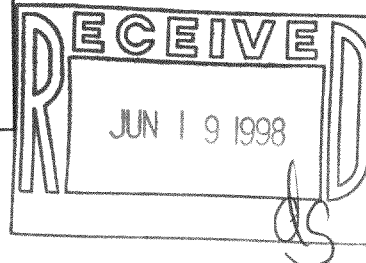

RSV# 97176

317-417