


PLAT OF SURVEY

PATHFINDER SURVEYING
FORMERLY KOLB LAND CONSULTING
929 WILLIAMS STREET LAKE GENEVA, WI. 53147
(414) 248-3697

DATE: 10/13/1998
DATE OF LAST REVISION 12 / 23 / 1998

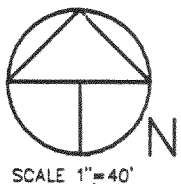

ORDERED BY: DR. AUL
N 7376 LOST NATION ROAD
ELKORN, WI, 53121

NOTE: THIS LOT LINE ADJUSTMENT BETWEEN ADJOINING LAND OWNERS DOES NOT
CREATE ADDITIONAL LOTS AND ORIGINAL PARCELS ARE NOT REDUCED
BELOW THE MINIMUM SIZE REQUIRED BY THE WALWORTH COUNTY ZONING
ORDINANCES.


PARCEL "A" UNIT 14 PHASE 1 ROLLING GREEN COUNTRY ESTATES A CONDOMINIUM
LOCATED IN THE SOUTHEAST 1/4 AND THE SOUTHWEST 1/4 OF
SECTION 18 T3N, R17E, TOWN OF LAFAYETTE, WALWORTH COUNTY,
WISCONSIN.

PARCEL "B" A PARCEL OF LAND LOCATED IN UNIT 13 PHASE 1 ROLLING GREEN
COUNTRY ESTATES A CONDOMINIUM LOCATED IN THE SOUTHEAST
1/4 AND THE SOUTHWEST 1/4 OF SECTION 18 T3N, R17E, TOWN OF
LAFAYETTE BEGINNING AT THE SOUTHEAST CORNER OF SAID UNIT 13 ;
THENCE N 05°30'50" E 231.81 FEET ;
THENCE ALONG THE ARC OF CURVE TO THE RIGHT WITH A RADIUS OF
67.00 FEET A DISTANCE OF 52.48 FEET WHOSE CHORD BEARS S 67°56'52" E
A DISTANCE OF 51.15 FEET ; THENCE S 18°14'00" W 222.71 FEET
TO THE POINT OF BEGINNING. SAID PARCEL CONTAINS 5858 SQUARE
FEET MORE OR LESS.

PARCEL "C" PART OF
UNIT 13 PHASE 1 ROLLING GREEN COUNTRY ESTATES A CONDOMINIUM
LOCATED IN THE SOUTHEAST 1/4 AND THE SOUTHWEST 1/4 OF
SECTION 18 T3N, R17E, TOWN OF LAFAYETTE, WALWORTH COUNTY
WISCONSIN BEGINNING AT THE SOUTHEAST CORNER OF SAID UNIT
13 THENCE S 89°46'10" W A DISTANCE OF 114.82 FEET, THENCE
N 00°23'22" W A DISTANCE OF 230.47 FEET, THENCE N 89°41'50" E
A DISTANCE OF 138.66 FEET, THENCE S 05°30'50" W A DISTANCE OF 231.81
FEET TO THE POINT OF BEGINNING. SAID PARCEL CONTAINS 29220 SQUARE
FEET MORE OR LESS.

NOTE: PARCEL "B" IS THE PARCEL TO BE ADDED TO PARCEL "A"


- LEGEND
- FOUND IRON PIPE
 - (XXXX) RECORDED AS
 - WELL
 - VENT

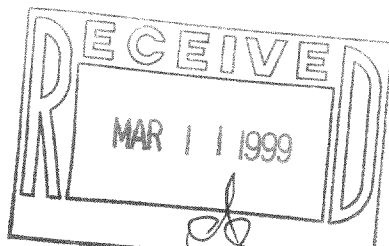

THE ABOVE MAP IS A TRUE REPRESENTATION THEREOF AND
SHOWS THE SIZE AND LOCATION OF ALL THE PROPERTY,
EXTERIOR BOUNDARIES, THE LOCATION OF ALL VISIBLE
BOUNDARY FENCES, APPARENT EASEMENTS, ROADWAYS
AND VISIBLE ENCROACHMENTS, IF ANY


THIS SURVEY IS MADE FOR THE USE OF THE PRESENT
OWNERS OF THE PROPERTY, AND ALSO THOSE WHO
PURCHASE, MORTGAGE OR GUARANTEE TITLE THERETO
WITHIN ONE (1) YEAR FROM DATE HERETO.

John P. Krott
JOHN P. KROTT, R.L.S. 2258

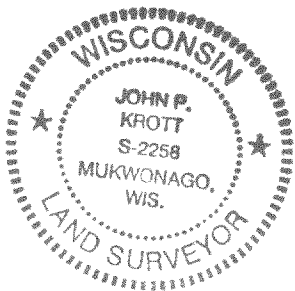

NOTE: THIS IS NOT A CERTIFIED COPY
UNLESS SEAL IS IN RED.

JOB NUMBER #98190 3-17-KRG-14

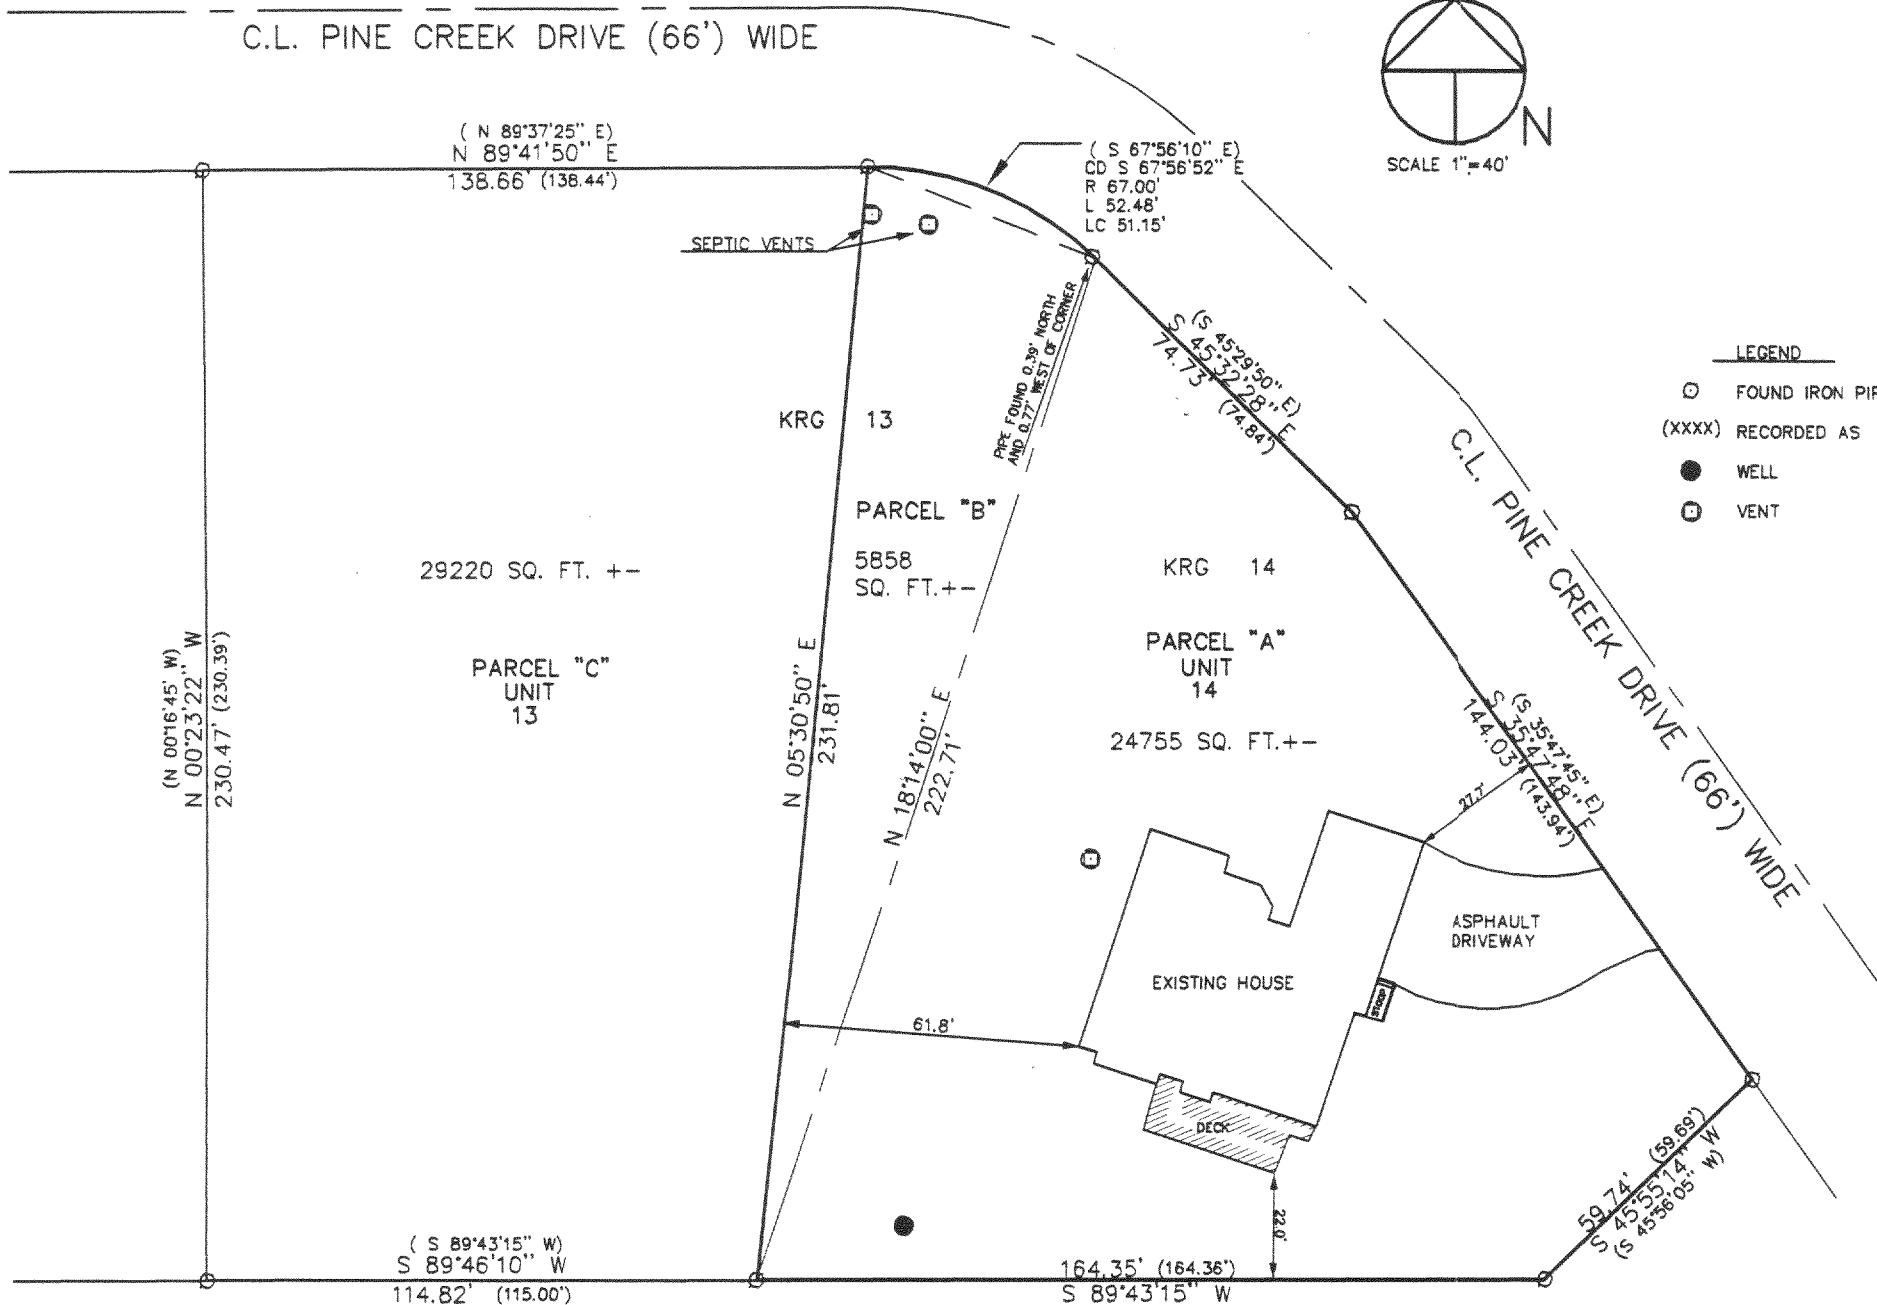

KRG-14

317-434