


ABELL
SURVEYING & MAPPING

EVERGREEN

ESTATES

1140 SEQUOIA STREET • DELAVAN, WISCONSIN 53115
414-728-6737

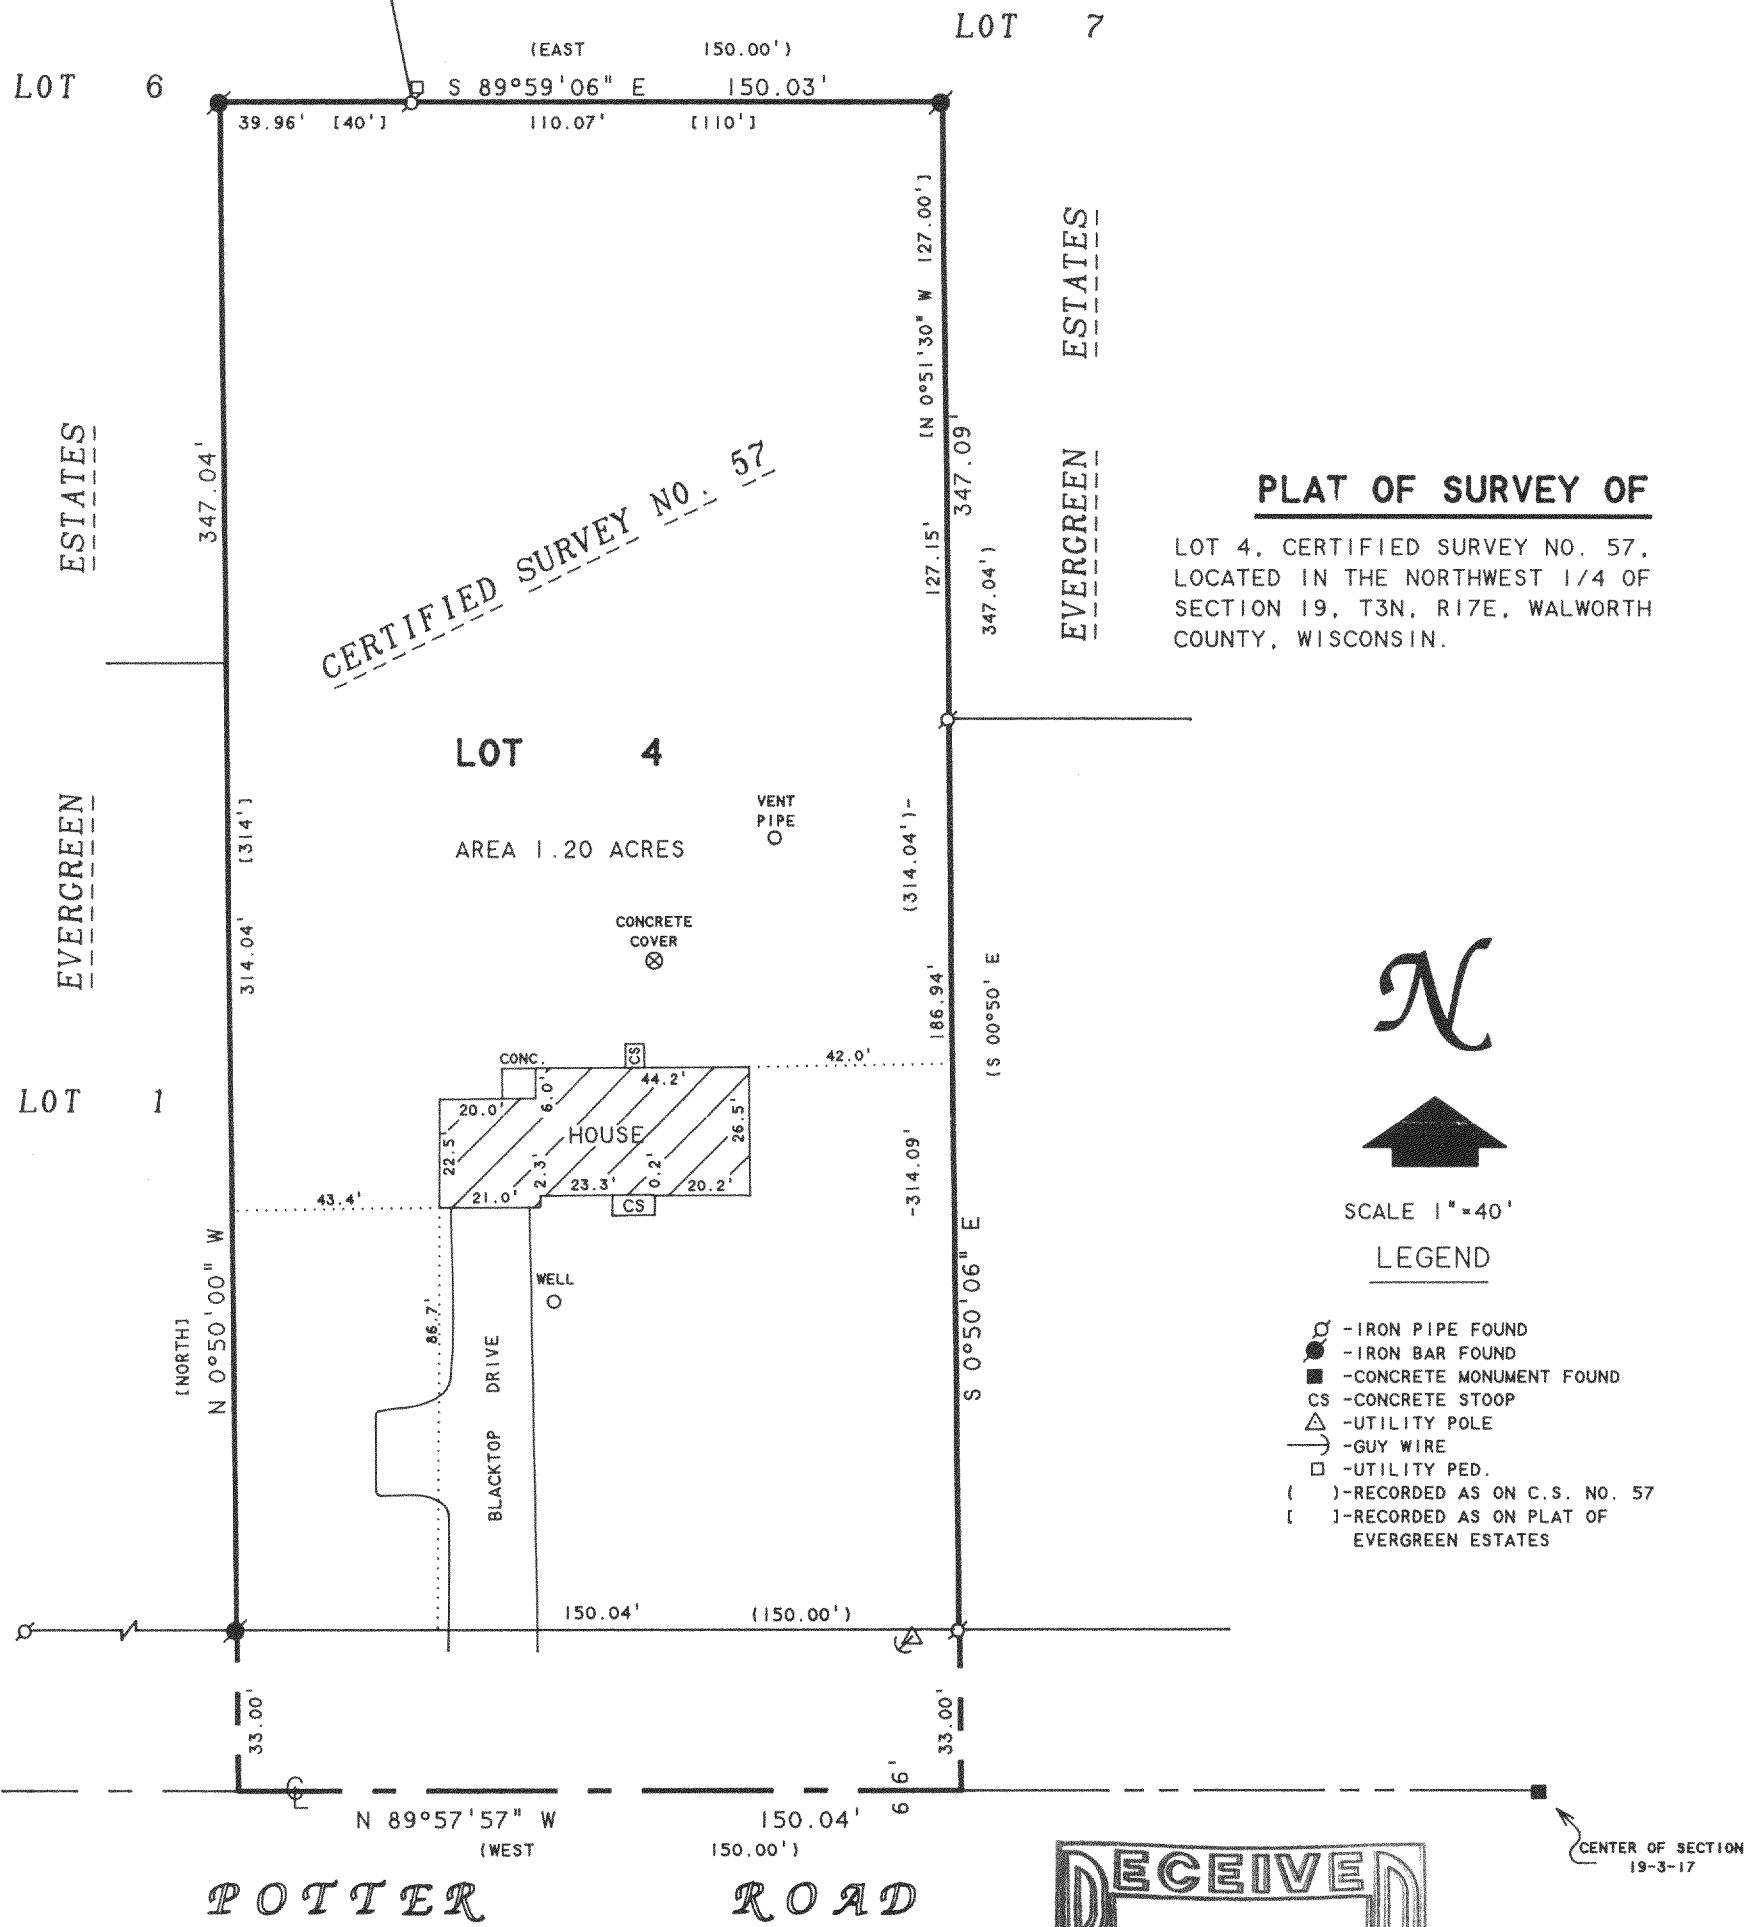

317-452
KA-57-4