



1140 SEQUOIA STREET • DELAVAN, WISCONSIN 53115  
414-728-6737

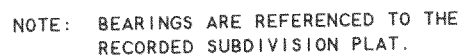


LOT 32, EVERGREEN ESTATES, LOCATED IN  
T3N, R17E, WALWORTH COUNTY, WISCONSIN.

ORDERED BY: CENTURY 21-SKANDIA REALTY  
822 E. GENEVA STREET  
DELAVAN, WI 53115

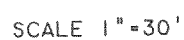

☉ -IRON PIPE FOUND  
 ● -IRON BAR FOUND  
 ○ -IRON ROD FOUND  
 CS -CONCRETE STOOP  
 BE -BASEMENT ENTRY  
 □ □ -UTILITY PEDS.  
 ( ) -RECORDED AS

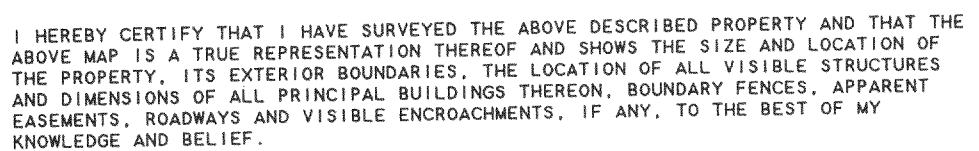

THIS SURVEY IS MADE FOR THE USE OF THE PRESENT OWNERS OF THE PROPERTY, AND ALSO THOSE WHO PURCHASE, MORTGAGE, OR GUARANTEE THE TITLE THERETO WITHIN ONE (1) YEAR FROM DATE HEREON.

DAVID F. ABELL  
WISCONSIN REGISTERED LAND SURVEYOR, S-1596

April 5, 1999

DATE April 5, 1971 JOB NUMBER - 99035  
NOTE: THIS IS NOT A CERTIFIED COPY UNLESS SEALED.

317-453

KE-32