


PLAT OF SURVEY

PATHFINDER SURVEYING
FORMERLY KOLB LAND CONSULTING
929 WILLIAMS STREET LAKE GENEVA, WI. 53147
(414) 248-3697

ORDERED BY: BASSO BUILDERS
405 SKYLINE DRIVE
LAKE GENEVA, W 53147

DATE: 9-22-1999
DATE OF LAST REVISION: 2-4-2000

DESCRIPTION: LOT 115 OF EVERGREEN ESTATES, LOCATED IN
T3N, R17E, WALWORTH COUNTY, WISCONSIN.

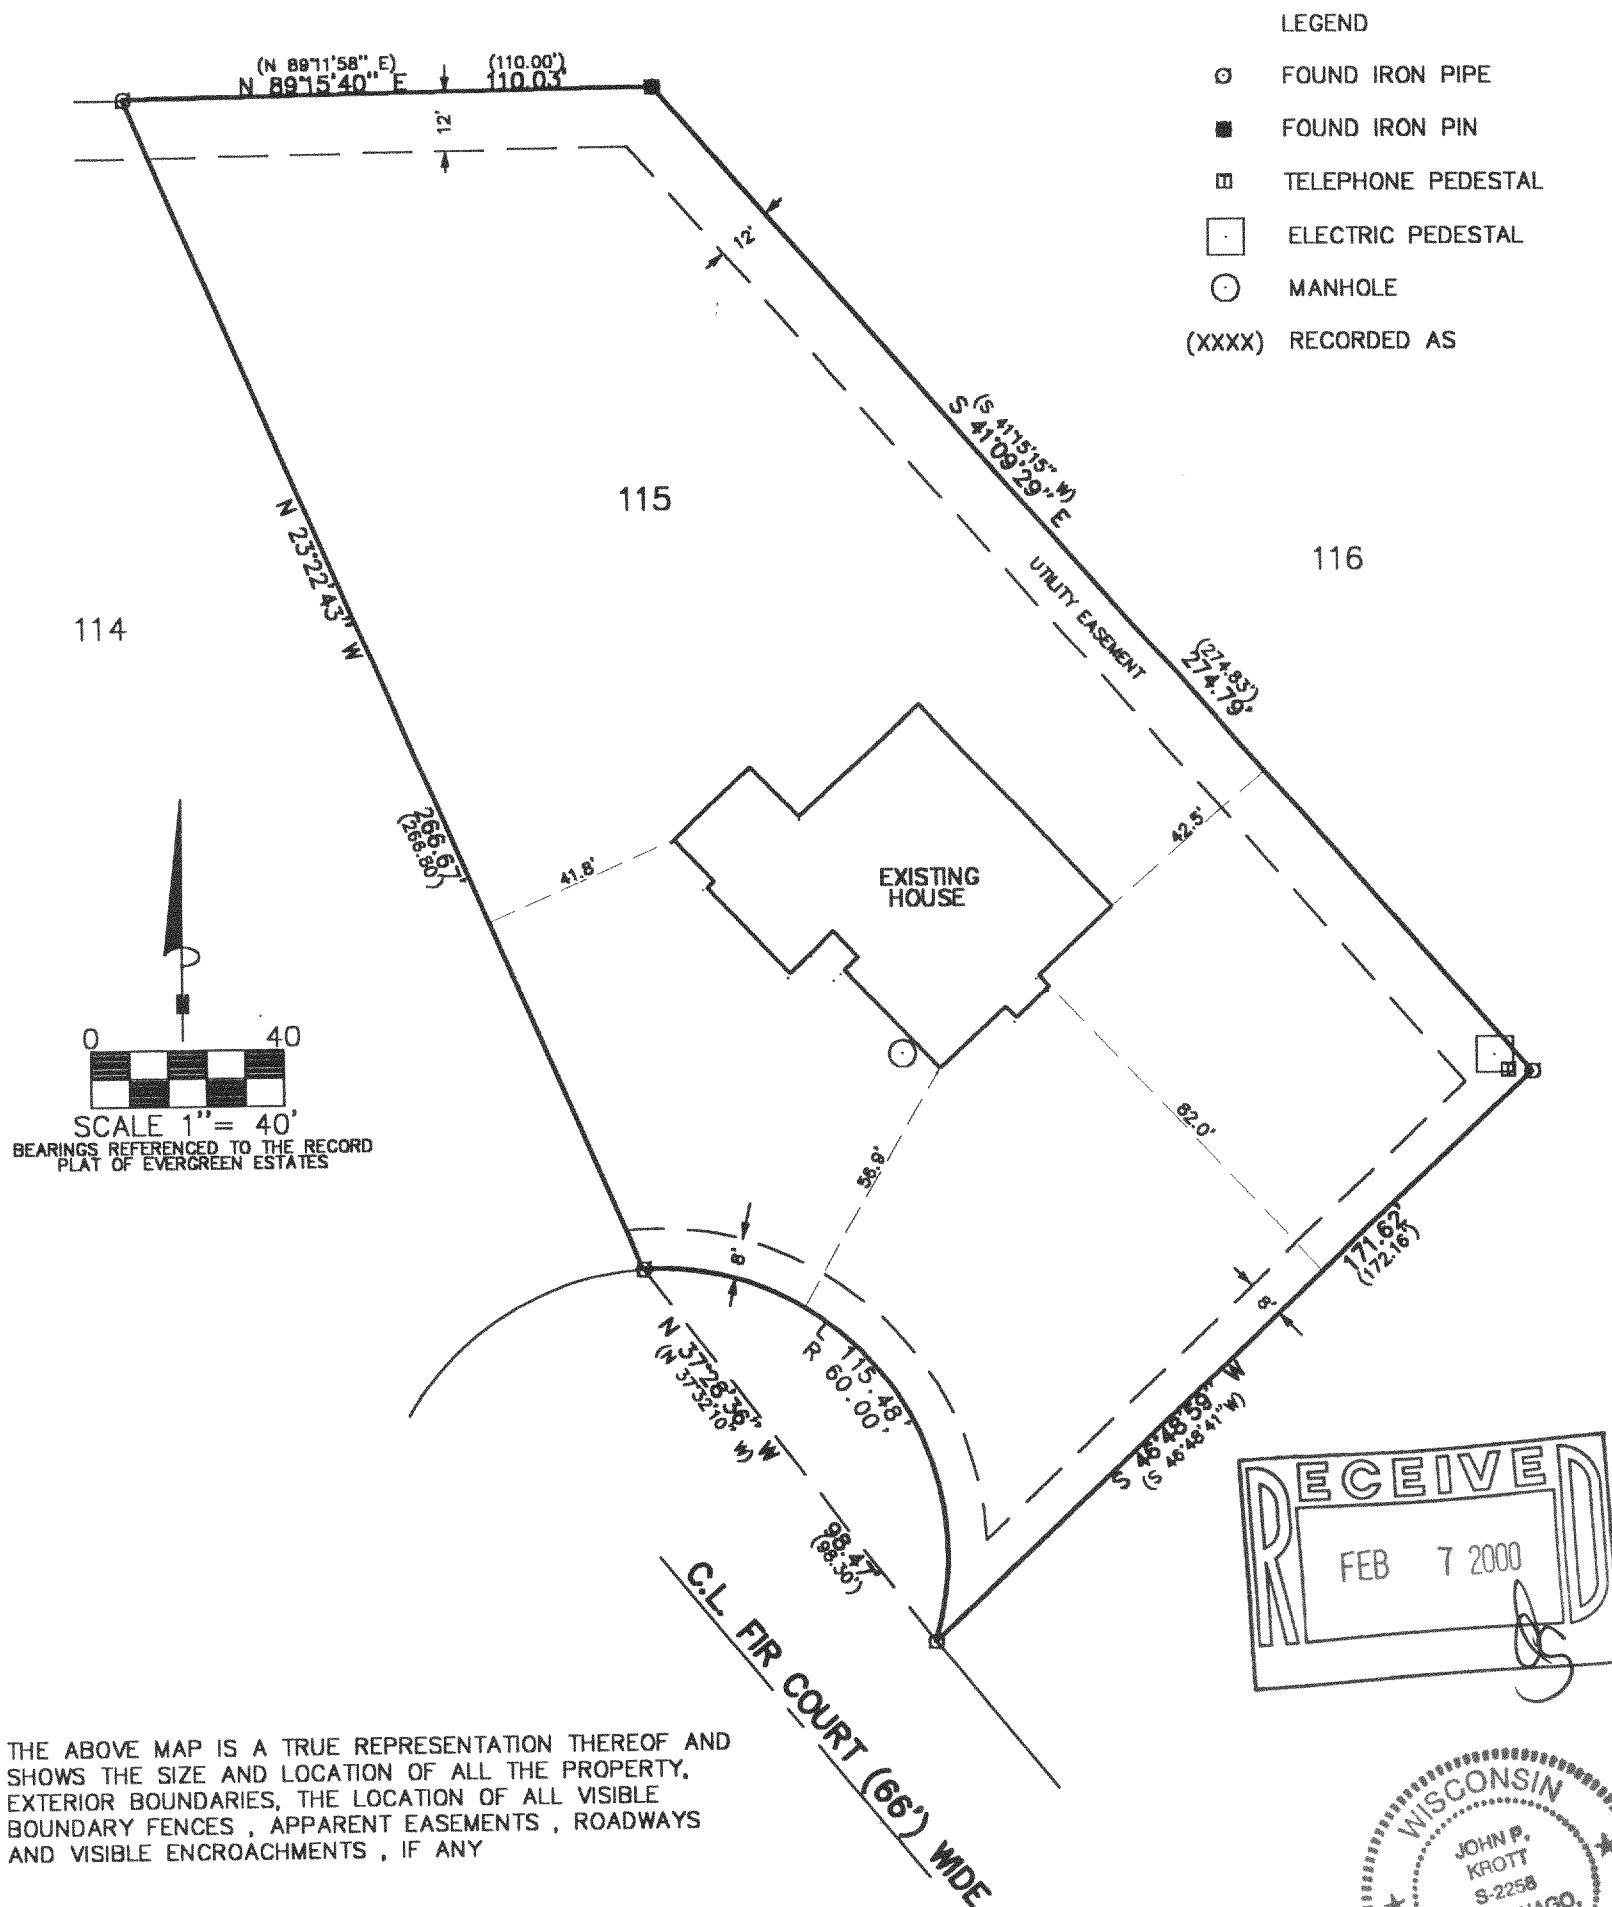

John P. Krott
JOHN P. KROTT, R.L.S. 2258

NOTE: THIS IS NOT A CERTIFIED COPY
UNLESS SEAL IS IN RED.
JOB NUMBER #99223 3-17-KE 115

KE-115

317-473