

ABERNATHY and ASSOCIATES



Kenneth B. Abernathy Jr.

Wisconsin Registered Land Surveyor S-1594

W4056 BRAY RD.
ELKHORN, WI. 53121
PHONE: (262) 723-4260 (OFFICE)
(262) 723-7209 (FAX)
Email: abernathy@elknet.net

PLAT OF SURVEY

ORDERED BY: MIKE MERATH
1986 DIVISION ST.
EAST TROY, WI. 53120

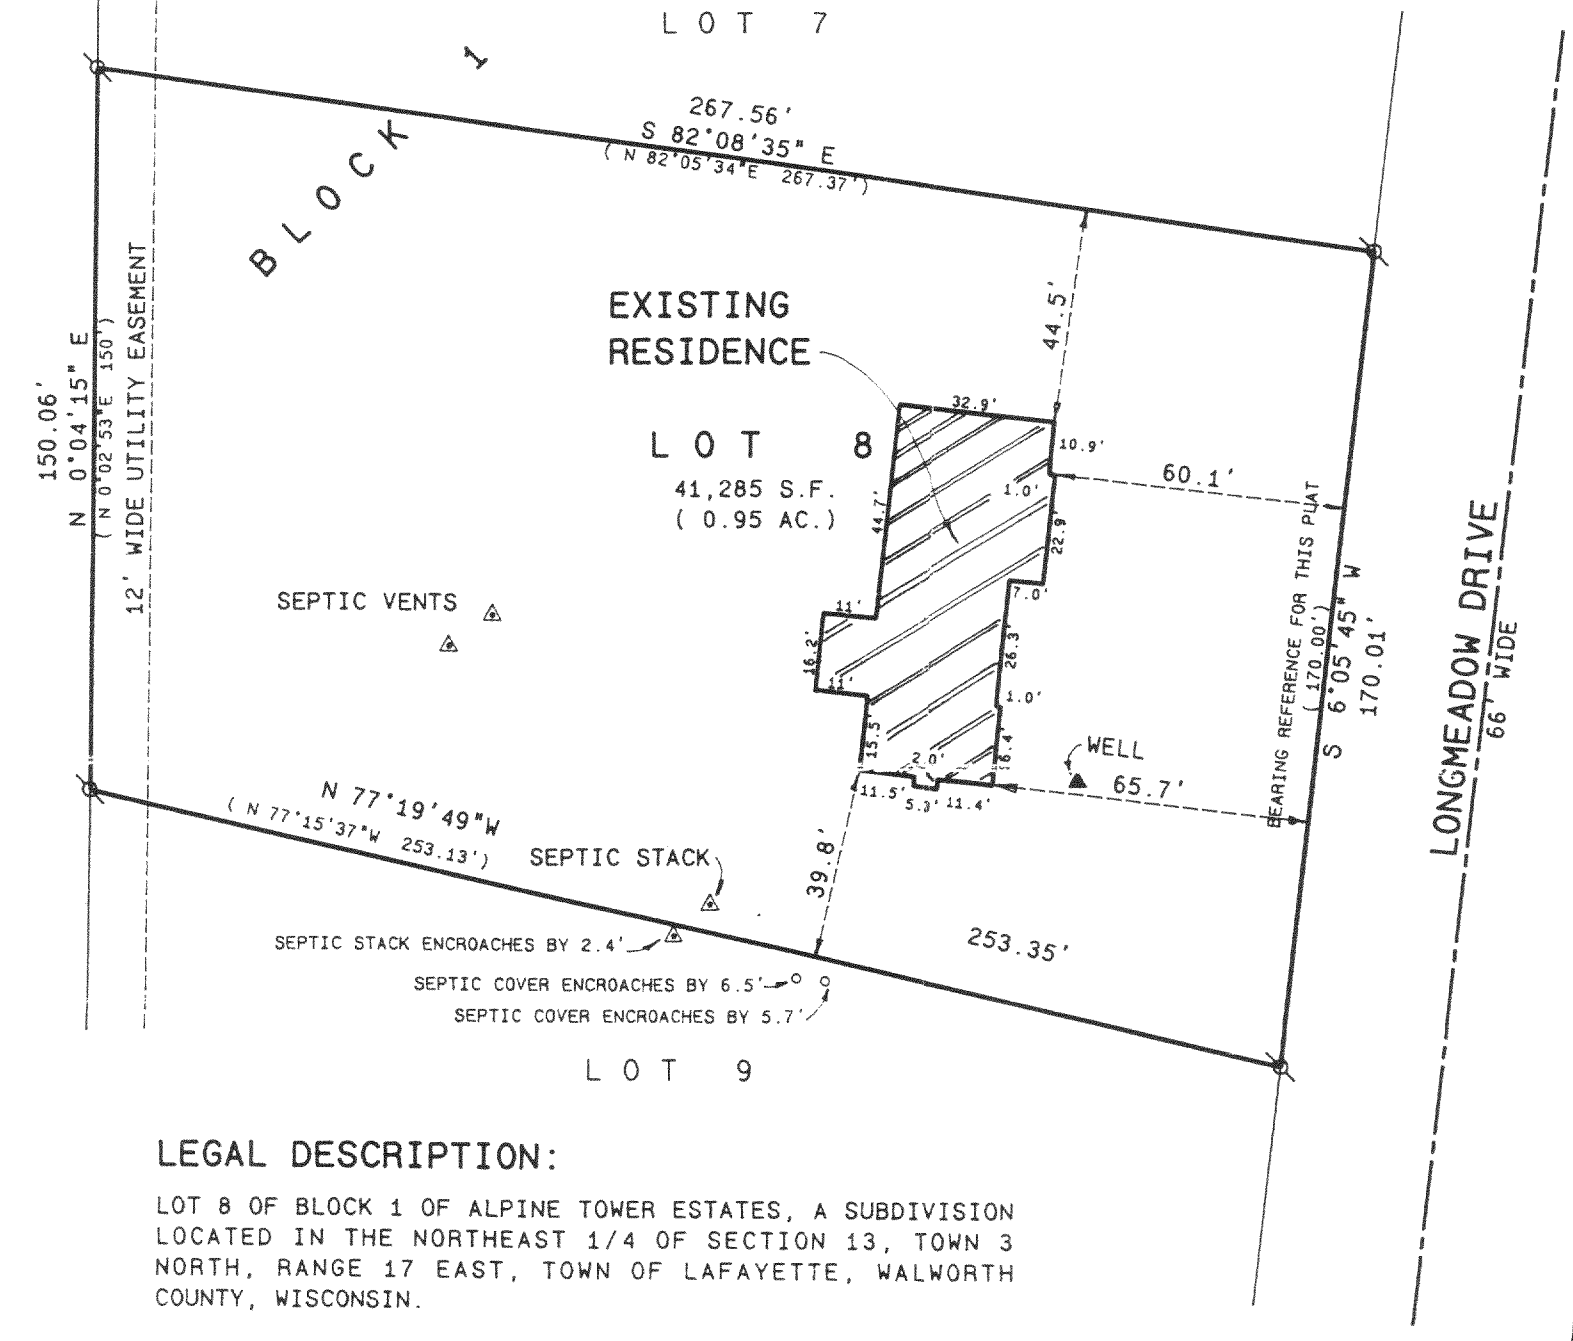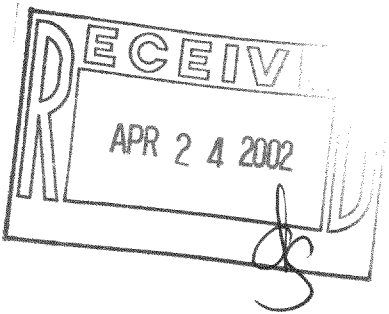

LEGAL DESCRIPTION:

LOT 8 OF BLOCK 1 OF ALPINE TOWER ESTATES, A SUBDIVISION
LOCATED IN THE NORTHEAST 1/4 OF SECTION 13, TOWN 3
NORTH, RANGE 17 EAST, TOWN OF LAFAYETTE, WALWORTH
COUNTY, WISCONSIN.

Legend

- FOUND IRON PIPE
- FOUND IRON ROD
- FOUND BRASS CAPPED MONUMENT
- FOUND CONCRETE MONUMENT
- CHISEL CUT IN CONCRETE
- SET IRON ROD, 24" LONG, WEIGHING 1.5 LBS./LINEAL FT., 3/4" DIA.
- SET IRON ROD, 30" LONG, WEIGHING 4.5 LBS./LINEAL FT., 1-11/16" DIA.
- (xx) RECORDED AS DIMENSION
- EXISTING FENCE



SCALE: 1"= 40 FEET

"I hereby certify that the above described property has been surveyed by me or under my direction and that the above map is a true representation thereof and shows the size and location of the property, its exterior boundaries, the location of all visible structures and dimensions of all principal buildings thereon, boundary fences, apparent easements, roadways and visible encroachments, if any."
"This survey is made for the use of the present owners of the property, and also those who purchase, mortgage, or guarantee the title thereto within one year from date hereof."

Kenneth B. Abernathy, Jr.

KENNETH B. ABERNATHY, JR.
WISCONSIN REGISTERED LAND SURVEYOR,
S-1594
Date: 11/1/01 Job No. 00.607

REVISED 4/30/01 TO SHOW PROPOSED RESIDENCE
REVISED 7/16/01 MOVED RESIDENCE 10' WEST
REVISED 11/01/01 TO SHOW "AS BUILT" RESIDENCE