


PREPARED FOR:  
TOM MARTIN  
KEEFE REAL ESTATE, INC.  
908 A WISCONSIN ST.  
ELKHORN, WI 53121

# PLAT OF SURVEY

- OF -

LOT 136, EVERGREEN ESTATES  
LOCATED IN SECTION 18, T3N, R17E  
WALWORTH COUNTY, WISCONSIN

J.K. SURVEYING INC.  
N3705 WILLOWBEND LANE  
LAKE GENEVA, WI, 53147  
262-248-3697

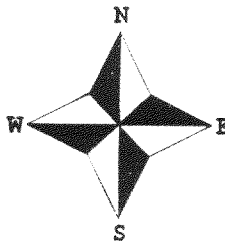


- ( ) = recorded as  
□ = found iron bar  
○ = found iron pipe  
● = set iron pipe  
■ = set iron bar


SCALE 1" = 40'

JOB # 03-038A

TAX ID # KE 00134

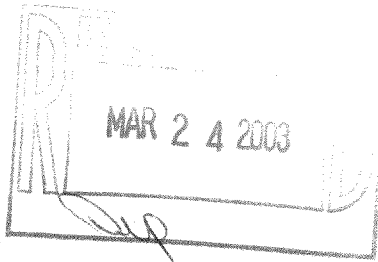

C.L., U.S. HWY. 12 & S.T.H. 67

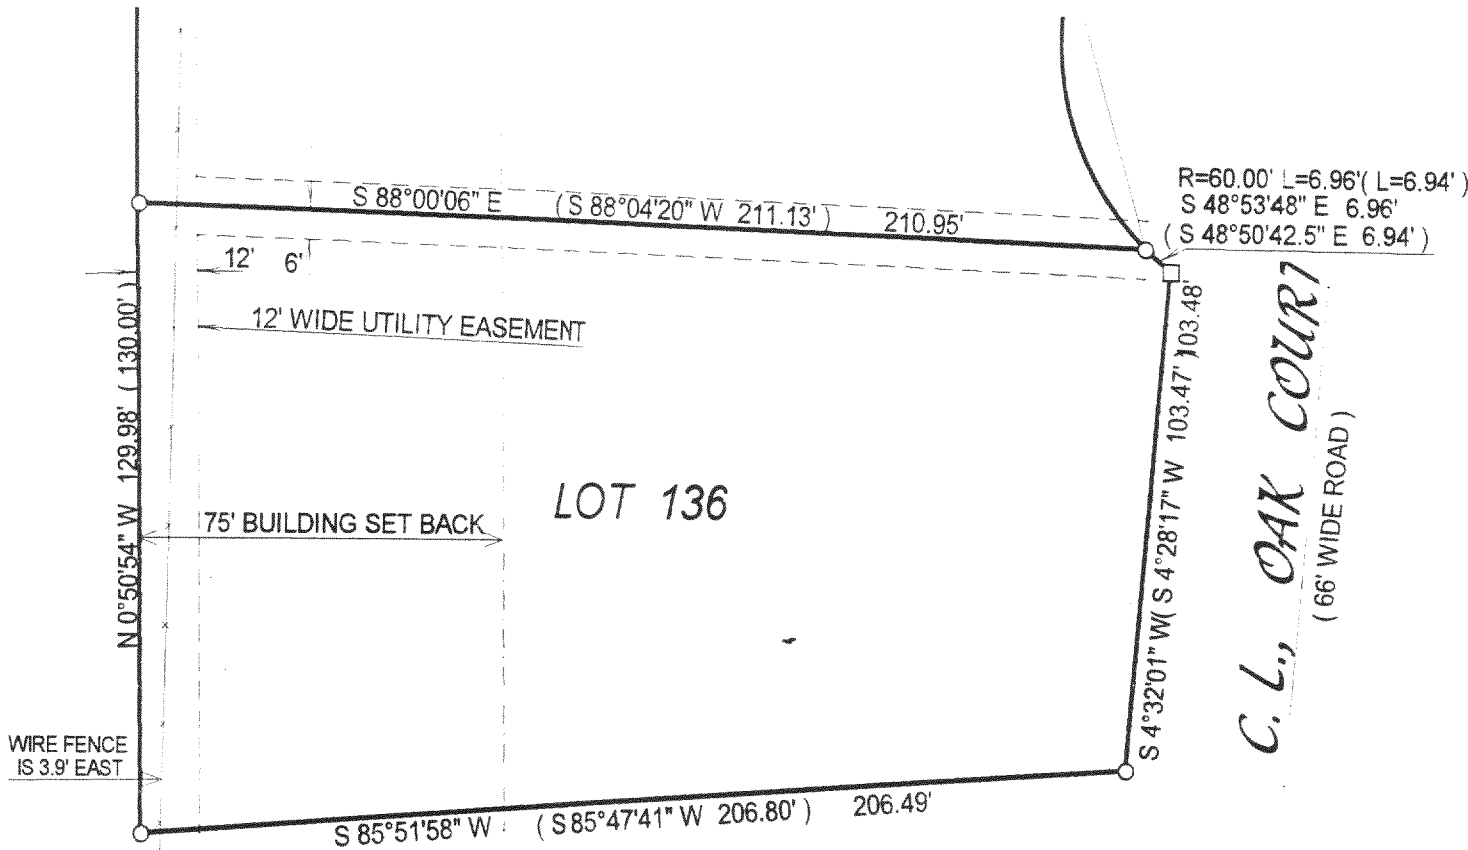

COMPARE LEGAL DESCRIPTION ABOVE AND DRAWING WITH DEED. FOR BUILDING RESTRICTIONS AND EASEMENTS NOT SHOWN, REFER TO DEED, ABSTRACT SOURCES AND LOCAL MUNICIPAL CODES. NOTIFY THE SURVEYOR IMMEDIATELY OF ANY DISCREPANCY.

"I hereby certify that I have surveyed the above described property and that the above map is a true representation thereof and shows the size and location of all visible structures, apparent easements and encroachments if any."

This survey is made for the present owners of the property, and those who purchase, mortgage, or guarantee the title thereto, within one year from the date hereof.



*John P. Krott*  
JOHN KROTT S - 2258  
Wisconsin Registered Land Surveyor  
(original if signed in red)

DATED THIS 28th, DAY OF JANUARY, 2003

317-568