PREPARED FOR:

H & R CONSTRUCTION 1629 SHERMAN RD. JACKSON, WI 53037


PLAT OF SURVEY

- OF -

J.K. SURVEYING INC. N3705 WILLOWBEND LANE LAKE GENEVA, WI, 53147 262-248-3697

UNIT 33 OF PHASE 2 ROLLING GREEN ESTATES, A CONDOMINIUM LOCATED IN, THE SOUTHEAST 1/4 AND THE SOUTH WEST 1/4 OF SECTION 18, TOWN 3 NORTH, RANGE 17 EAST, TOWN OF LAFAYETTE WALWORTH COUNTY, WISCONSIN.

CL. BRIAR DRIVE (66.00' WIDE ROAD)

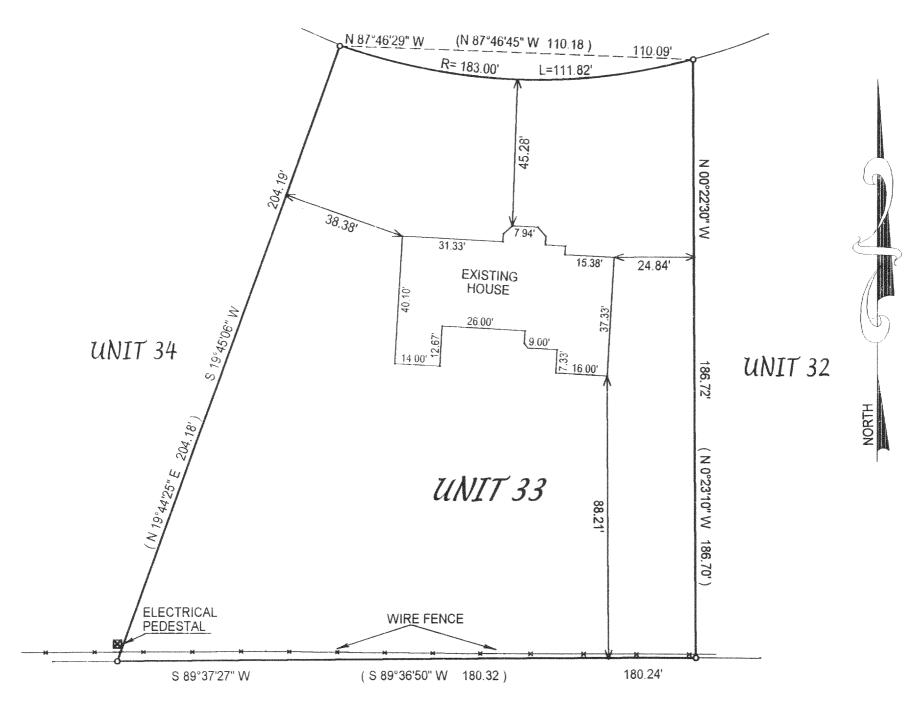

()= recorded as

□ = found iron bar

O = found iron pipe

= set iron pipe

= set iron bar

SCALE 1" =30'

JOB #01-357PH2

TAX ID # KRG 00033



DATE OF LAST REVISION 2 / 27 / 2003 REVISED 12 / 17 / 2002 REVISED 11 / 21 / 2002

COMPARE LEGAL DESCRIPTION ABOVE AND DRAWING WITH DEED FOR BUILDING RESTRICTIONS AND EASEMENTS NOT SHOWN REFER TO DEED. ABSTRACT SOURCES AND LOCAL MUNICIPAL CODES NOTIFY THE SURVEYOR IMMEDIATELY OF ANY DISCREPANCY.

"I hereby certify that I have surveyed the above described property and that the above map is a true representation thereof and shows the size and location of all visible structures, apparent easements and encroachments if any."

This survey is made for the present owners of the property, and those who purchase, mortgage, or guarantee the title thereto, within one year from the date hereof.

DATED THIS 24TH, DAY OF AUGUST 2001



JOHN KROTT S - 2258 Wisconsin Registered Land Surveyor (original if signed in red)