ABERNATHY and ASSOCIATES

Kenneth B. Abernathy Jr.

W4056 BRAY RD. ELKHORN. WI. 53121

PHONE: (262) 723-4260 (OFFICE) (262) 723-7209 (FAX)

Wisconsin Registered Land Surveyor

S-1594


Email: abernathy@elknet.net

SURVEY PLAT

LOT 2 OF BROOKWOOD ESTATES, A SUBDIVISION LOCATED IN THE SOUTHWEST 1/4 AND THE NORTHWEST 1/4 AND THE NORTHEAST 1/4 OF THE NORTHWEST 1/4 OF SECTION 33, TOWN 3 NORTH, RANGE 17 EAST, TOWN OF LAFAYETTE. WALWORTH COUNTY, WISCONSIN.

ORDERED BY: STEBNITZ BUILDERS, INC. 1102 ANN DELAVAN, WI. 53115

OWNERS: CHRIS AND JILL STEBNITZ

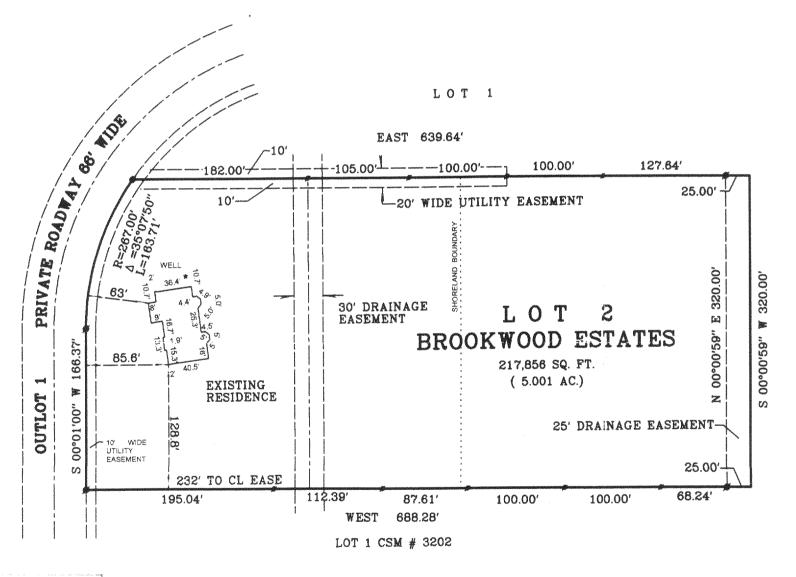

Legend

Ø	FOUND	IRON	PIPE
<i>-</i>	0 00 00 1 100	244 60.24	8 8 5 489

FOUND IRON ROD

FOUND BRASS CAPPED MONUMENT

0 FOUND CONCRETE MONUMENT


CHISEL CUT IN CONCRETE

SET IRON ROD, 24" LONG, WEIGHING 1.5 LBS./LINEAL FT., 3/4" DIA.

SET IRON ROD, 30" LONG, WEIGHING 4.5 LBS./LINEAL FT., 1-11/16" DIA.

RECORDED AS DIMENSION (xx)



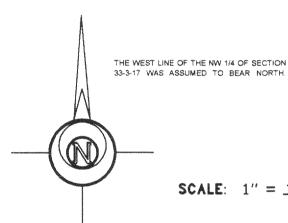

SCALE: 1" = 100' FEET

"I hereby certify that the above described property has been surveyed by me or under my property has been surveyed by me or under my direction and that the above map is a true representation thereof and shows the size and location of the property, its exterior boundaries, the location of all visible structures and dimensions of all principal buildings thereon, boundary fences, apparent easements, roadways and visible encroachments, if any "

"This survey is made for the use of the present owners of the property, and also those who purchase, mortgage, or guarantee the title thereto within one year from the date hereof."

KENNETH B. ABERNATHY, JR. WISCONSIN REGISTERED LAND SURVEYOR,

Date: AUG. 28, 2003

S - 1594

FEB 2 3 900

