



MASTERCRAFT BUILDERS
Tuescher #24066

LEGAL DESCRIPTION:

Survey No. 97331

Set
1" I.P.
936.73
EL

Set
1" I.P.
936.08
EL

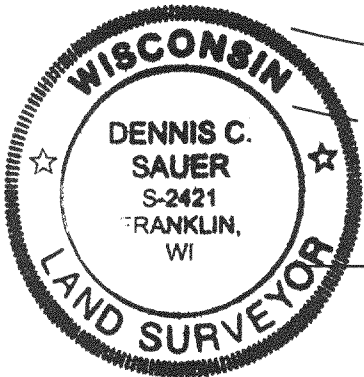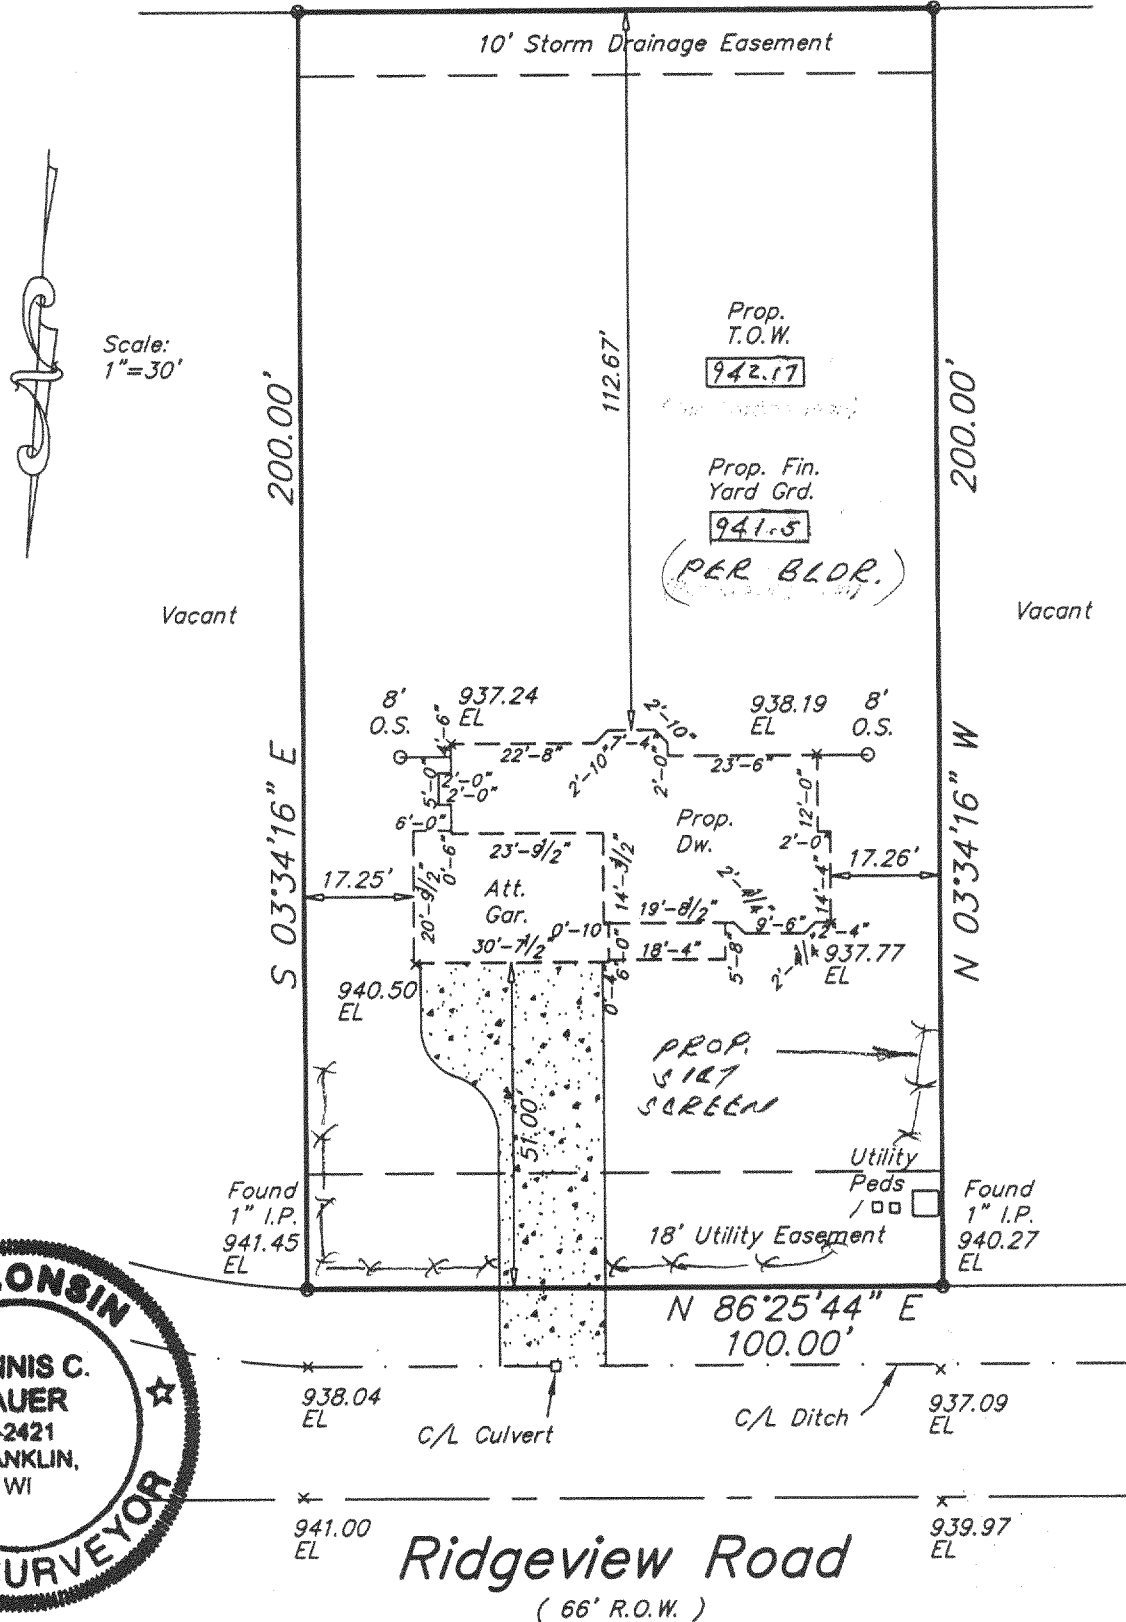


email address survey@execpc.com

SIGNED

Dennis C. Sauer

Registered Land Surveyor S-2421

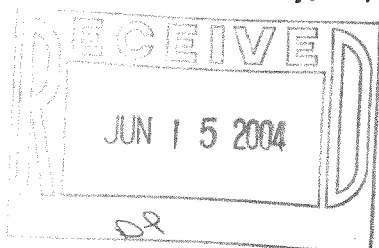

KRID 00012

317-697