


PREPARED FOR : TOM MARTIN  
KEEFE REAL ESTATE INC.  
980-A N. WISCONSIN ST.  
ELKHORN WI. 53121

# PLAT OF SURVEY

J.K. SURVEYING INC.  
N3705 WILLOWBEND LANE  
LAKE GENEVA, WI, 53147  
262-248-3697

- OF -

UNIT 45 OF PHASE 2 ROLLING GREEN COUNTRY ESTATES, LOCATED  
IN THE SE 1/4 AND SW 1/4 OF SECTION 18, TOWN 3 NORTH, RANGE 17  
EAST, TOWN OF LAFAYETTE, WALWORTH COUNTY, WISCONSIN.

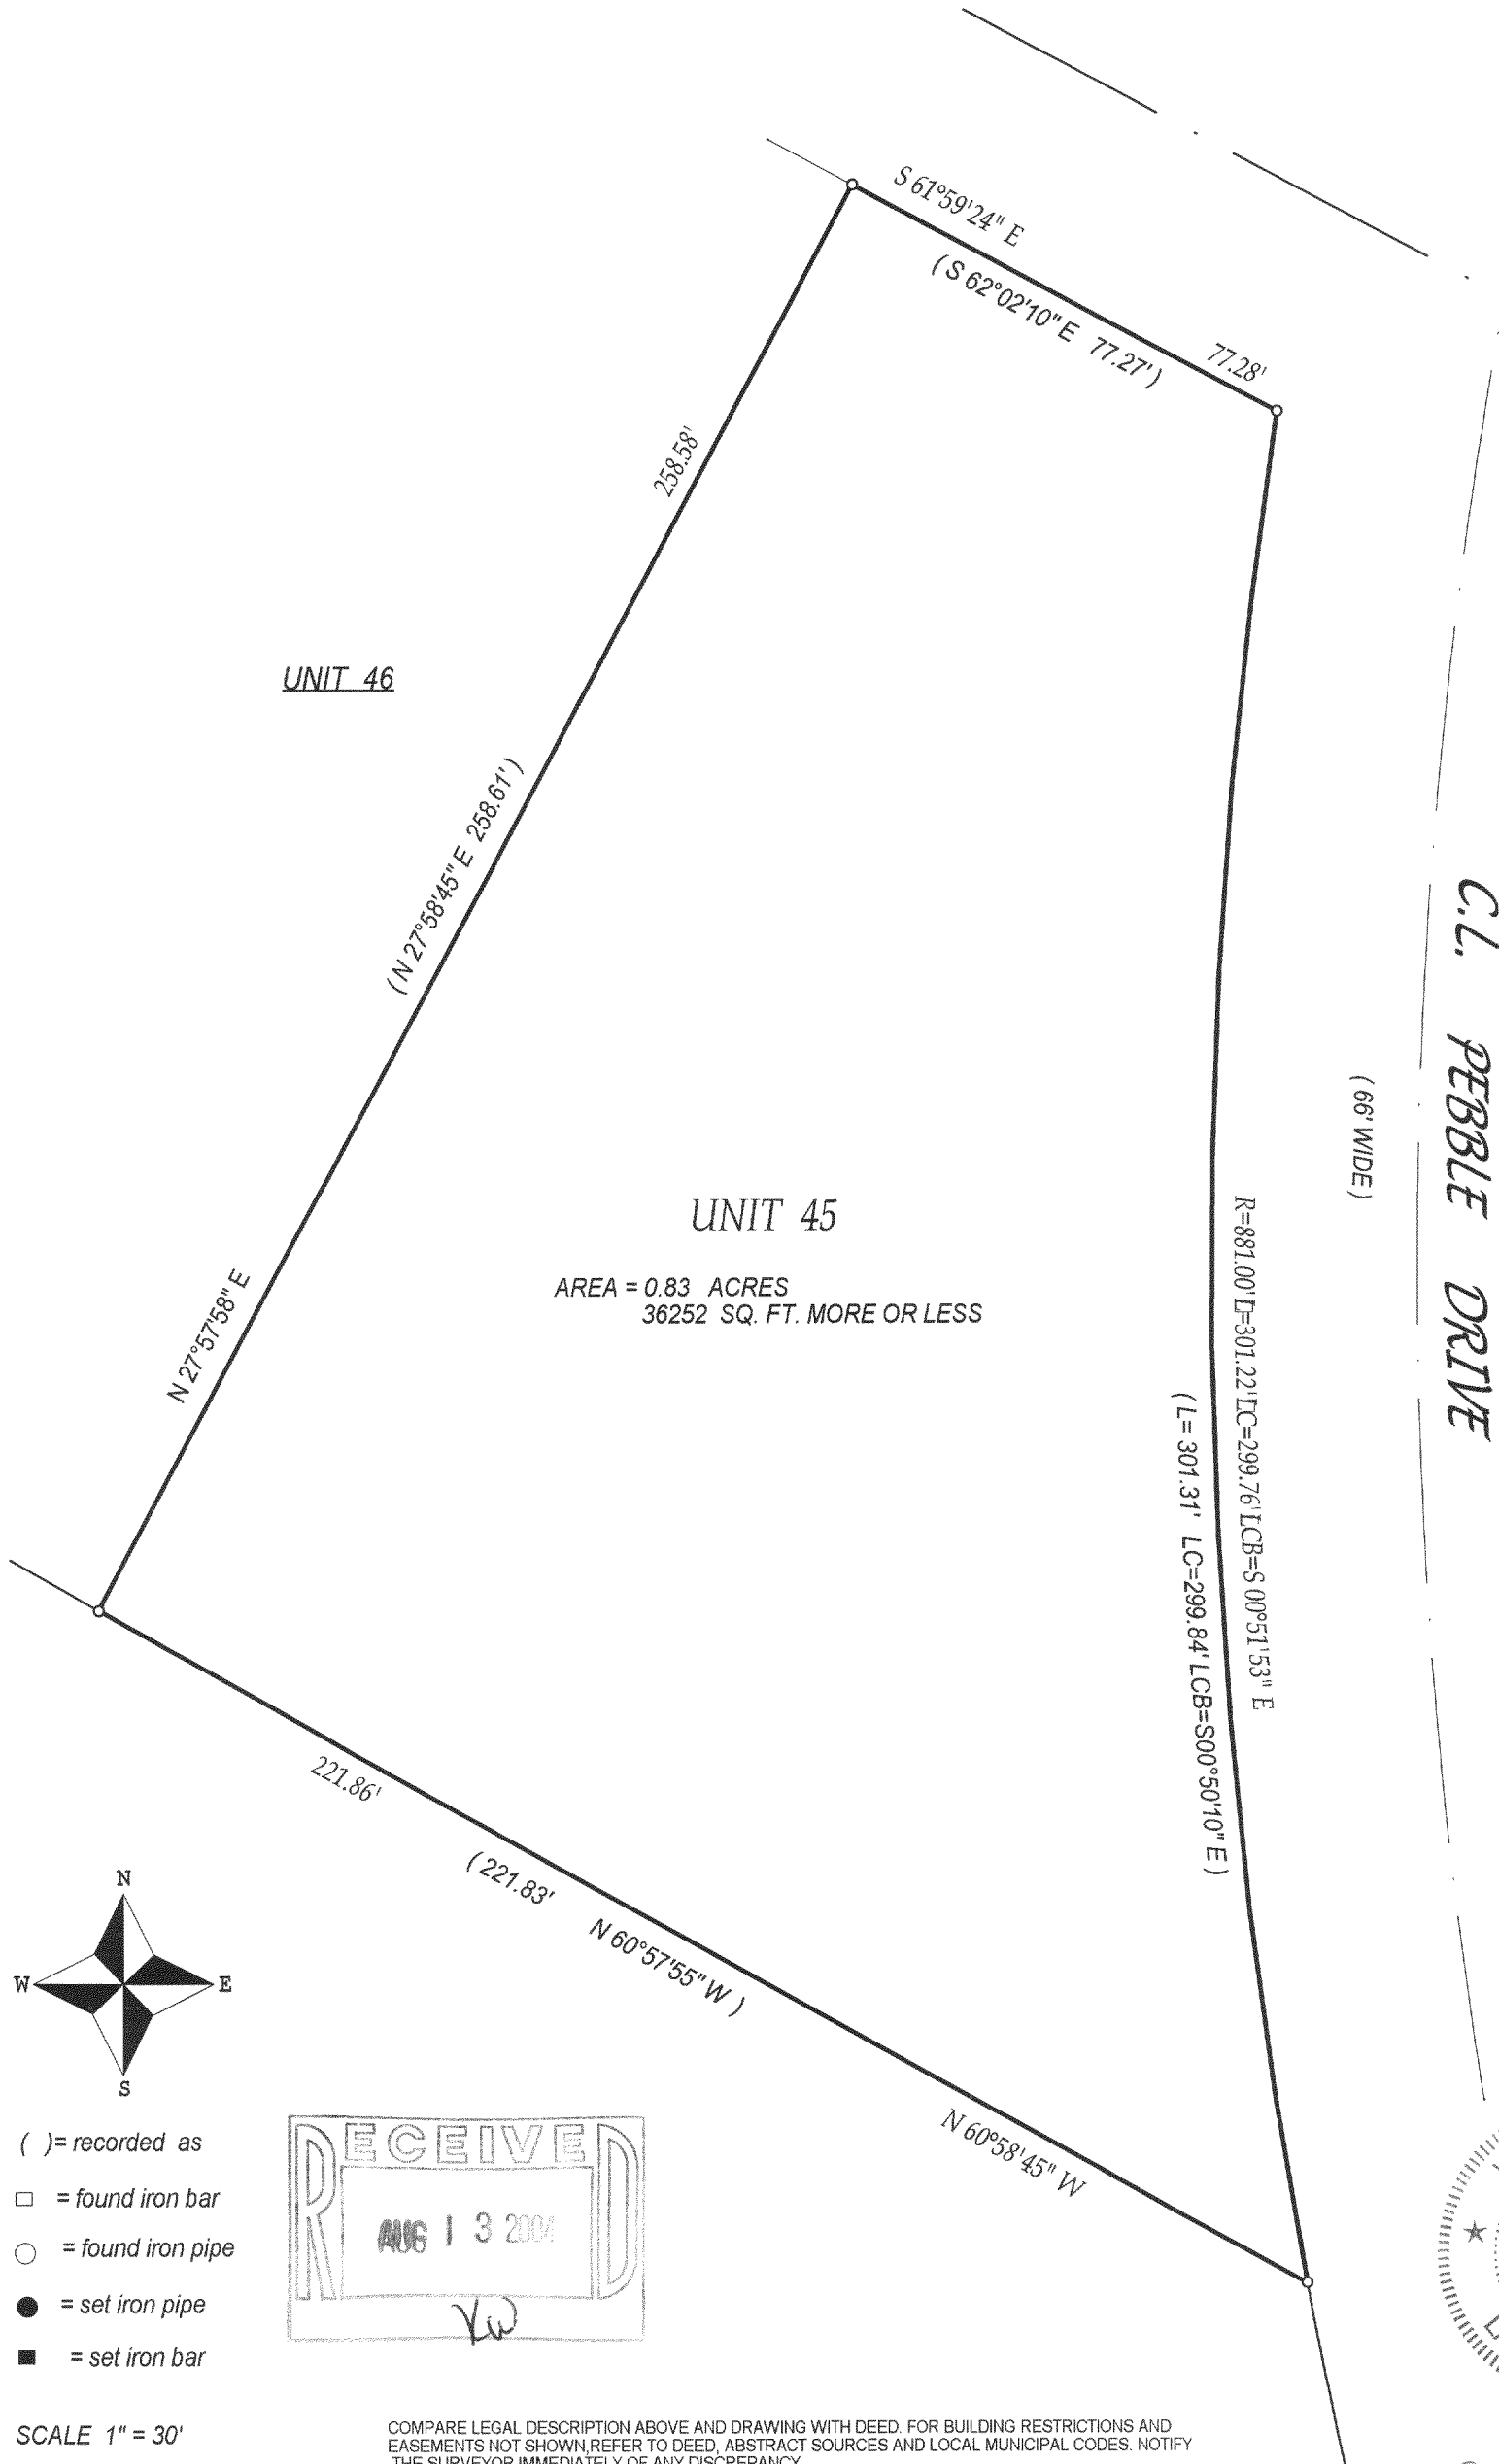

317-735