

# LAND-MARK SURVEYING

Mark L. Miritz

Wisconsin Registered Land Surveyor S-2582

N9330 Knuteson Drive  
Whitewater, WI 53190  
Phone: (262) 495-3284  
FAX : (262) 495-8421  
LAND-MARKSURVEYING.COM

## PLAT OF SURVEY



LOT 2 CERTIFIED SURVEY MAP NO. 2068, LOCATED IN  
THE NORTHEAST 1/4 OF THE SOUTHWEST 1/4 OF SECTION  
19, TOWN 3 NORTH, RANGE 17 EAST, WALWORTH COUNTY,  
WISCONSIN.

ORDERED BY: SUE MILLER

WHISPERING OAKS REALTY  
P.O. BOX 961  
EAST TROY, WI. 53120

OWNERS: MARSHALL B. KETCHPAW

SUSAN L. KETCHPAW  
W4715 POTTER RD.  
ELKHORN, WI. 53121

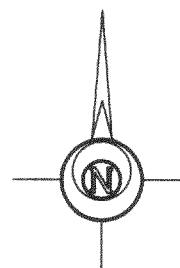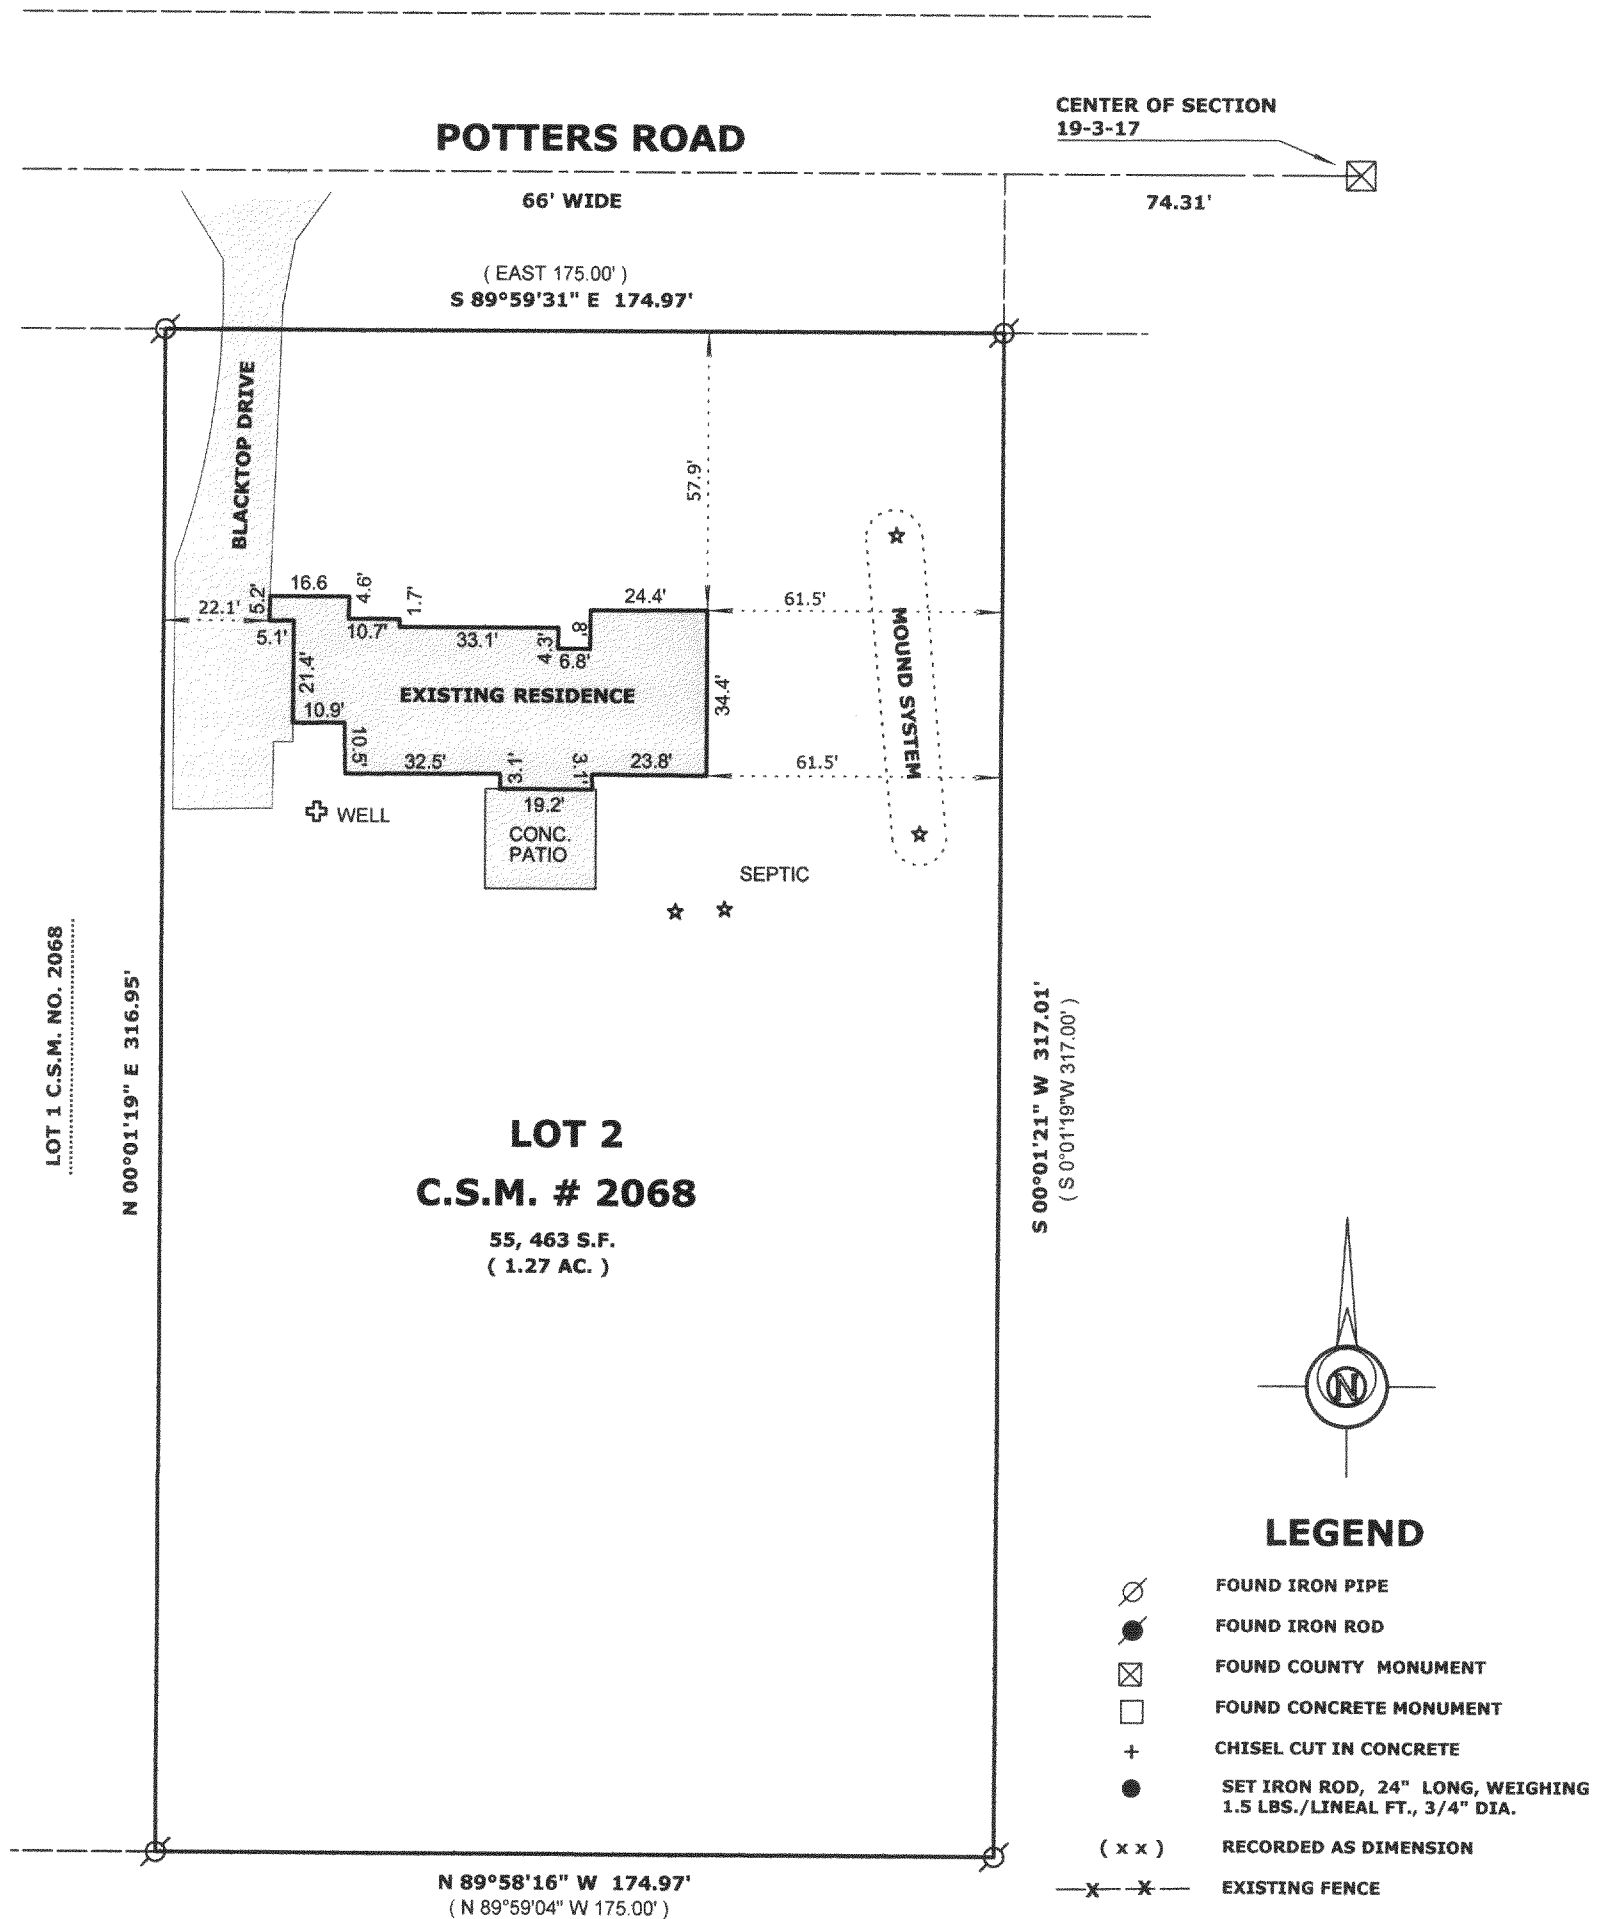

### LEGEND

- FOUND IRON PIPE
- FOUND IRON ROD
- FOUND COUNTY MONUMENT
- FOUND CONCRETE MONUMENT
- CHISEL CUT IN CONCRETE
- SET IRON ROD, 24" LONG, WEIGHING 1.5 LBS./LINEAL FT., 3/4" DIA.
- RECORDED AS DIMENSION
- EXISTING FENCE

SCALE: 1" = 40 FEET

"I hereby certify that the above described property has been surveyed by me or under my direction and that the above map is a true representation thereof and shows the size and location of the property, its exterior boundaries, the location of all visible structures and dimensions of all principal buildings thereon, boundary fences, apparent easements, roadways and visible encroachments, if any."

"This survey is made for the use of the present owners of the property, and also those who purchase, mortgage, or guarantee the title thereto within one year from date hereof."

*Mark L. Miritz*  
**MARK L. MIRITZ**  
**WISCONSIN REGISTERED**  
**LAND SURVEYOR S-2582**

DATE: JUNE 9, 2005 JOB NO. 05.603



JUL 26 2005