
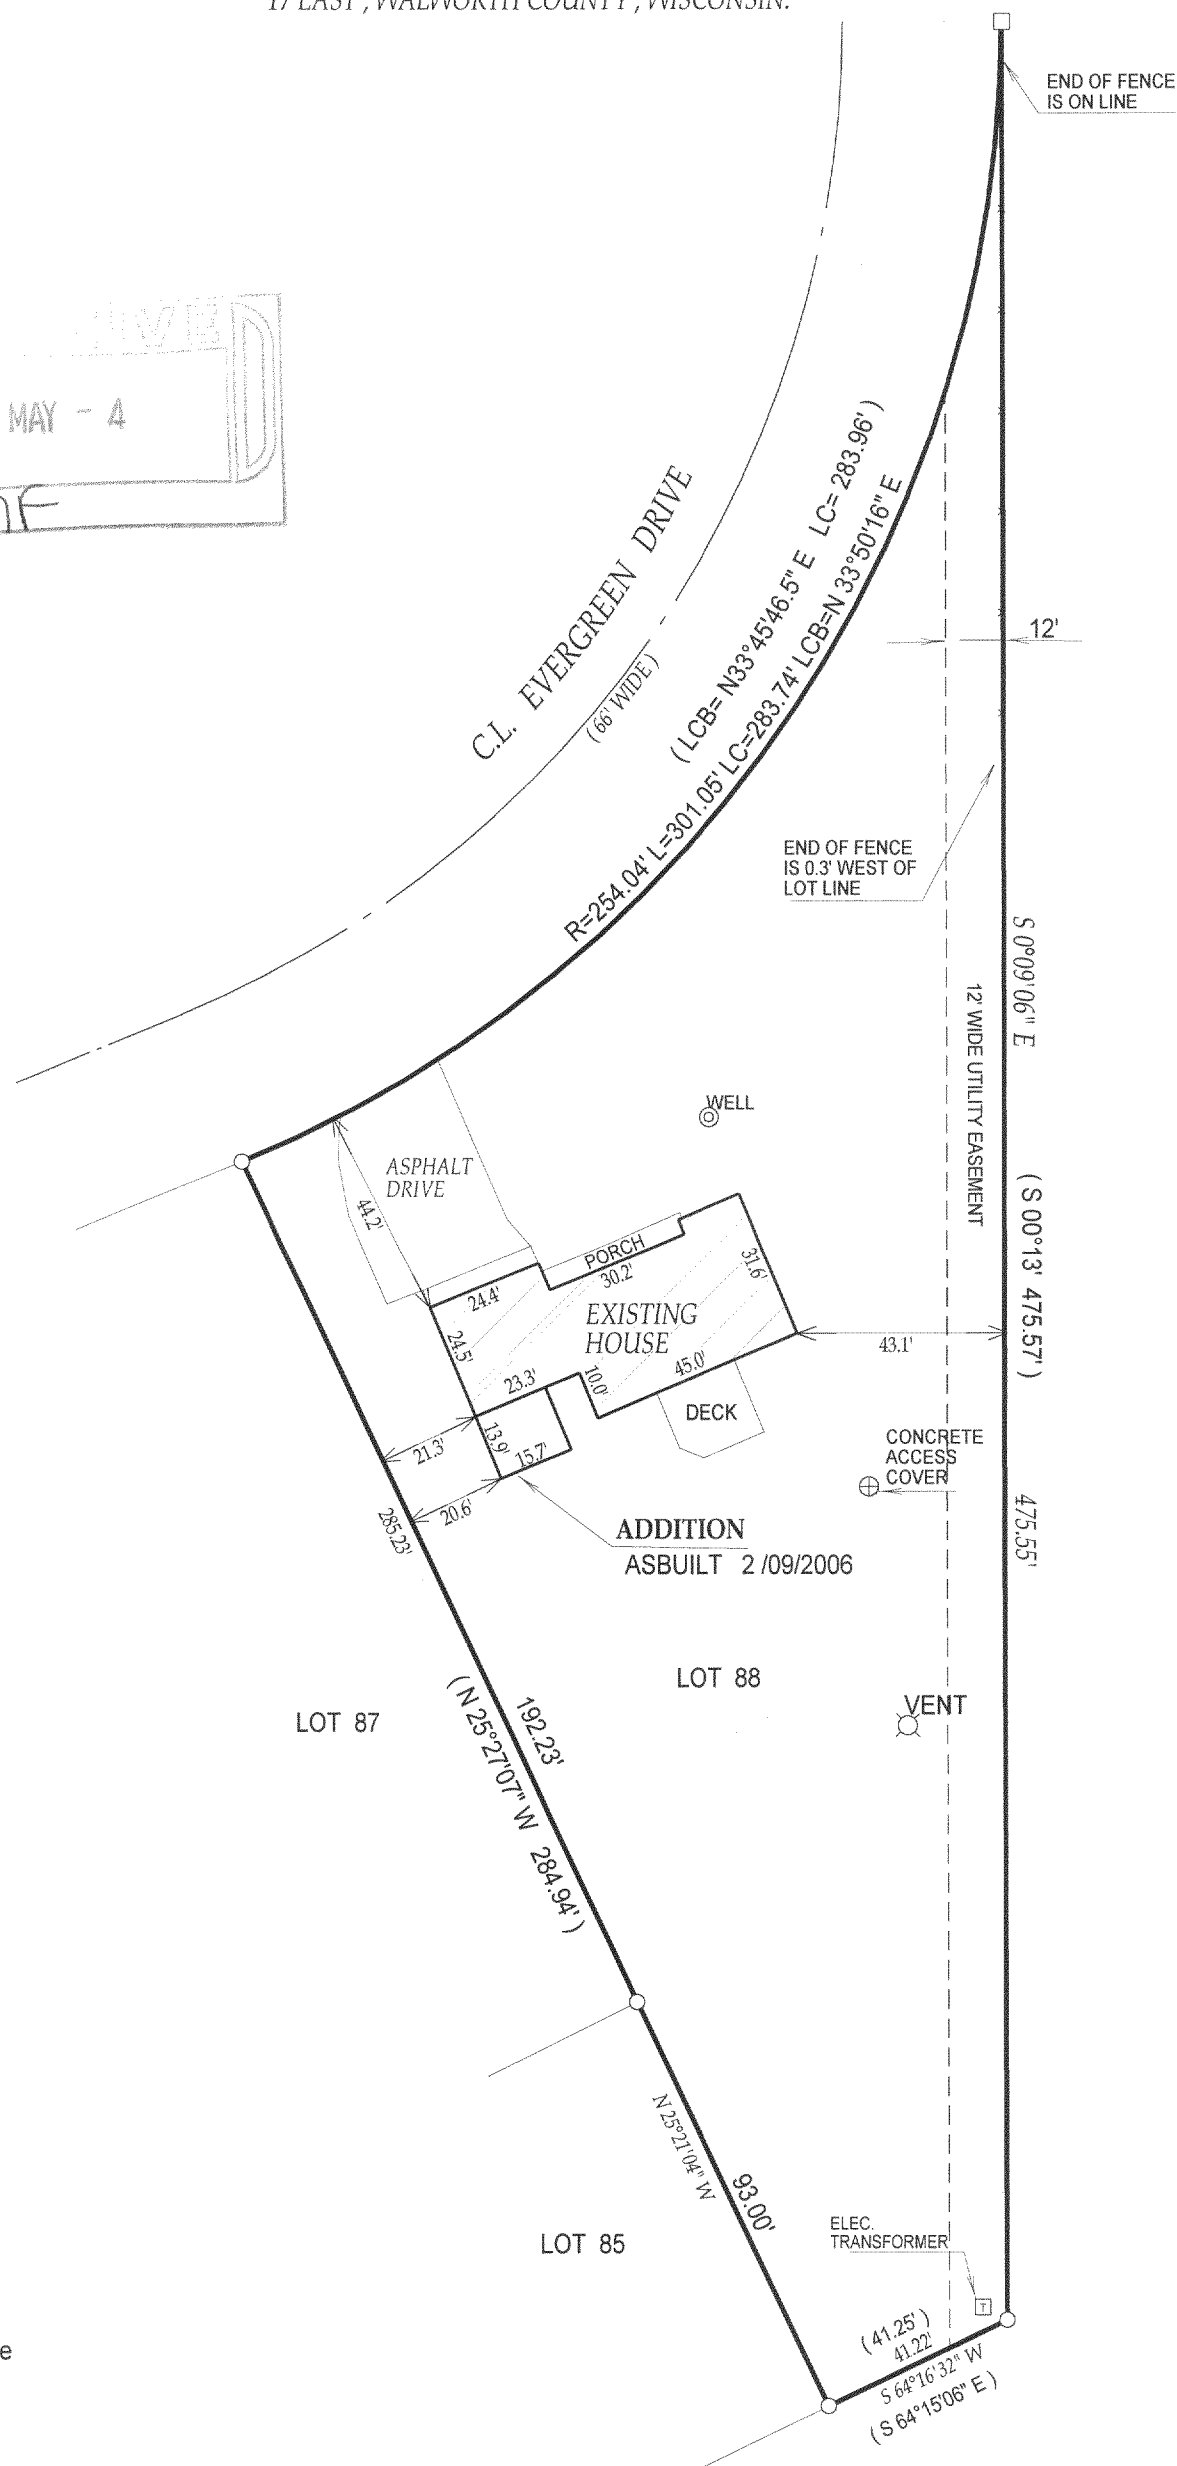


PLAT OF SURVEY

- OF -

PATHFINDER SURVEYING INC.
N3705 WILLOWBEND LANE
LAKE GENEVA, WI, 53147
262-248-3697

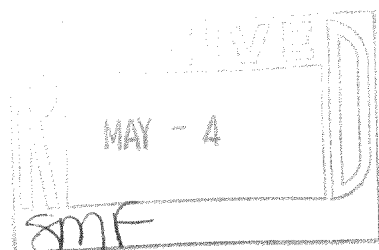

NORTH

- TAX ID # KE00088

This survey is made for the present owners of the property, and those who purchase, mortgage, or guarantee the title thereto, within one year from the date hereof.

DATED THIS 10th, DAY OF NOVEMBER, 2005



DATE OF LAST REVISION: 2 / 09 / 2006

JOHN KROTT S - 2258
Wisconsin Registered Land Surveyor
(original if signed in red)

KE-88

317-842