

**LAND-MARK SURVEYING**  
Mark L. Miritz



Wisconsin Registered Land Surveyor S-2582

N9330 Knuteson Drive  
Whitewater, WI 53190  
Phone: (262) 495-3284  
FAX: (262) 495-8421  
LAND-MARKSURVEYING.COM

**PLAT OF SURVEY**

**LOT 1 OF CERTIFIED SURVEY MAP NO. 3917 AS RECORDED IN VOLUME 24 OF CERTIFIED SURVEY MAPS AS PAGE 49, LOCATED IN THE NORTHEAST 1/4 OF THE SOUTHWEST 1/4 OF SECTION 6, TOWN 3 NORTH, RANGE 17 EAST, TOWN OF LAFAYETTE, WALWORTH COUNTY, WISCONSIN**

**OWNER: LAUDERDALE FARMS, INC.**  
W4726 COUNTY RD. "A"  
ELKHORN, WI. 53121

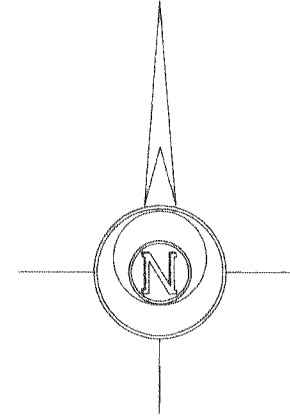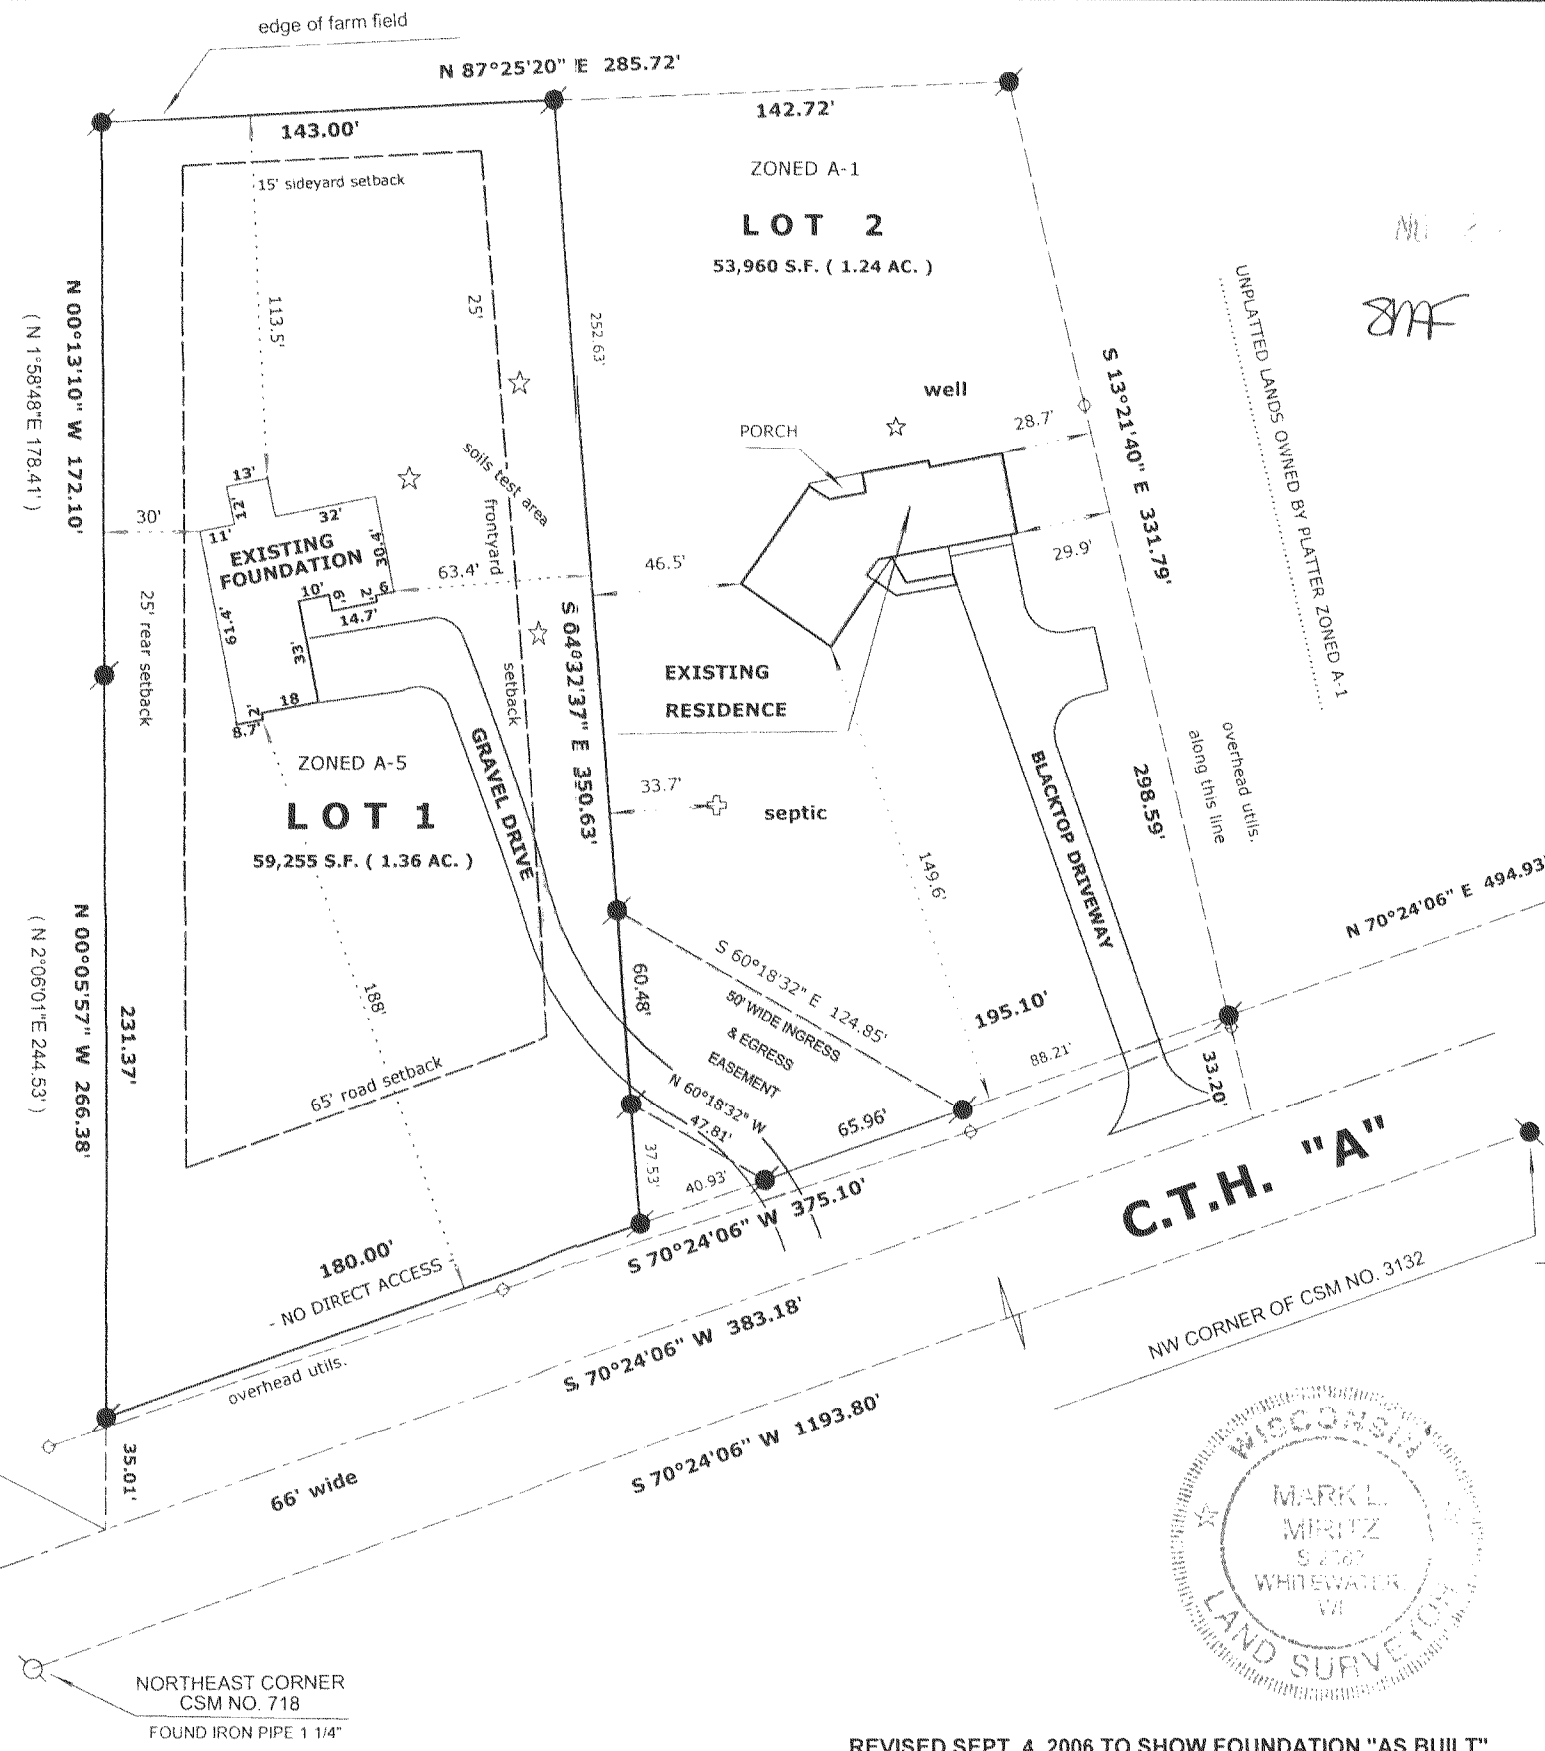

**LEGEND**

- FOUND IRON PIPE
- FOUND IRON ROD
- FOUND COUNTY MONUMENT
- 10' OFFSET STAKE
- CHISEL CUT IN CONCRETE
- SET IRON ROD, 24" LONG, WEIGHING 1.5 LBS./LINEAL FT., 3/4" DIA.
- RECORDED AS DIMENSION
- EXISTING FENCE

SCALE: 1" = 30 FEET

"I hereby certify that the above described property has been surveyed by me or under my direction and that the above map is a true representation thereof and shows the size and location of the property, its exterior boundaries, the location of all visible structures and dimensions of all principal buildings thereon, boundary fences, apparent easements, roadways and visible encroachments, if any."  
"This survey is made for the use of the present owners of the property, and also those who purchase, mortgage, or guarantee the title thereto within one year from date hereof."

*Mark L. Miritz*

**MARK L. MIRITZ**  
WISCONSIN REGISTERED  
LAND SURVEYOR S-2582



REVISED SEPT. 4, 2006 TO SHOW FOUNDATION "AS BUILT"

DATE: 6/05/06 JOB NO. 05.501

KA3917-1 KA3917-2

317-868