

# Plat of Survey

of

## Lot 2 of Certified Survey Map No. 3896,

recorded in Vol. 23 of Certified Survey Maps of Walworth County on Page 344 and located in the Northwest 1/4 of Section 28, Town 3 North, Range 17 East, Town of LaFayette, Walworth County, Wisconsin.

Surveyed for: **Kevin Robers**  
W4050 State Road 11  
Elkhorn, Wisconsin. 53121

Lot 1  
C.S.M. 3896

Tax Parcel  
KLF 2800004

Lot 1  
C.S.M. 3896

Lot 2  
3.029 Acres  
131,924 Sq.Ft.

New Metal Building  
Under Construction

Metal Building

Mound System

State Trunk Highway 11

Newman Drive


- Notes: 1) This survey plat is not certified unless signed and sealed in red ink.  
2) This survey is subject to Wisconsin lien laws. This Plat of Survey is the notice of intent to file lien. Lien waiver required.

Copyright © 2008 by Jensen & Olson Land Surveying, LLC.

All rights reserved. No part of this survey plat may be reproduced or transmitted in any form by any means - graphic, electronic, or mechanical, including photocopying, tracing, or information storage and retrieval systems - without permission in writing from Douglas G. Olson, Jensen & Olson Land Surveying, LLC.

I, Douglas G. Olson, Wisconsin Registered Land Surveyor, do hereby certify that this survey was performed by me or under my direction in full compliance with the owner's/agent's instructions and Chapter A-E 7 of the Wisconsin Administrative Code "Minimum Standards for Property Surveys"; and that this map is an accurate representation thereof to the best of my knowledge and belief.

Douglas G. Olson  
Wisconsin Registered Land Surveyor - 2093

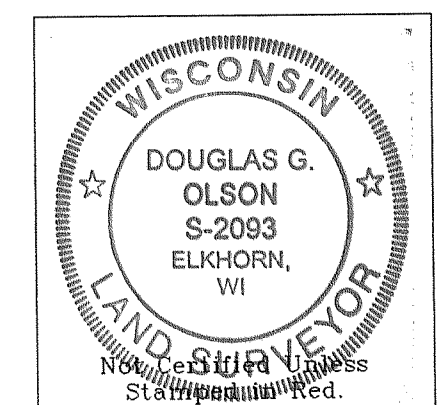

Survey Date: May 29, 2008  
Revisions:

Scale in Feet  
1" = 60'

Jensen & Olson Land Surveying, LLC  
45 South Wisconsin Street  
Elkhorn, Wisconsin. 53121  
Telephone (262) 723-3434  
Facsimile (262) 723-8044

Legend  
Found County Section Corner  
Found Iron Rod 3/4" dia.  
Recorded Information  
Utility Pole  
Concrete Corner  
Gravel Surface  
Access Restriction

Sheet 1 of 1 Sheets  
Job Reference Number  
2008.055

2008.055

KA3896-2

317-900