

PREPARED FOR
MARGARET CANFIELD
KEEFE REAL ESTATE
751 GENEVA PARKWAY
LAKE GENEVA WI 53147



PLAT OF SURVEY

-OF-

LOT 1 CERTIFIED SURVEY MAP NO. 2729 AS RECORDED IN VOLUME 14 OF
CERTIFIED SURVEY MAPS ON PAGE 73 AT THE WALWORTH COUNTY
REGISTER OF DEEDS OFFICE AND BEING LOCATED IN THE NORTHEAST 1/4
OF THE NORTHWEST 1/4 OF SECTION 11, TOWN 3 NORTH, RANGE 17 EAST,
TOWN OF LaFAYETTE, WALWORTH COUNTY, WISCONSIN.

KROTT SURVEYING INC.
N3705 WILLOW BEND LANE
LAKE GENEVA WI. 53147
PHONE # (262)248-3697
FAX # (262)249-0639

C.L. COUNTY TRUNK HIGHWAY "D"
(100' WIDE)

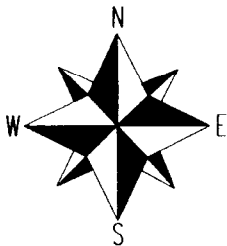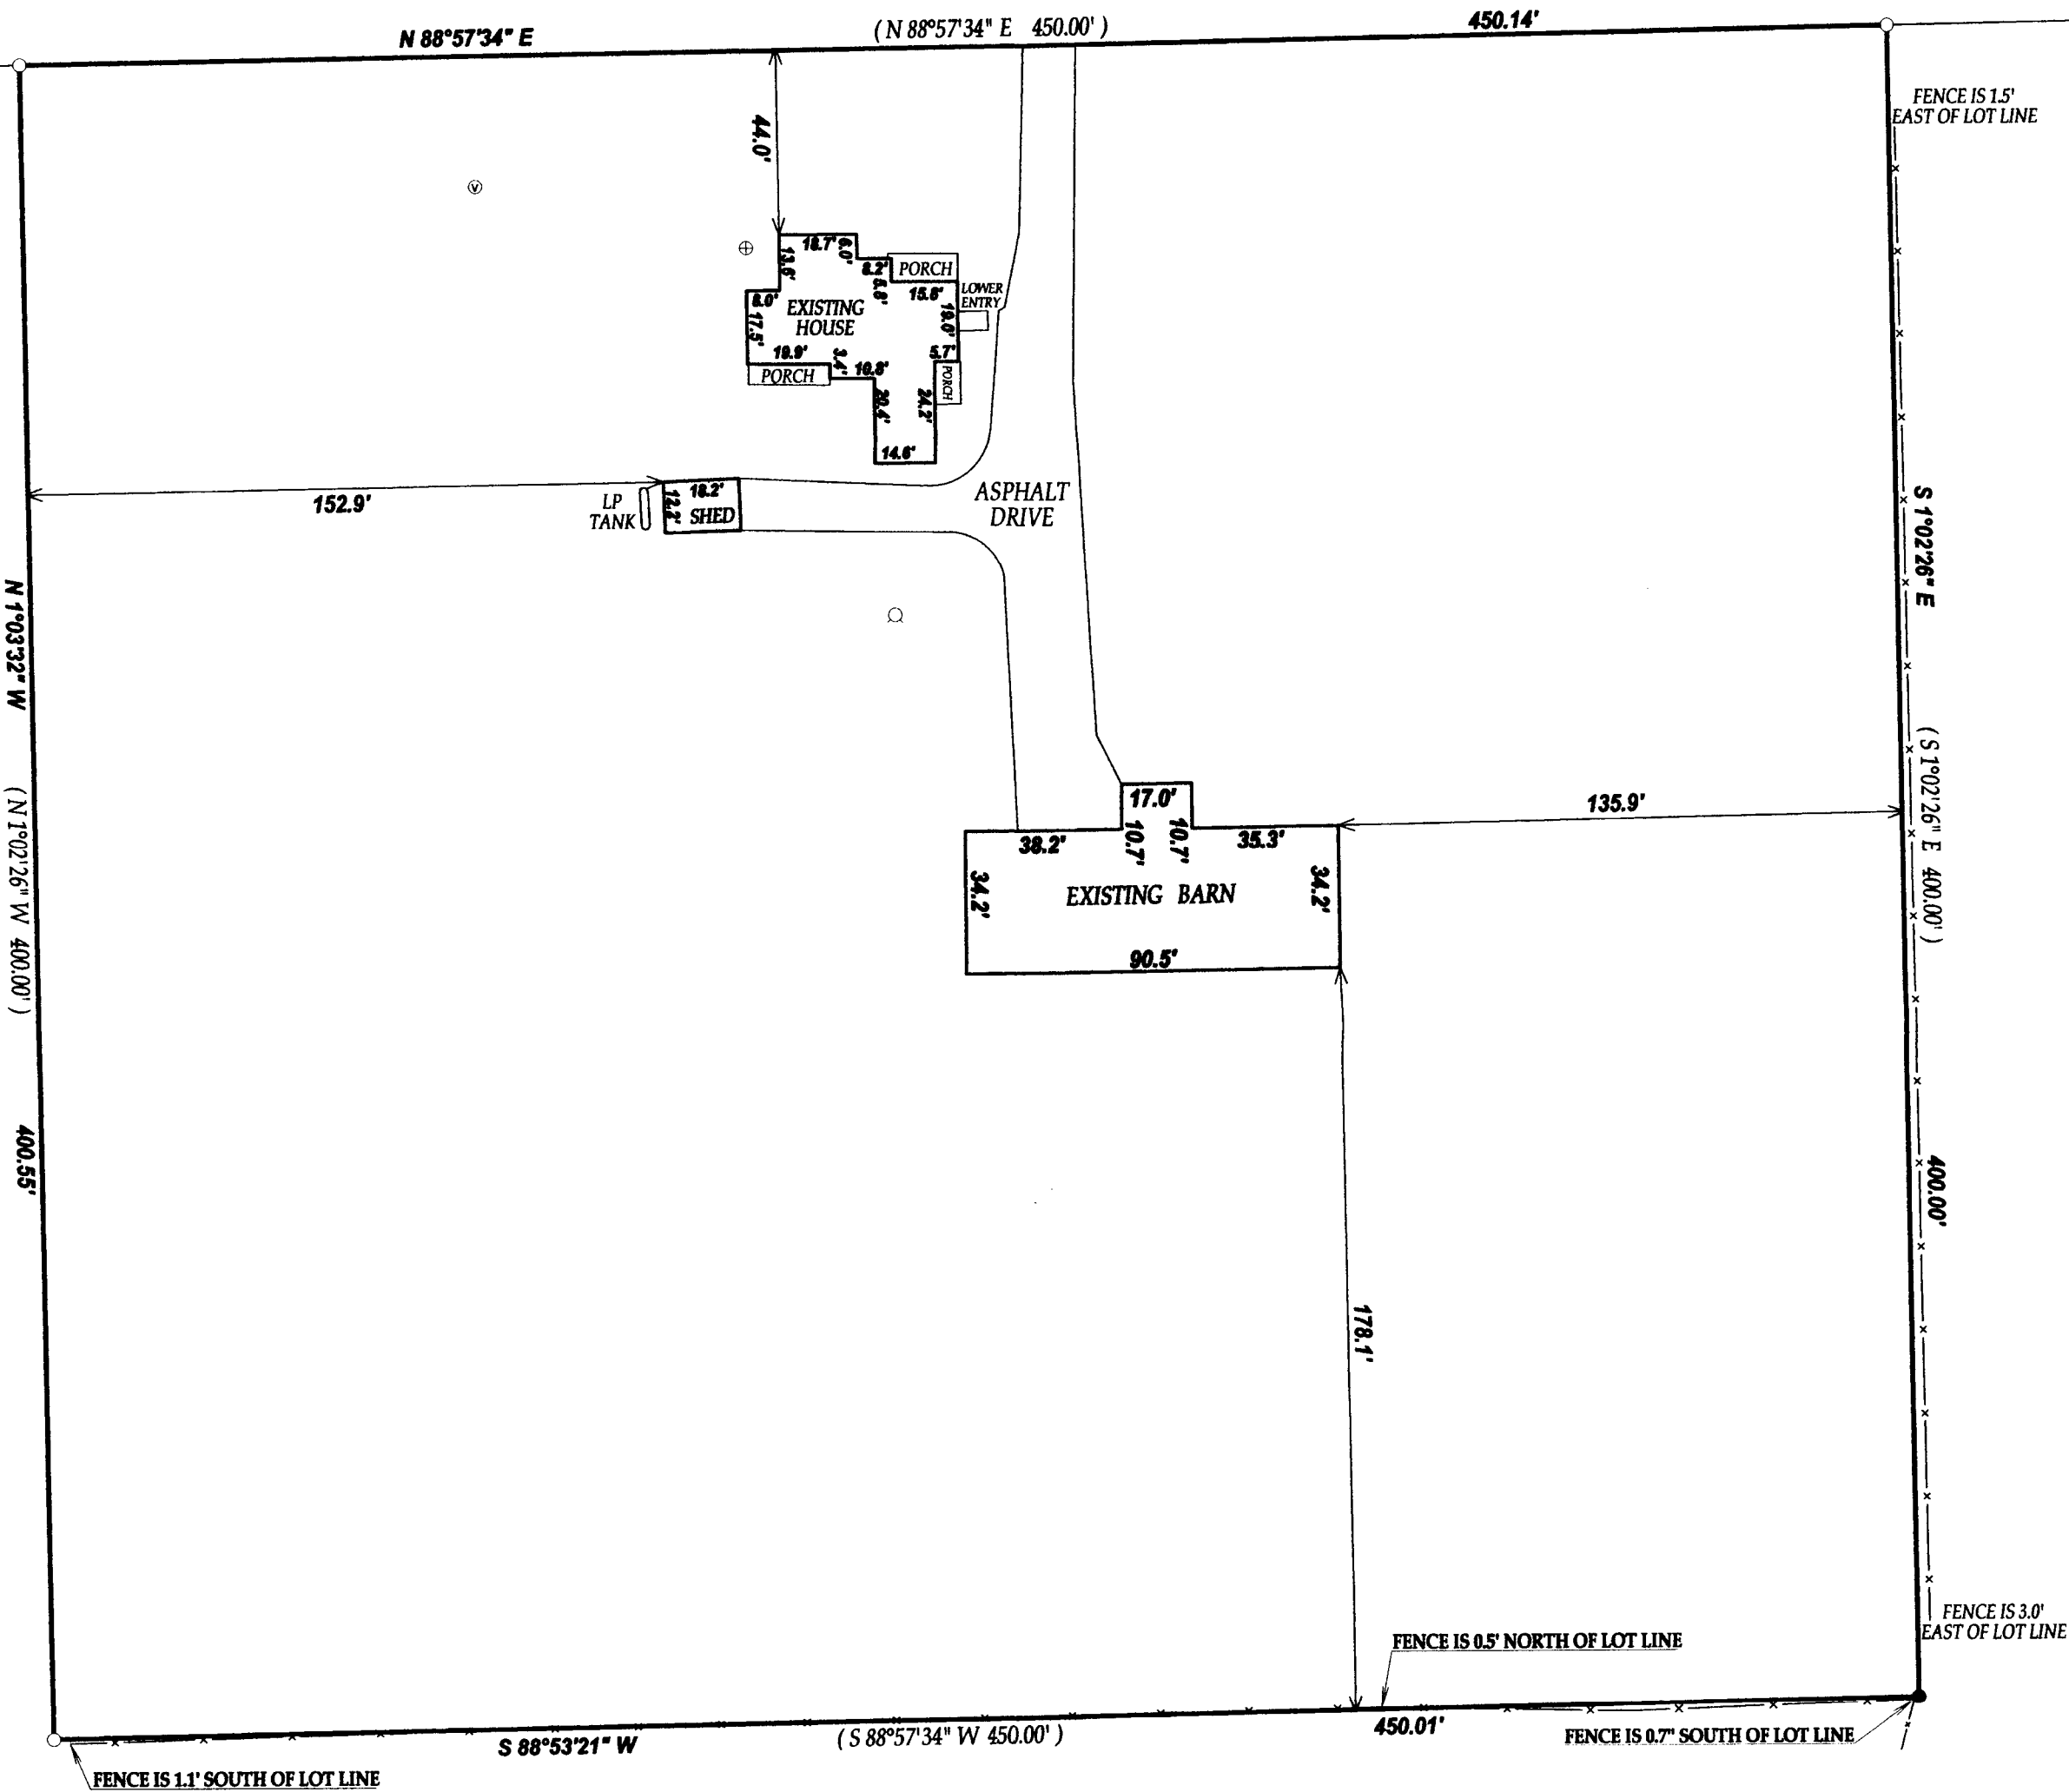

SCALE 1"=40'



NOTE : BEARINGS ARE REFERENCED TO C.S.M.# 2729



LEGEND

- FOUND IRON PIPE
- SET IRON PIPE
- ⊕ CONCRETE LID
- ⊙ VENT
- WELL

RECORDED AS
TAX ID # KA272900001
JOB # 11-149

I have surveyed the above-described property and the above map is a true representation thereof and shows the size and location of the property, its exterior boundaries, the location and dimensions of all structures thereon, fences apparent easements and roadways and visible encroachments, if any.

This survey is made for the exclusive use of the present owners of the property, and also those who purchase, mortgage, or insure the title thereto within one (1) year from date hereof; and as to them I warrant the accuracy of said survey map.

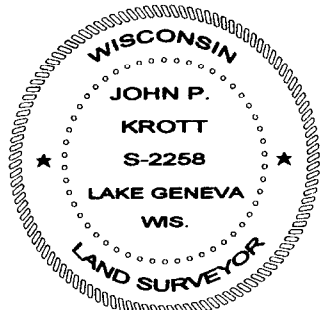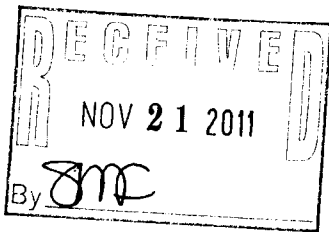

DATED THIS 7th DAY OF OCTOBER 2011.

JOHN KROTT S - 2258
Wisconsin Registered Land Surveyor
(original if signed in red)

317-940