




PREPARED FOR
JANE St. JOHN
COLDWELL BANKER HONIG-BELL
226 BROAD ST.
LAKE GENEVA, WI. 53147

PLAT OF SURVEY

PATHFINDER SURVEYING INC.
(formerly)
J.K. SURVEYING INC.
P.O BOX 322
LAKE GENEVA, WI. 53147
WWW.PATHFINDERSURVEYING.NET
262-248-8303

- OF -

LOT 22 OF EVERGREEN ESTATES, A SUBDIVISION LOCATED IN THE SW 1/4 OF THE NW 1/4, THE SW 1/4 OF THE SW 1/4 THE NW 1/4 OF THE SW 1/4 THE NE 1/4 OF THE NW 1/4 AND THE SE 1/4 OF THE SW 1/4 OF SECTION 18 AND THE SW 1/4 OF THE NW 1/4 THE NW 1/4 OF THE NW 1/4 THE NE 1/4 OF THE SE 1/4 OF THE NW 1/4 AND THE NW 1/4 OF THE NE 1/4 OF SECTION 19, TOWN 3 NORTH, RANGE 17 EAST, IN THE TOWN OF LA FAYETTE, WALWORTH COUNTY, WISCONSIN.

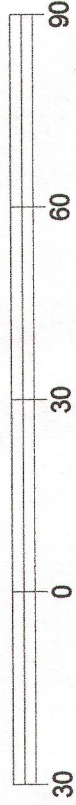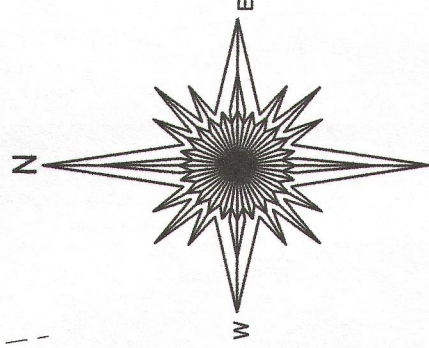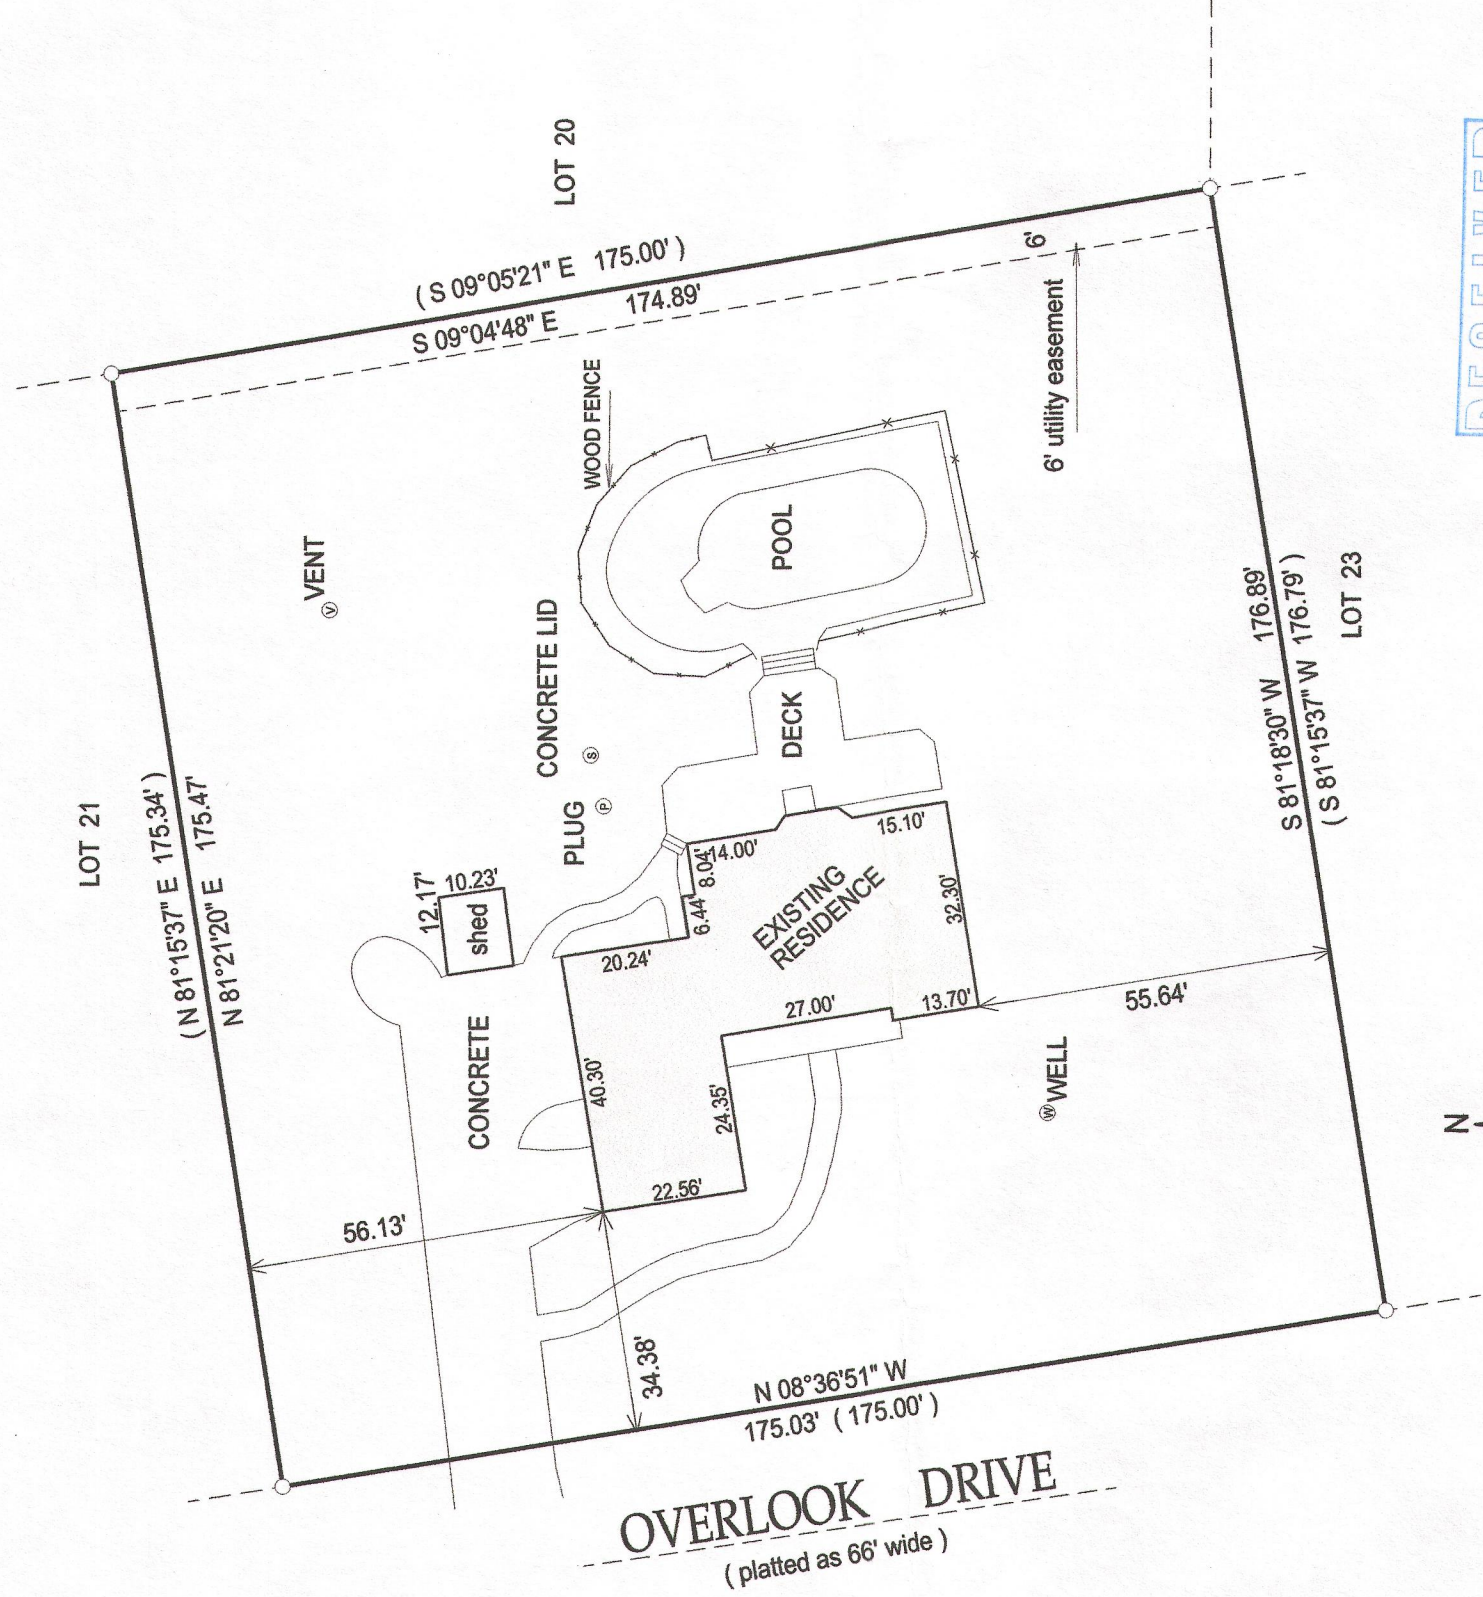

BASIS OF BEARING OF THIS PLAT: THE EAST LINE OF OVERLOOK DR.

WAS ASSUMED TO BEAR N8°36'51\" W 175.03' (175.00')

I hereby certify that I have surveyed the above-described property and the above map is a true representation thereof and shows the size and location of the property, its exterior boundaries, the location and dimensions of all structures thereon, fences, apparent easements and roadways and visible encroachments if any.

This survey is made for the present owners of the property, and those who purchase, mortgage, or guarantee the title thereto, within one year from the date hereof.

- () = recorded as
- = found iron bar
- = found iron pipe
- = set iron pipe
- = set iron bar

SCALE 1" = 30'

JOB # 13-103

TAX ID #

KE 00022



[Signature]

JEFFREY L. KIMPS S-2436
Wisconsin Registered Land Surveyor
(original if signed in red)

DATED THIS 8TH DAY OF JULY, 2013.

317-975