

LAND-MARK SURVEYING

Mark L. Miritz

Wisconsin Registered Land Surveyor S-2582



N9330 Knuteson Drive
Whitewater, WI 53190
Phone: (262)495-3284
FAX: (262)495-8421
LAND-MARKSURVEYING.COM

PLAT OF SURVEY

**LOT 1 OF CERTIFIED SURVEY MAP NO. 1639,
LOCATED IN THE NORTHWEST 1/4 OF THE
SOUTHEAST 1/4 AND THE NORTHEAST 1/4
OF THE SOUTHWEST 1/4 OF SECTION 4,
TOWN 3 NORTH, RANGE 17 EAST, LAFAYETTE
TOWNSHIP, WALWORTH COUNTY, WISCONSIN.**

**ORDERED BY: CONNIE POGGENSEE
THE RAULAND AGENCY
118 KENOSHA STREET
WALWORTH, WI 53184**

SITE ADDRESS: W3886 SCOTCH HEATHER LANE, ELKHORN, WI 53121

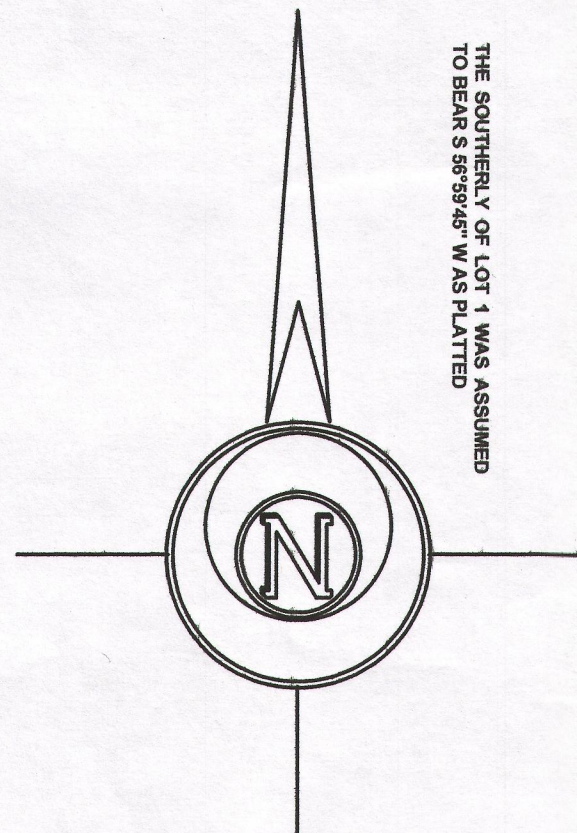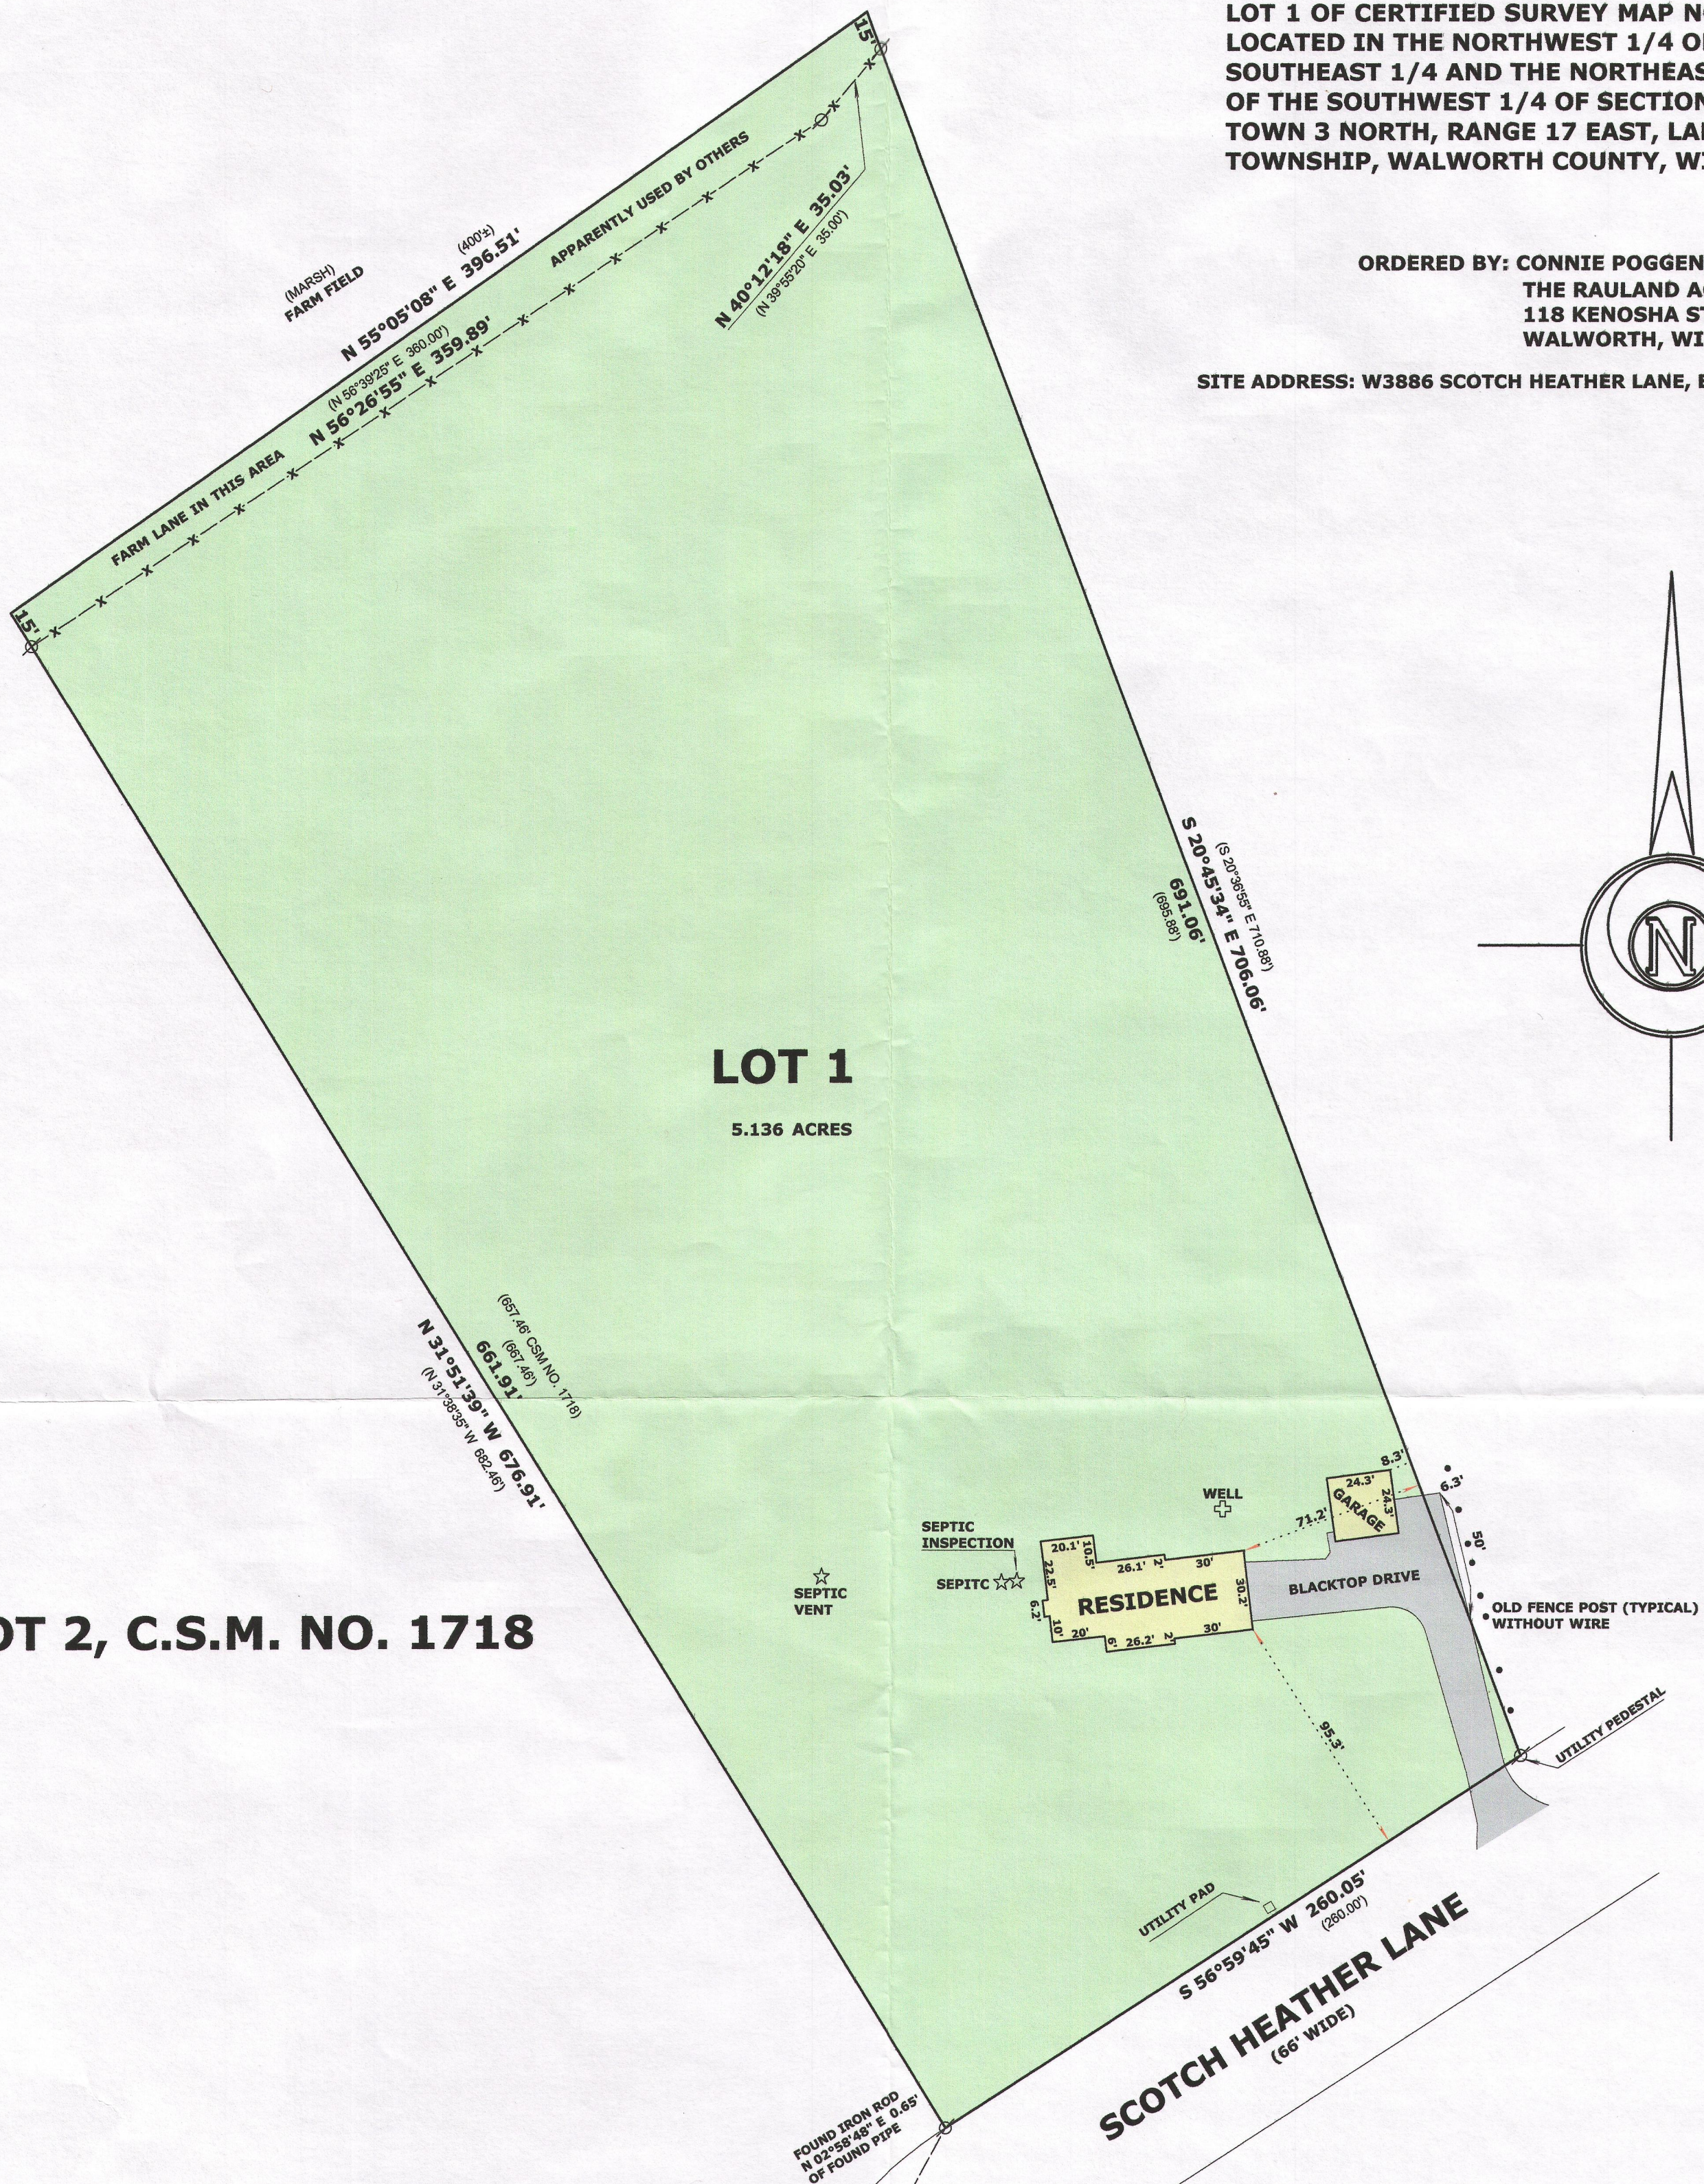


LEGEND

- ⊘ FOUND IRON PIPE
- (x x) RECORDED AS DIMENSION
- X-X- EXISTING FENCE

SCALE: 1 INCH = 50 FEET

"I hereby certify that the above described property has been surveyed by me or under my direction and that the above map is a true representation thereof and shows the size and location of the property, its exterior boundaries, the location of all visible structures and dimensions of all principal buildings thereon, boundary fences, apparent easements, roadways and visible encroachments, if any."
"This survey is made for the use of the present owners of the property, and also those who purchase, mortgage, or guarantee the title thereto within one year from date hereof."

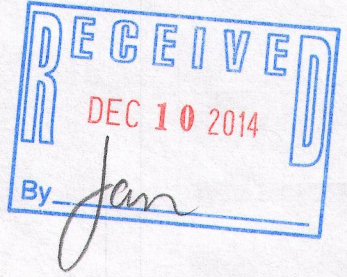

Mark L. Miritz
MARK L. MIRITZ
WISCONSIN REGISTERED
LAND SURVEYOR S-2582

REVISED OCT. 11, 2014 TO SHOW OLD FENCE POST

DATE: **AUGUST 19, 2014** JOB NO. **14.801**