TYLER MEYER SHOREWEST REALTY DELAVAN, WI

PLAT OF SURVEY

- OF -

PATHFINDER SURVEYING INC.

(formerly)


J.K. SURVEYING INC.

P.O BOX 322

LAKE GENEVA, WI. 53147

WWW.PATHFINDERSURVEYING.NET
262-248-8303

UNIT 17, PHASE 2 ROLLING GREEN ESTATES CONDOMINIUM, A CONDOMINIUM LOCATED IN THE SOUTHEAST 1/4 AND THE SOUTHWEST 1/4 OF SECTION 18, TOWN 3 NORTH, RANGE 17 EAST, TOWN OF LA FAYETTE, WALWORTH COUNTY, WISCONSIN

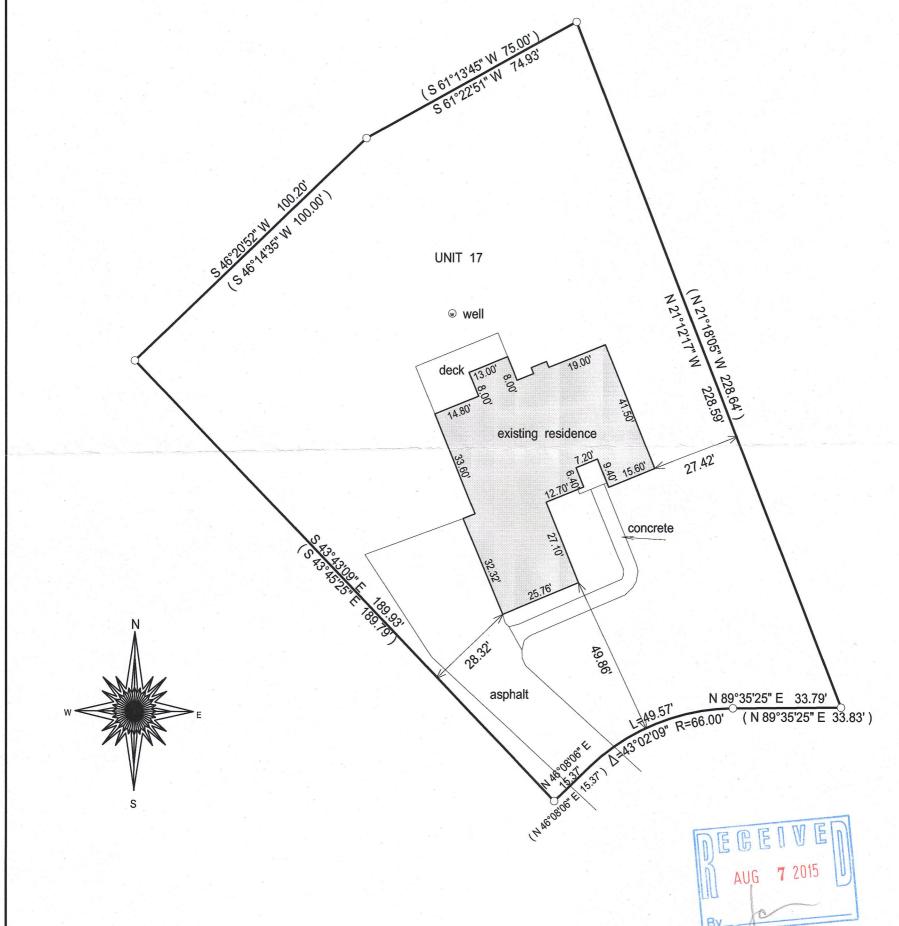

()= recorded as

= found iron bar

= found iron pipe


= set iron pipe

= set iron bar

SCALE 1" = 30'

JOB # 15-125a

TAX ID # KRG00017

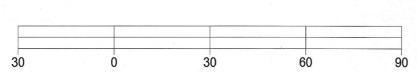

BASIS OF BEARING OF THIS PLAT: THE CONDOMINIUM PLAT OF RECORD.

I hereby certify that I have surveyed the above- described property and the above map is a is a true representation thereof and shows the size and location of the property, its exterior boundaries, the location and dimensions of all structures thereon, fences, apparant easements and roadways and visible encroachments if any.

This survey is made for the present owners of the property, and those who purchase, mortgage, or guarantee the title thereto, within one year from the date hereof.

DATED THIS 5th day of May, 2015.



JEFFREY L KIMPS S - 2436 Wisconsin Registered Land Surveyor (original if signed in red)